



PLAN	DATE	BY	DATE
SURVEYED	10-12-64	JGB	10-12-64
PLOTTED		G.E.R.	
NOTE BOOK			
NO.			

PROFILE	DATE	BY	DATE
SURVEYED	10-12-64	JGB	10-12-64
PLOTTED		G.E.R.	
NOTE BOOK			
NO.			

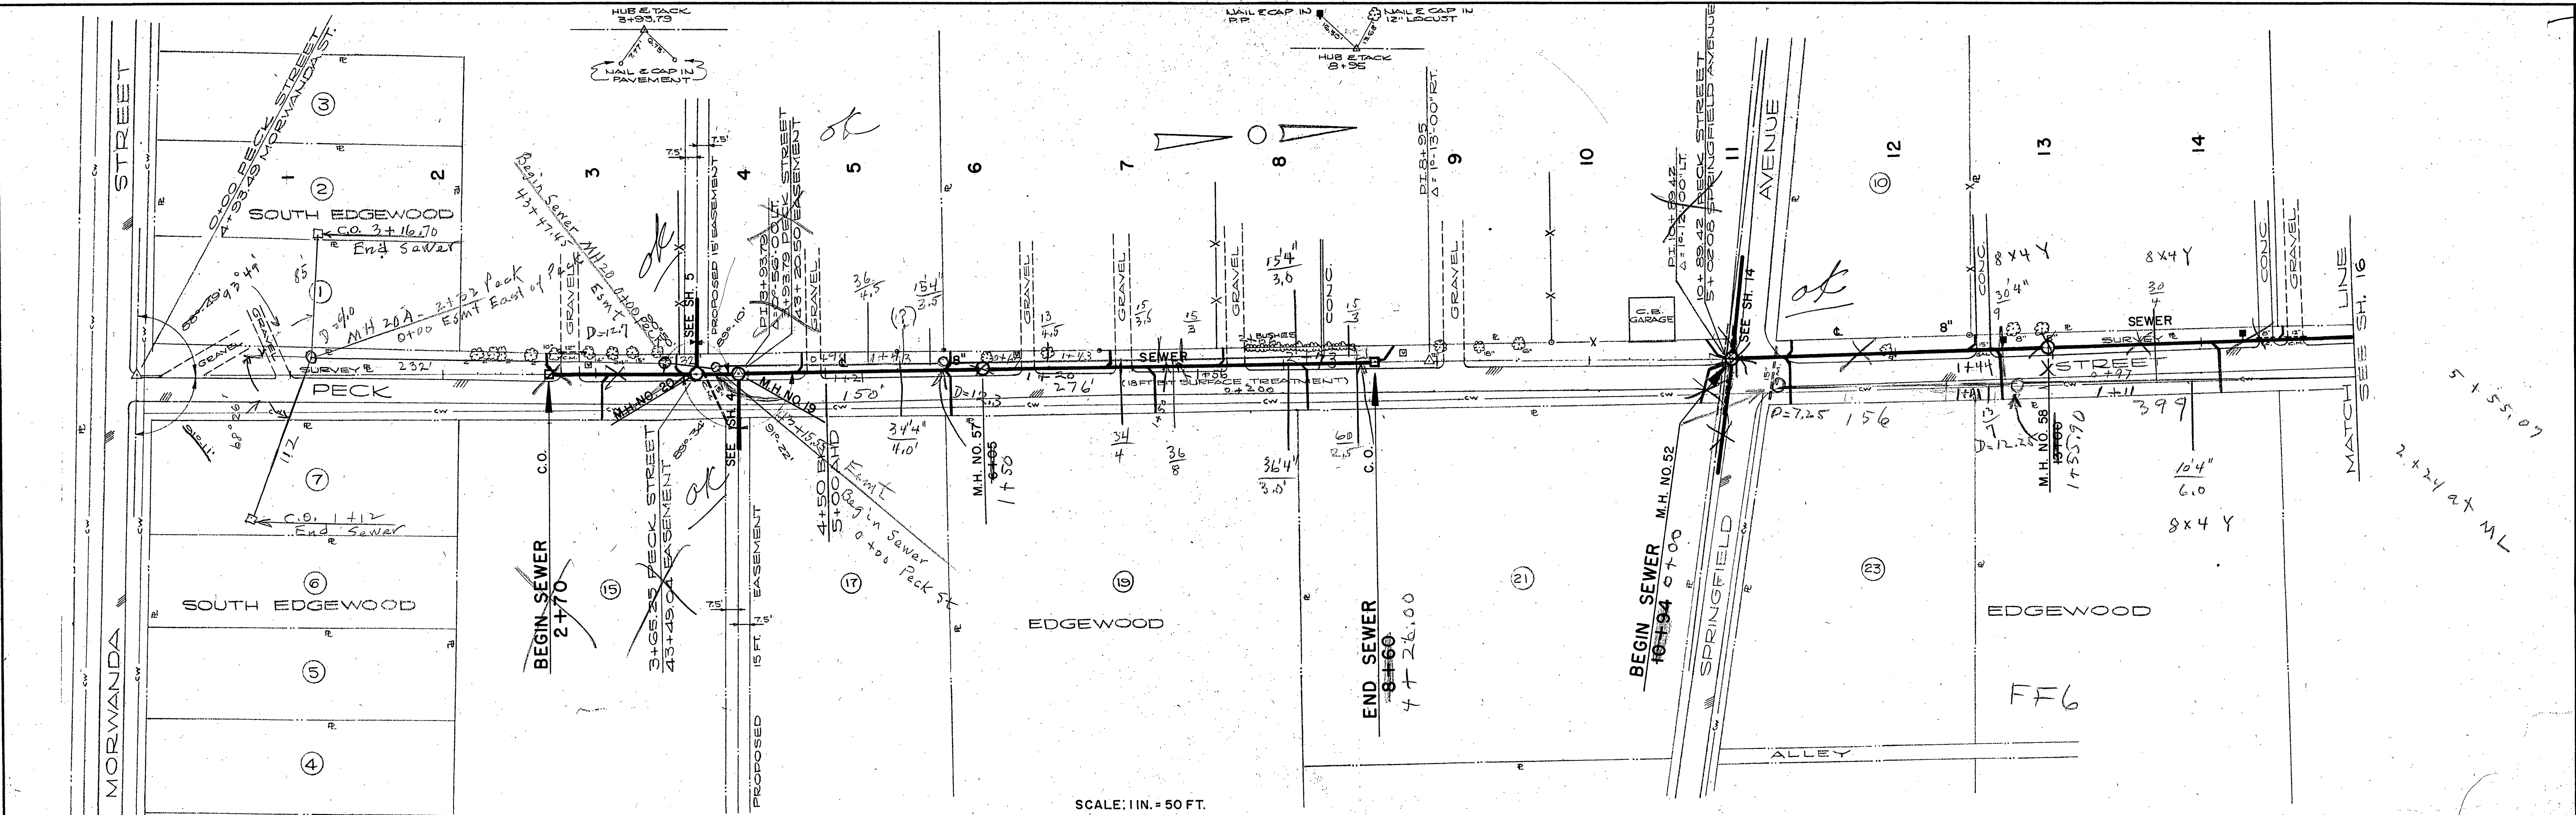

SCALE: 1 IN. = 50 FT.

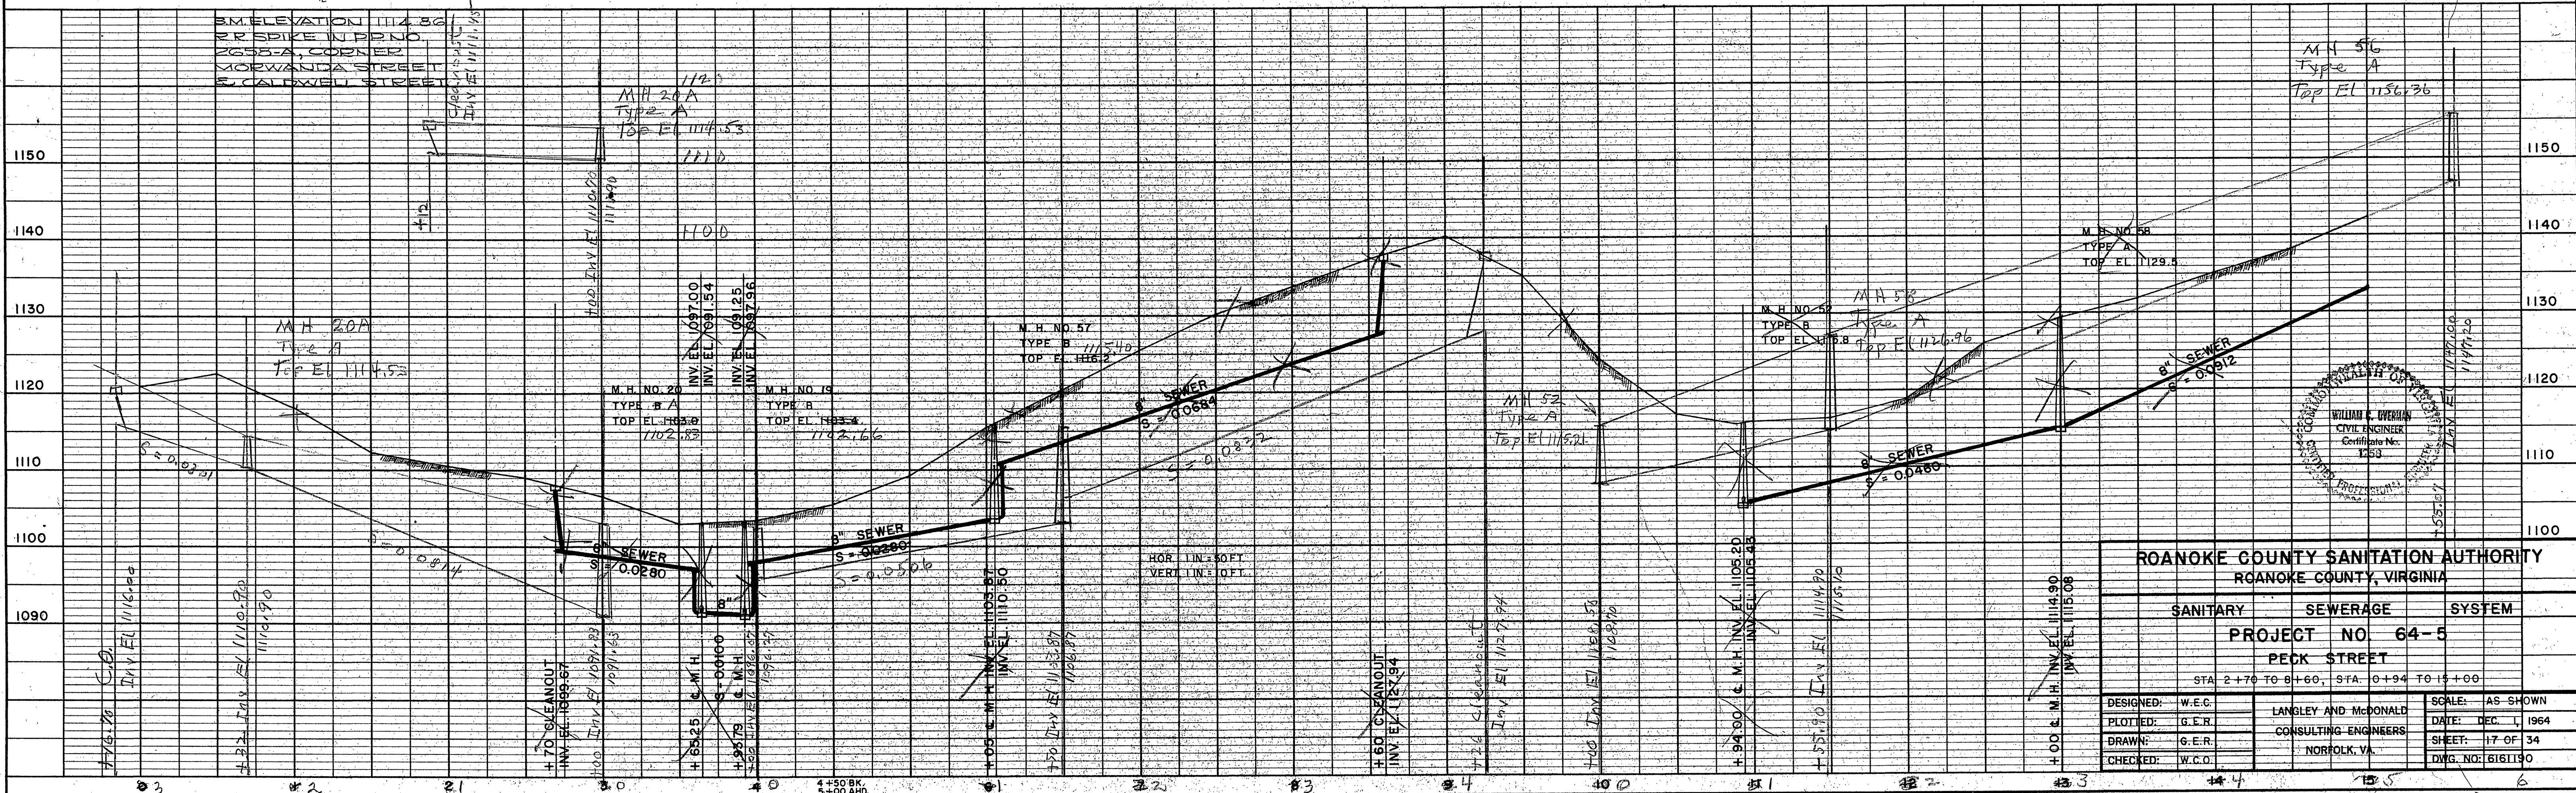

ROANOKE COUNTY SANITATION AUTHORITY ROANOKE COUNTY, VIRGINIA		
SANITARY	SEWERAGE	SYSTEM
PROJECT NO 64-5		
PECK STREET		
STA 2+70 TO 8+60, STA 0+94 TO 15+00		
DESIGNED:	W.E.C.	SCALE: AS SHOWN
PLOTTED:	G.E.R.	DATE: DEC. 1, 1964
DRAWN:	G.E.R.	SHEET: 17 OF 34
CHECKED:	W.C.O.	DWG. NO: 6161130