

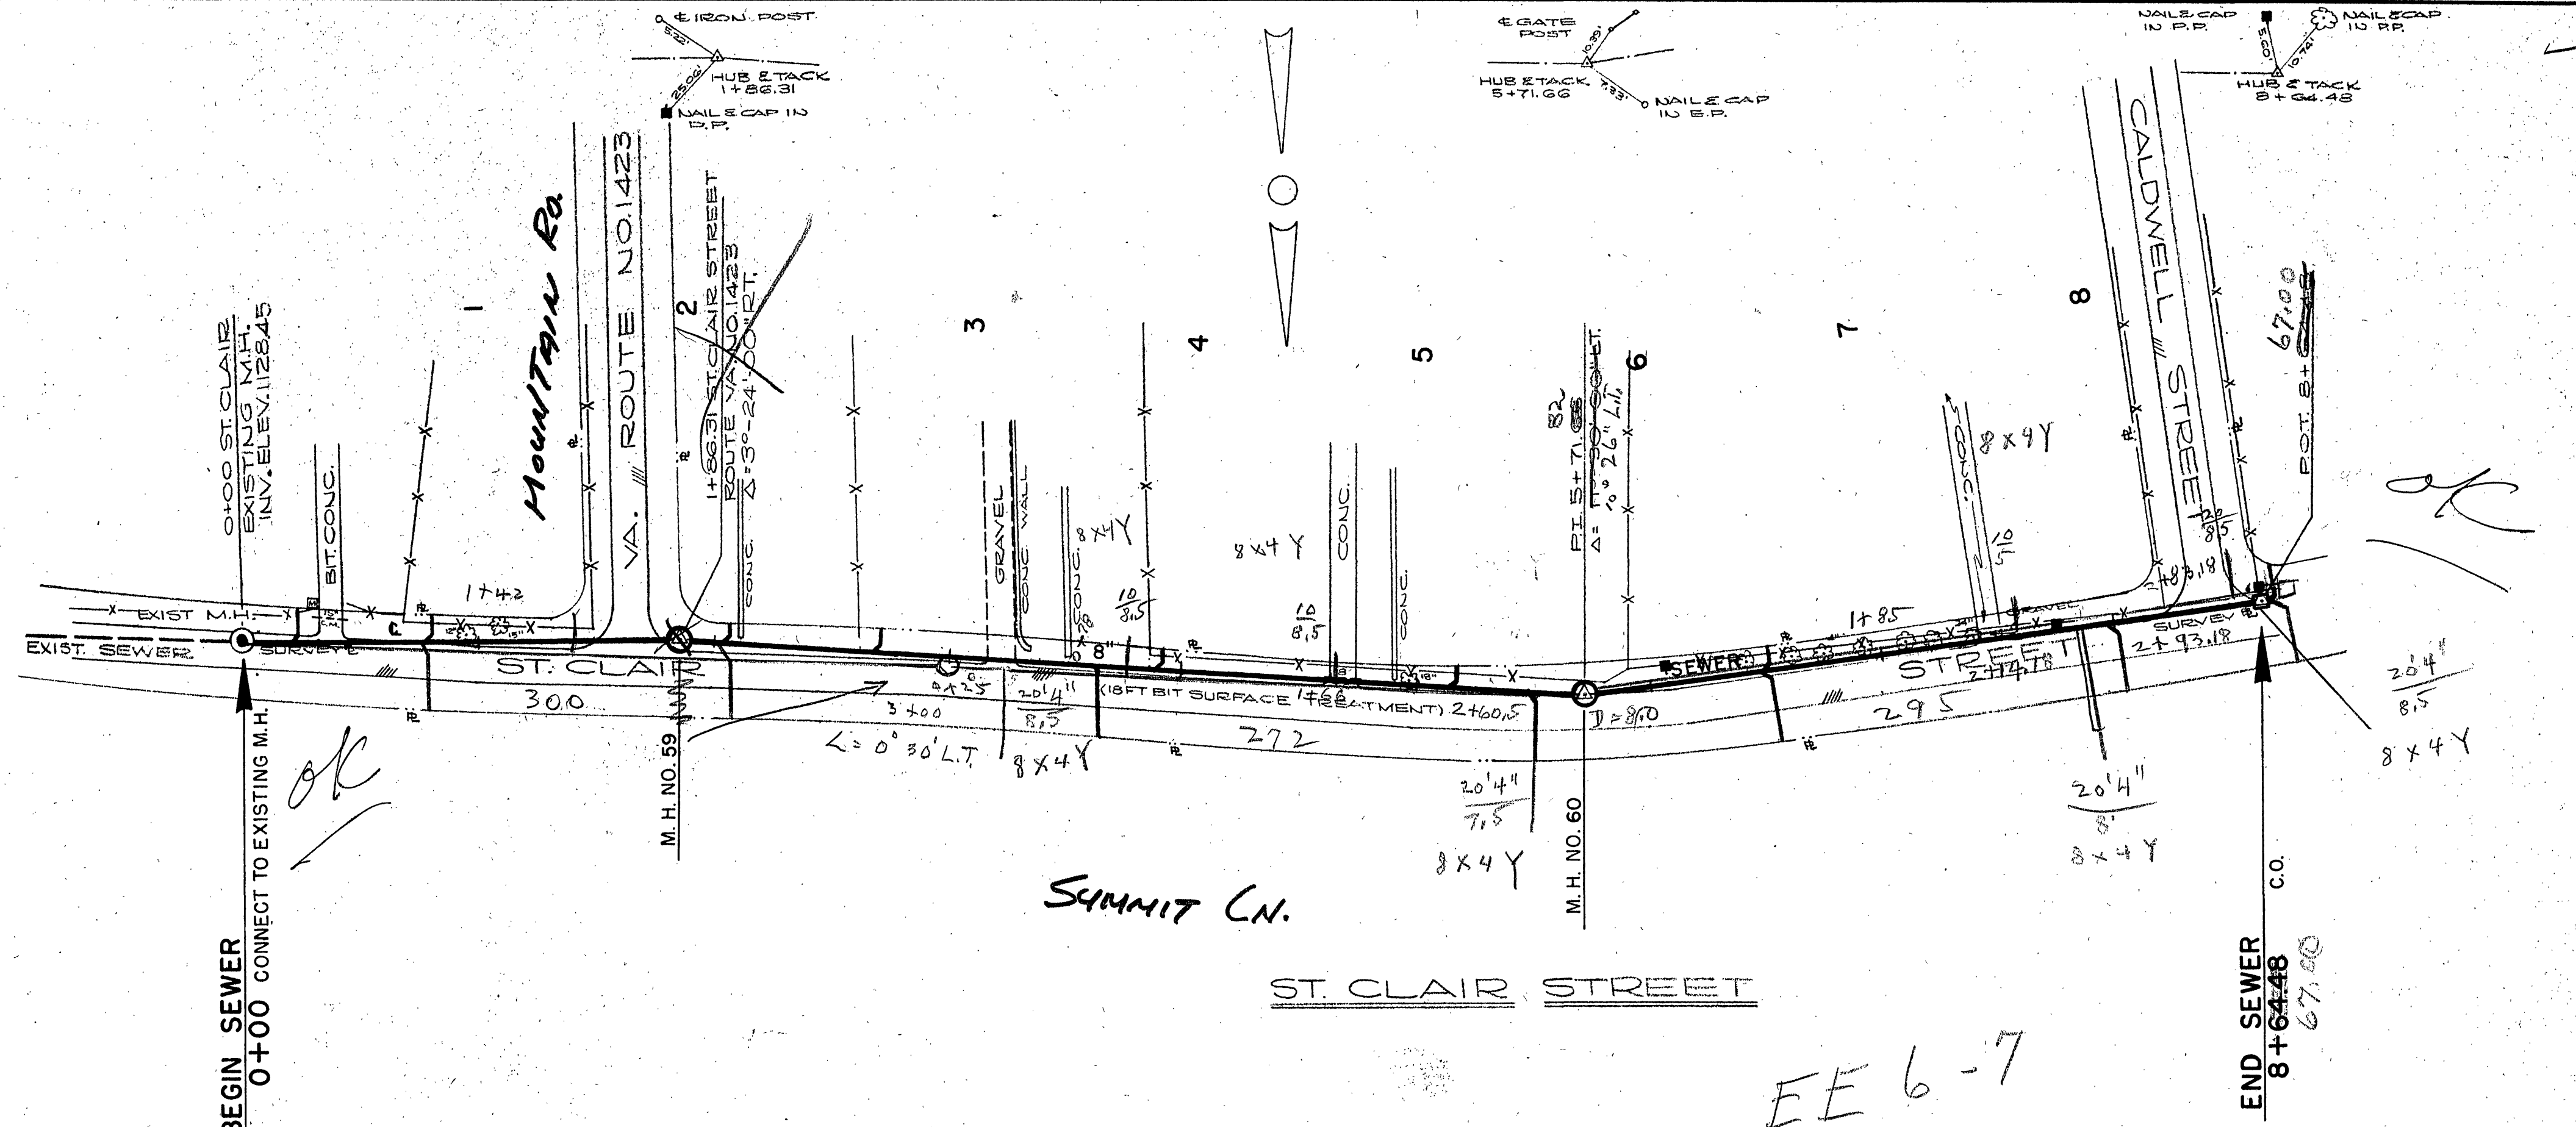


PLAN	DATE
BY J.C.B.	12/1/64
NOTED	
NO.	
NOTE BOOK	
ALIGNMENT CHECKED	
RT. OF WAY CHECKED	

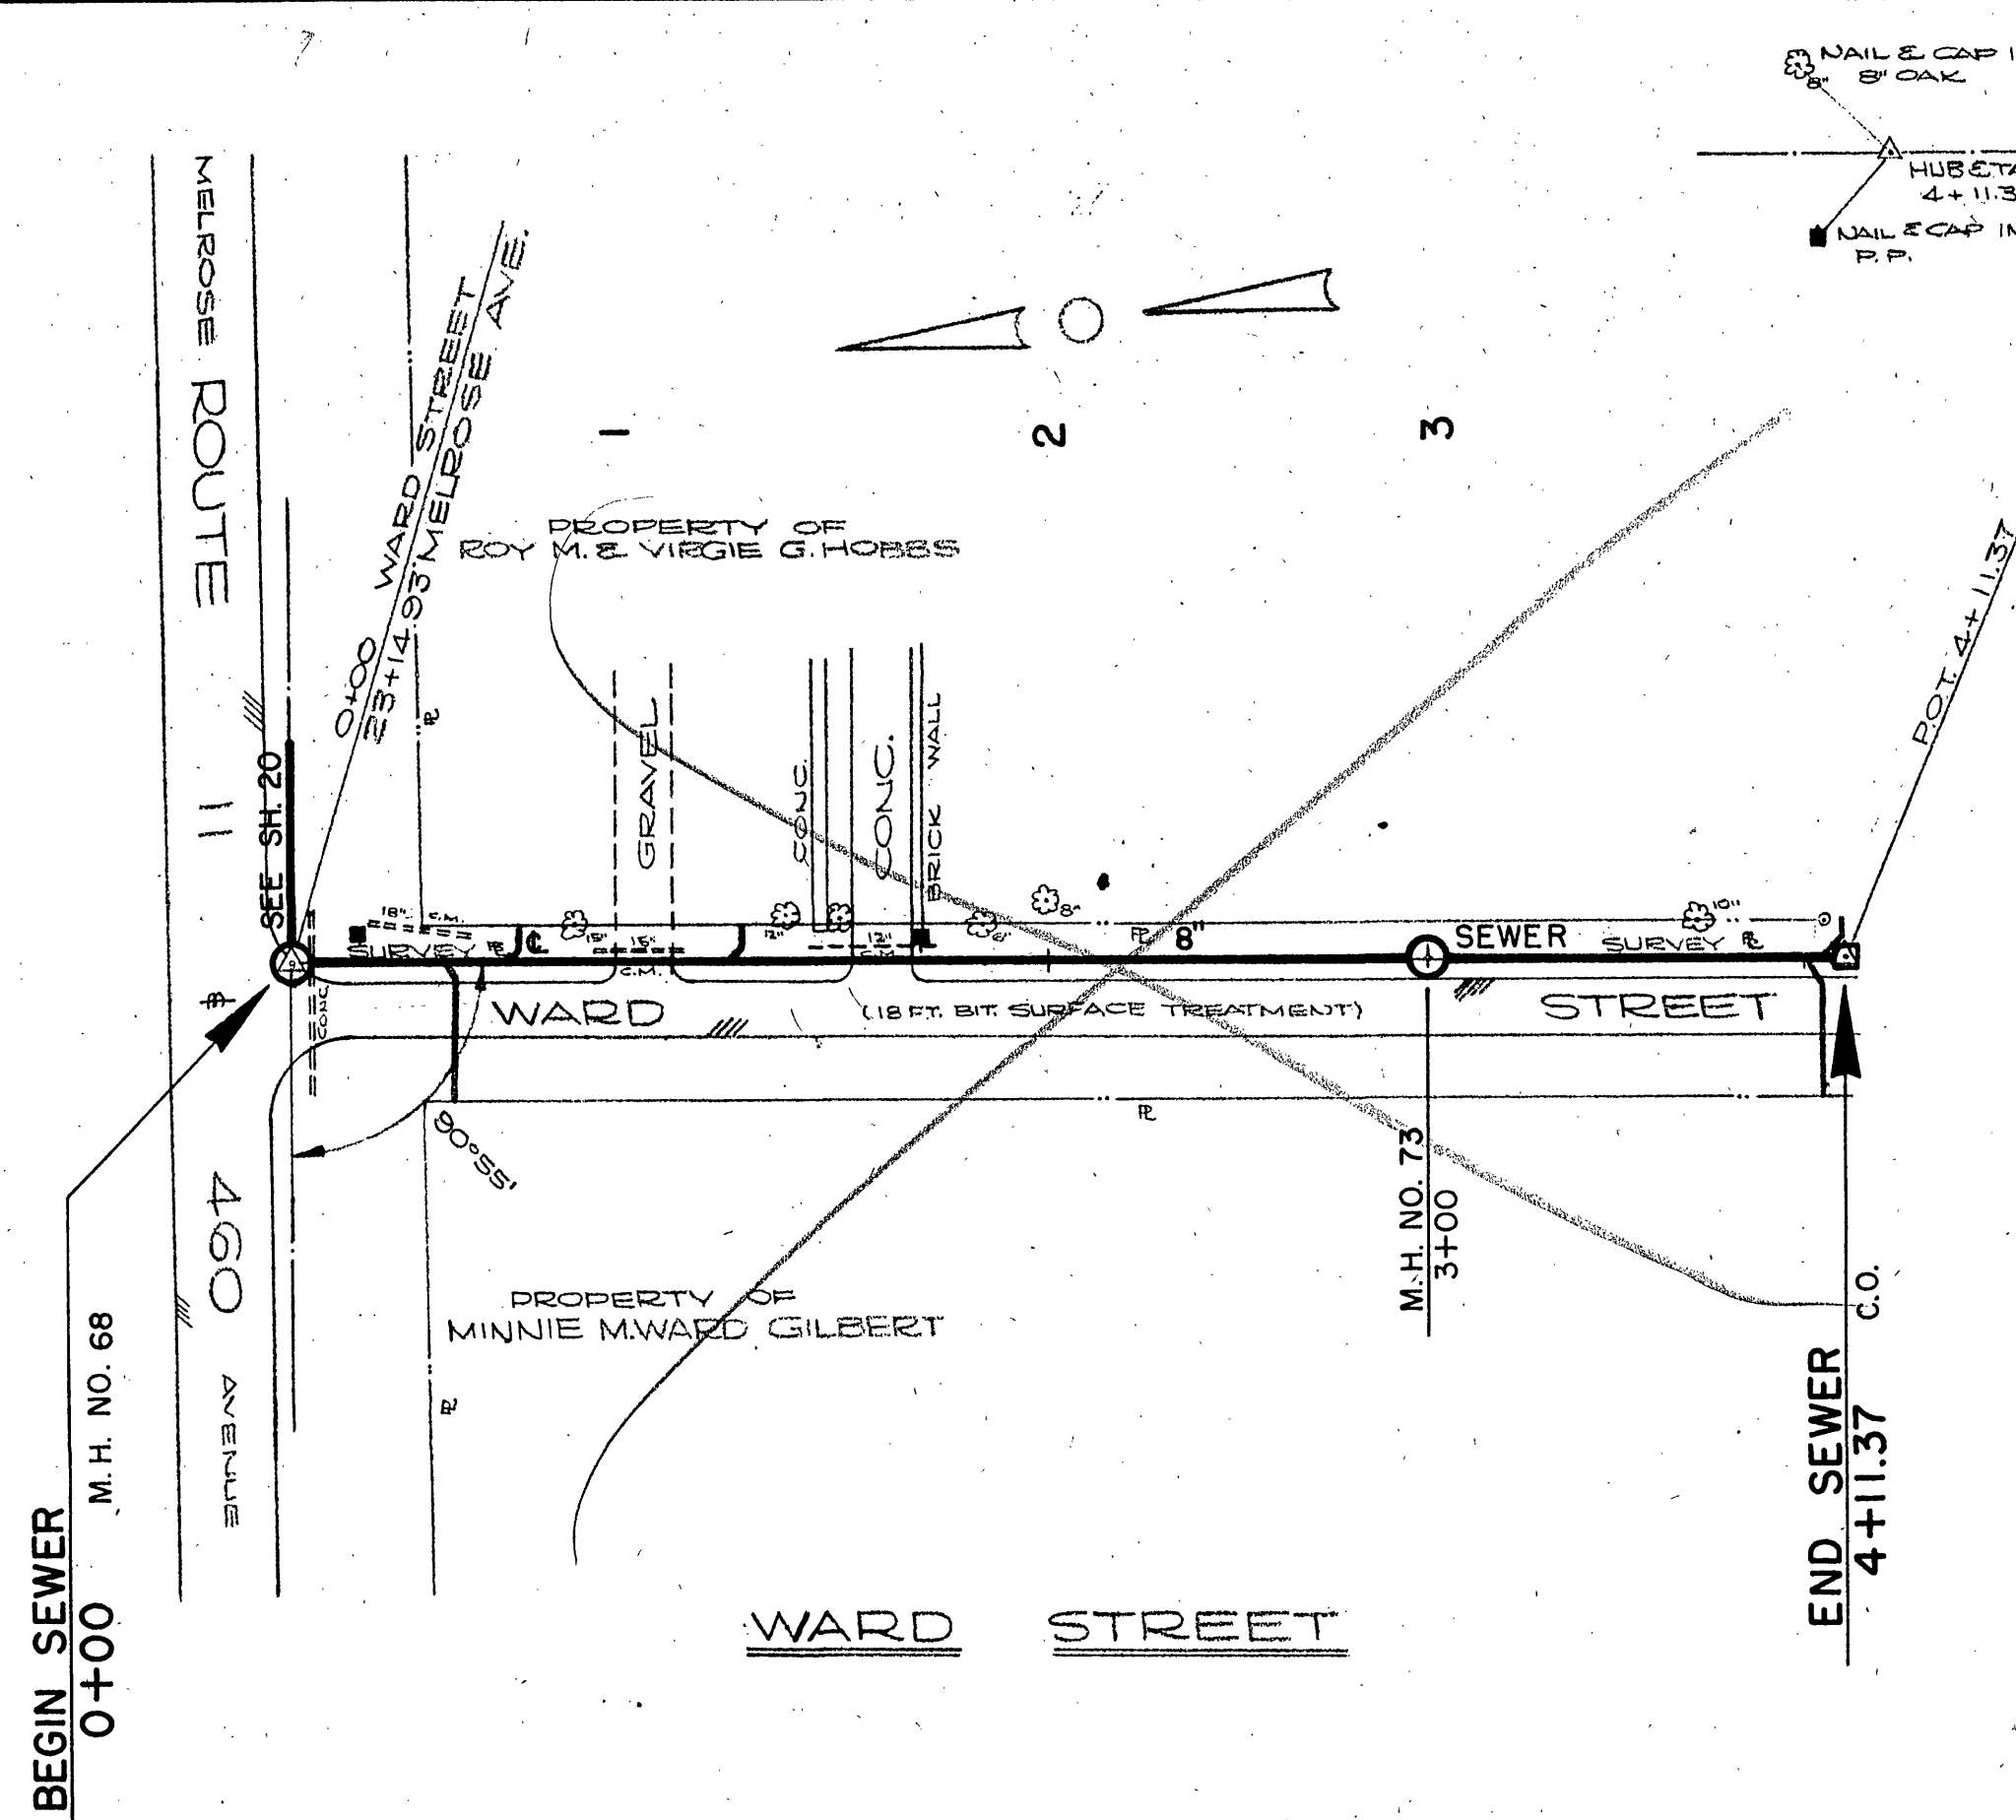

SCALE: 1 IN. = 50 FT.

PROFILE	DATE
BY J.C.B.	12/1/64
NOTED	
NO.	
NOTE BOOK	
GRADES CHECKED	
B. M. NOTED	
STRUCTURE NOTING CHVD.	

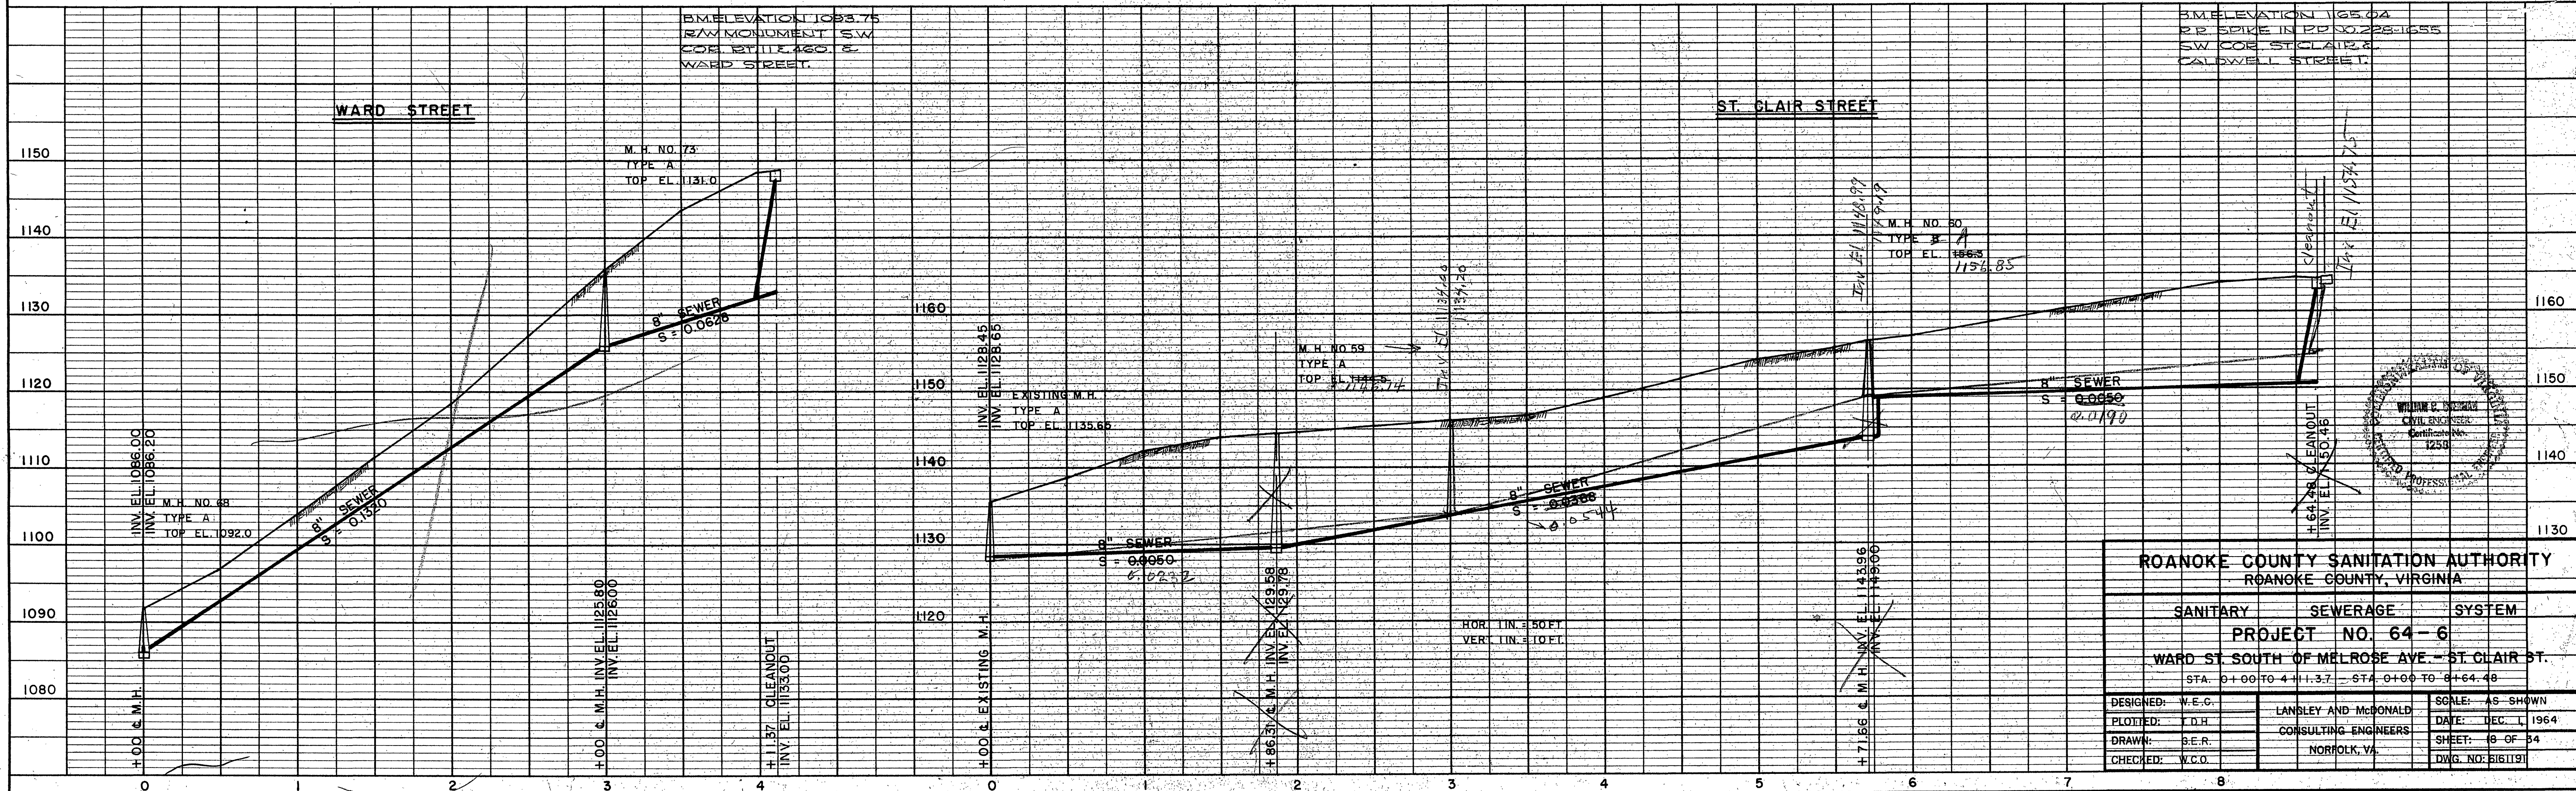

ROANOKE COUNTY SANITATION AUTHORITY ROANOKE COUNTY, VIRGINIA		
SANITARY	SEWERAGE	SYSTEM
PROJECT NO. 64-6		
WARD ST. SOUTH OF MELROSE AVE. - ST. CLAIR ST.		
STA. 0+00 TO 4+11.37 - STA. 0+00 TO 8+64.48		
DESIGNED: W.E.C.	LANSLEY AND McDONALD	SCALE: AS SHOWN
PLOTTED: D.H.	CONSULTING ENGINEERS	DATE: DEC. 1, 1964
DRAWN: G.E.R.	NORFOLK, VA.	SHEET: 16 OF 34
CHECKED: V.C.O.		DWG. NO. 5161191