



PLAN	DATE	BY
NO.	1/17/64	J.G.B.
NOTE BOOK	1/17/64	J.G.B.
SURVEYED	1/17/64	J.G.B.
PLOTTED	1/17/64	J.G.B.
GRADES CHECKED	1/17/64	J.G.B.
STRUCTURE NOTATIONS	1/17/64	J.G.B.

PROFILE	DATE	BY
NO.	1/17/64	J.G.B.
NOTE BOOK	1/17/64	J.G.B.
SURVEYED	1/17/64	J.G.B.
PLOTTED	1/17/64	J.G.B.
GRADES CHECKED	1/17/64	J.G.B.
STRUCTURE NOTATIONS	1/17/64	J.G.B.

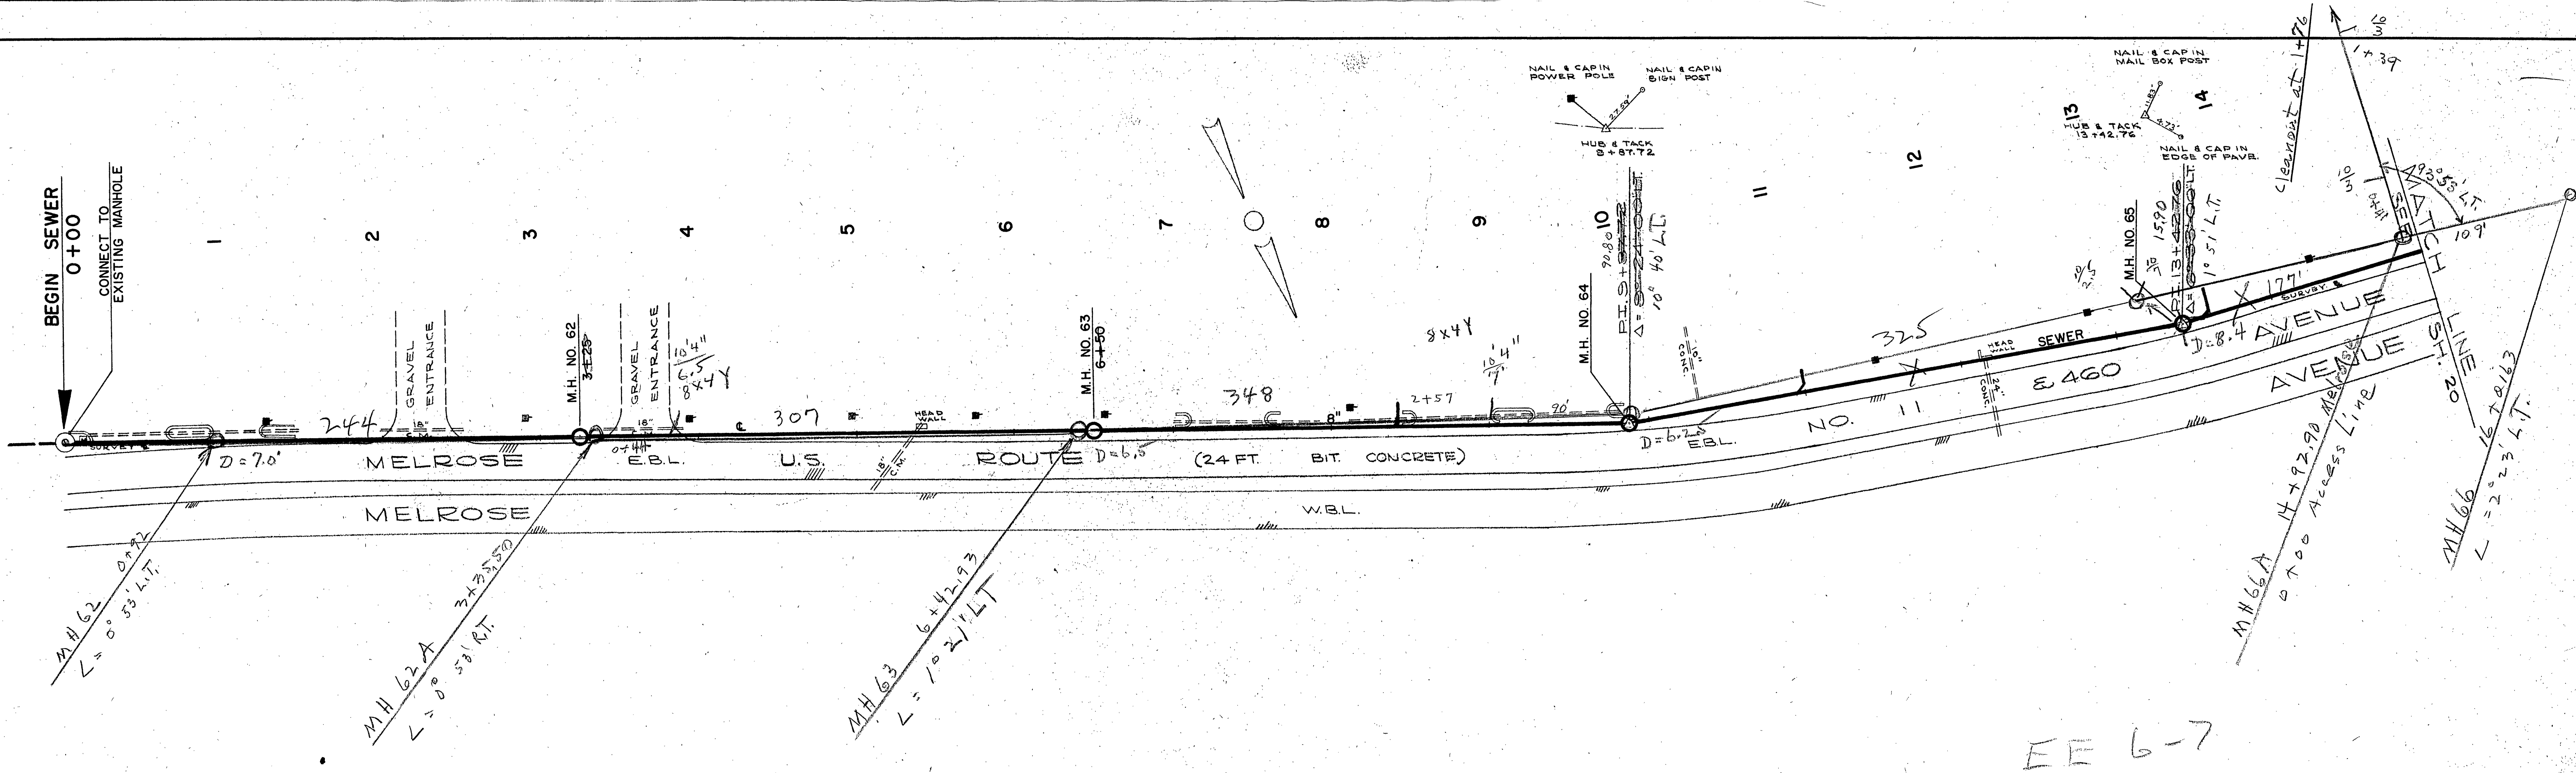

SCALE: 1 IN. = 50 FT.

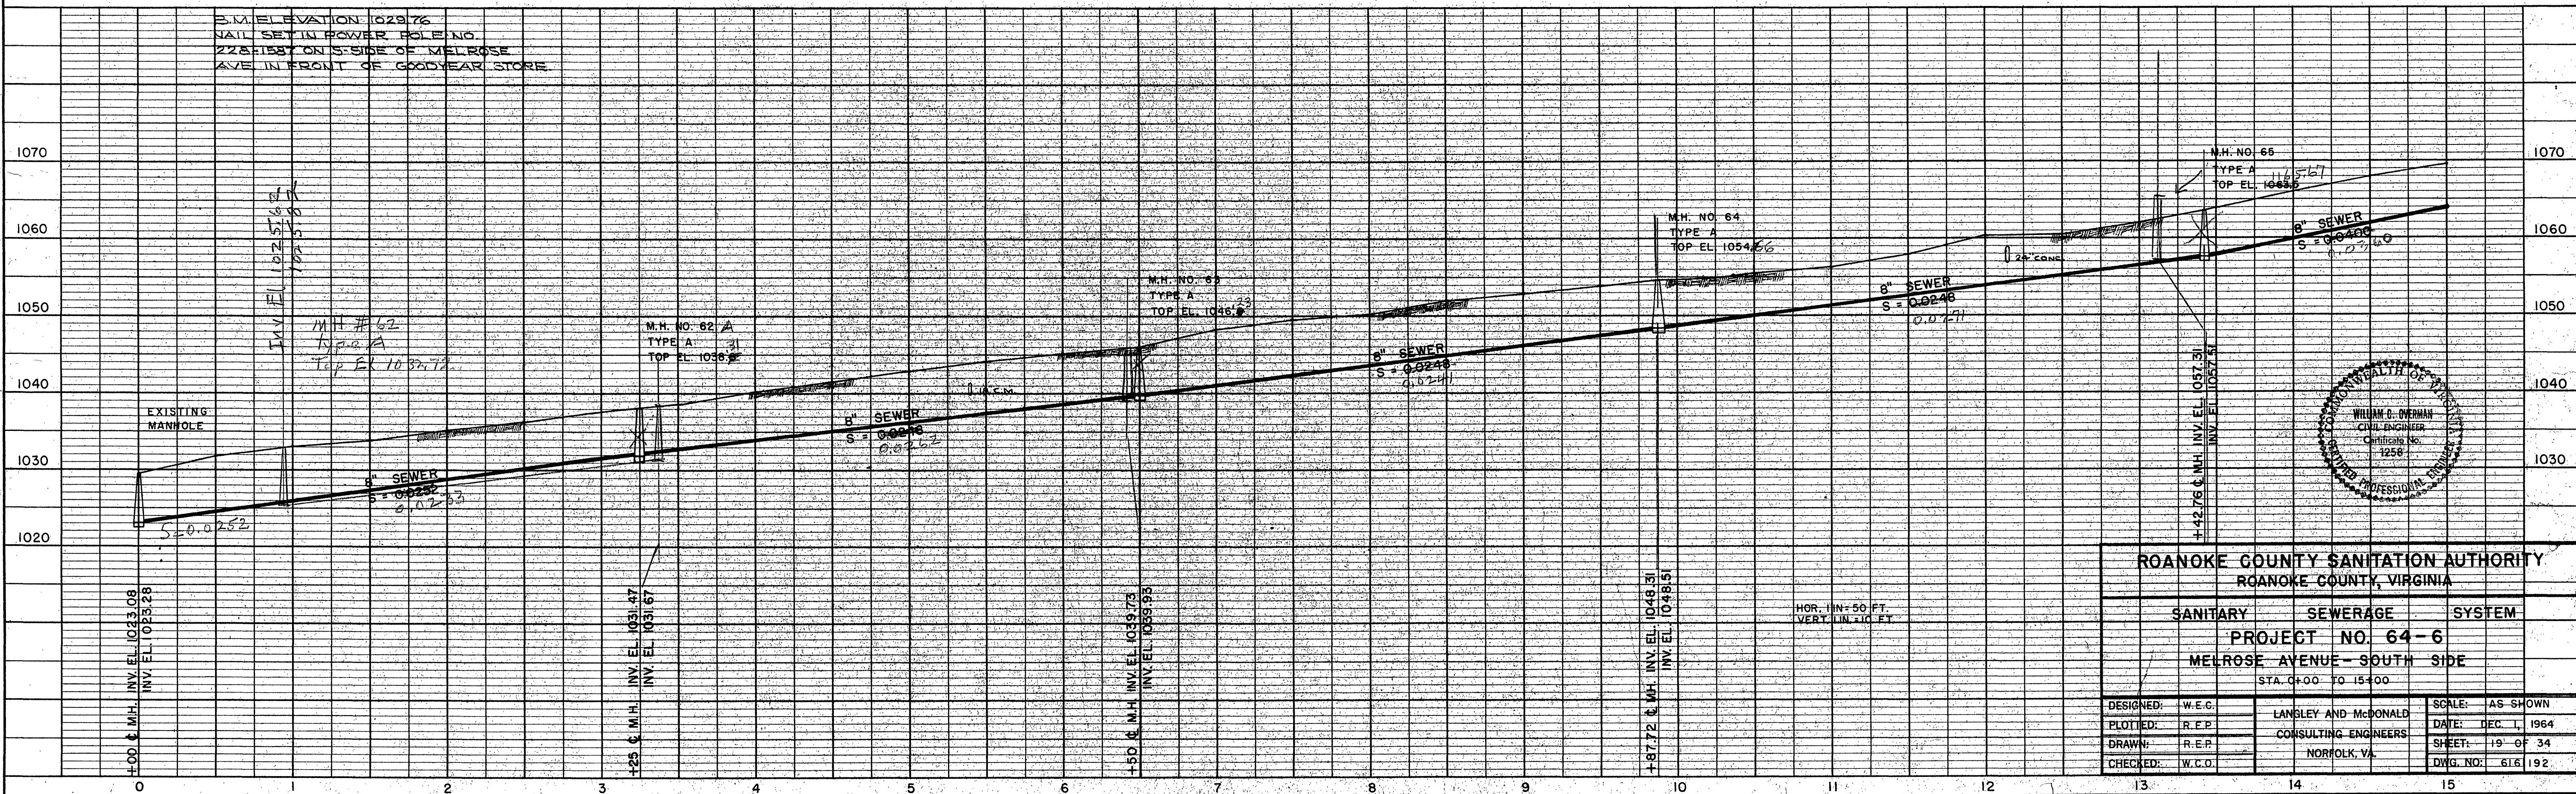

ROANOKE COUNTY SANITATION AUTHORITY ROANOKE COUNTY, VIRGINIA		
SANITARY	SEWERAGE	SYSTEM
PROJECT NO. 64-6 MELROSE AVENUE - SOUTH SIDE STA 0+00 TO 15+00		
DESIGNED: W.E.C.	LANGLEY AND McDONALD	SCALE: AS SHOWN
PLOTTED: R.E.P.	CONSULTING ENGINEERS	DATE: DEC. 1, 1964
DRAWN: R.E.P.	NORFOLK, VA.	SHEET: 19 OF 34
CHECKED: W.C.D.		DRG. NO: 616 192