
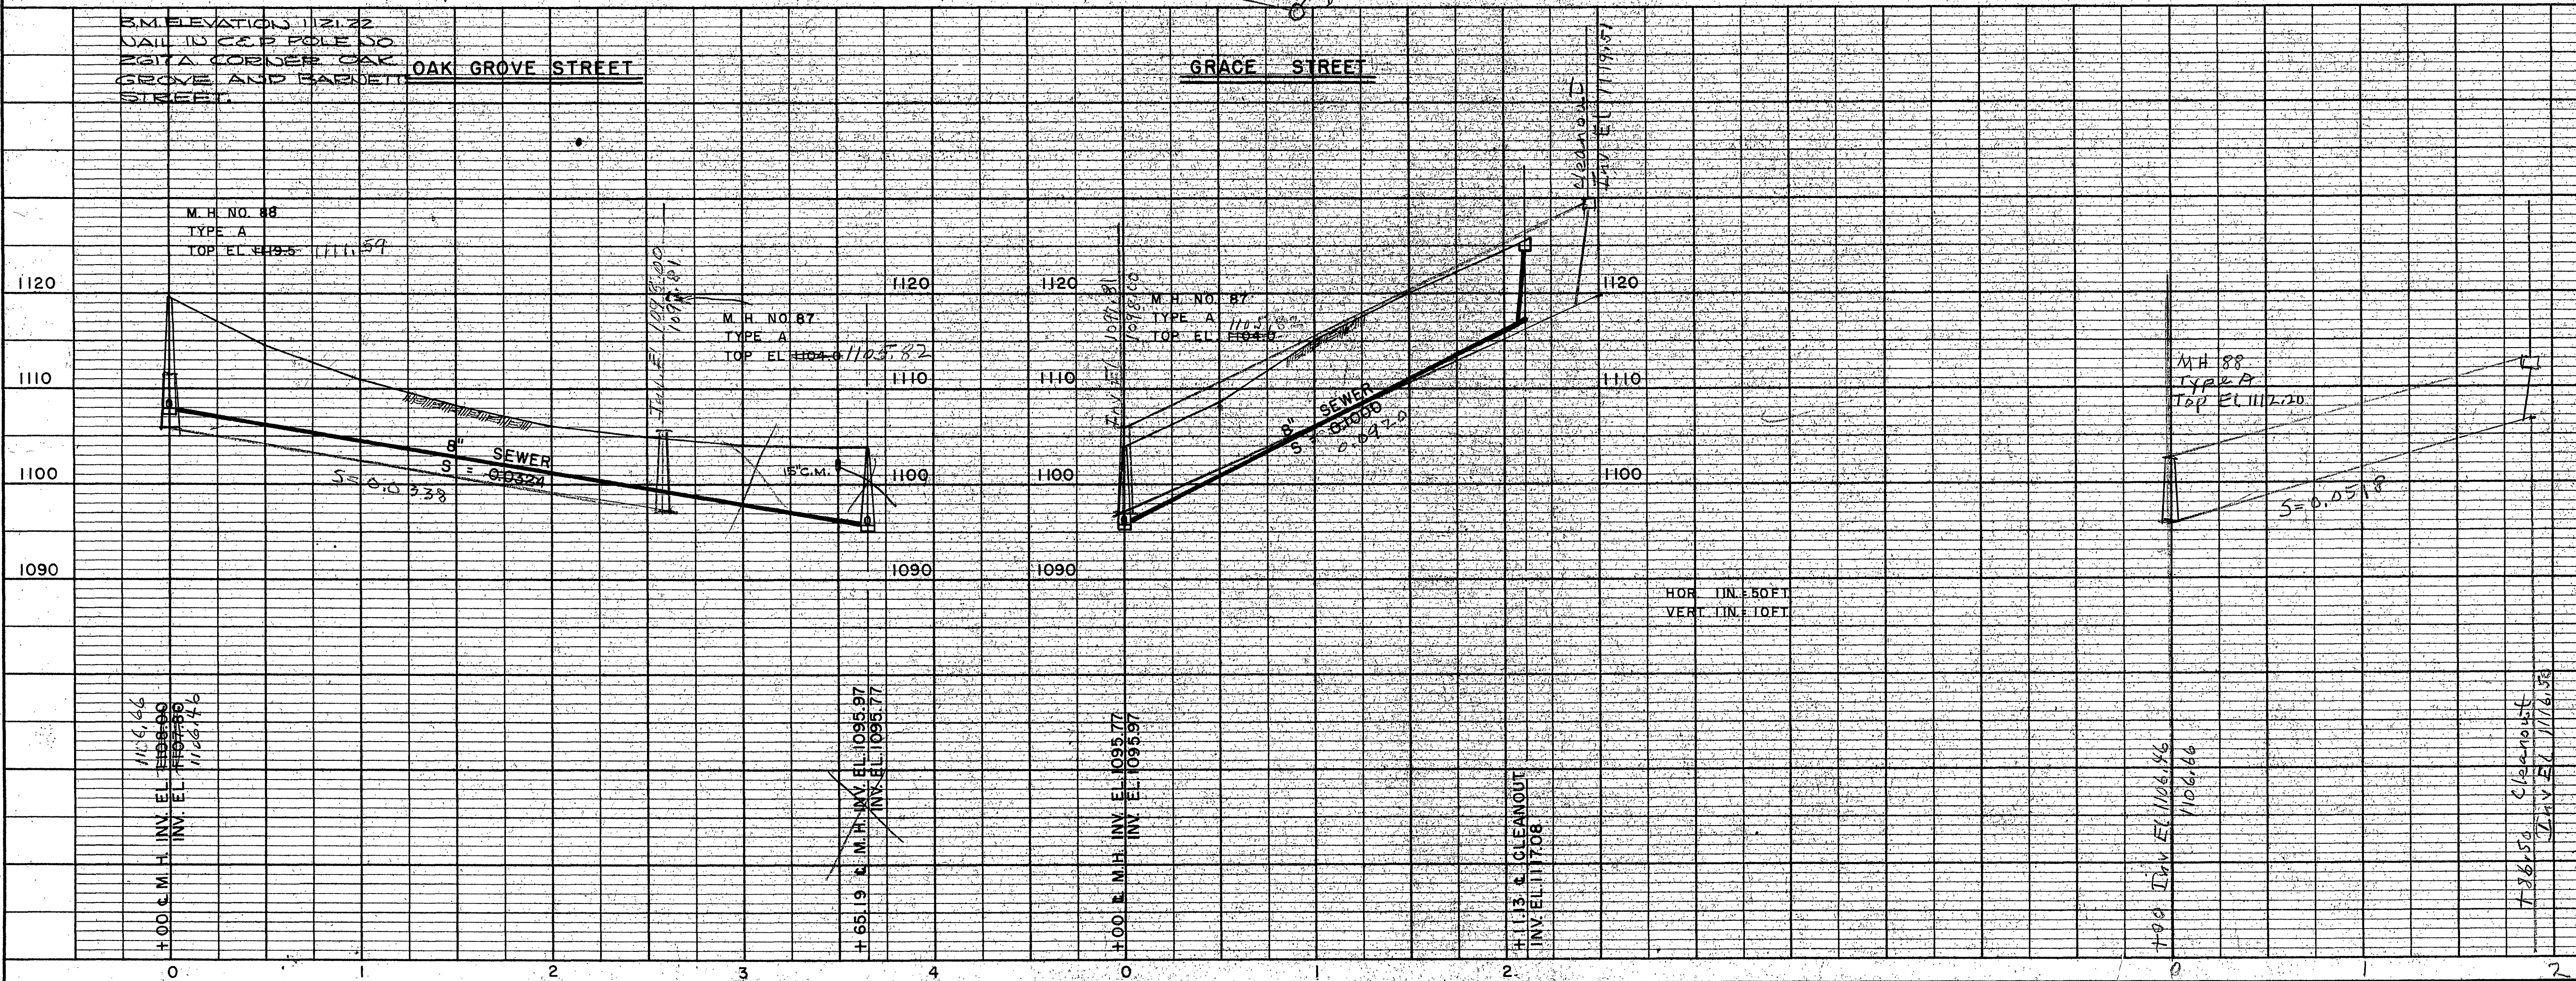


PLAN	DATE	BY	DATE
SURVEYED	10/1/64	W.S.	11/6/64
PLOTTED		W.S.	
NOTE BOOK			
NO.			

PROFILE	DATE	BY	DATE
SURVEYED	10/1/64	W.S.	11/6/64
PLOTTED		W.S.	
NOTE BOOK			
NO.			

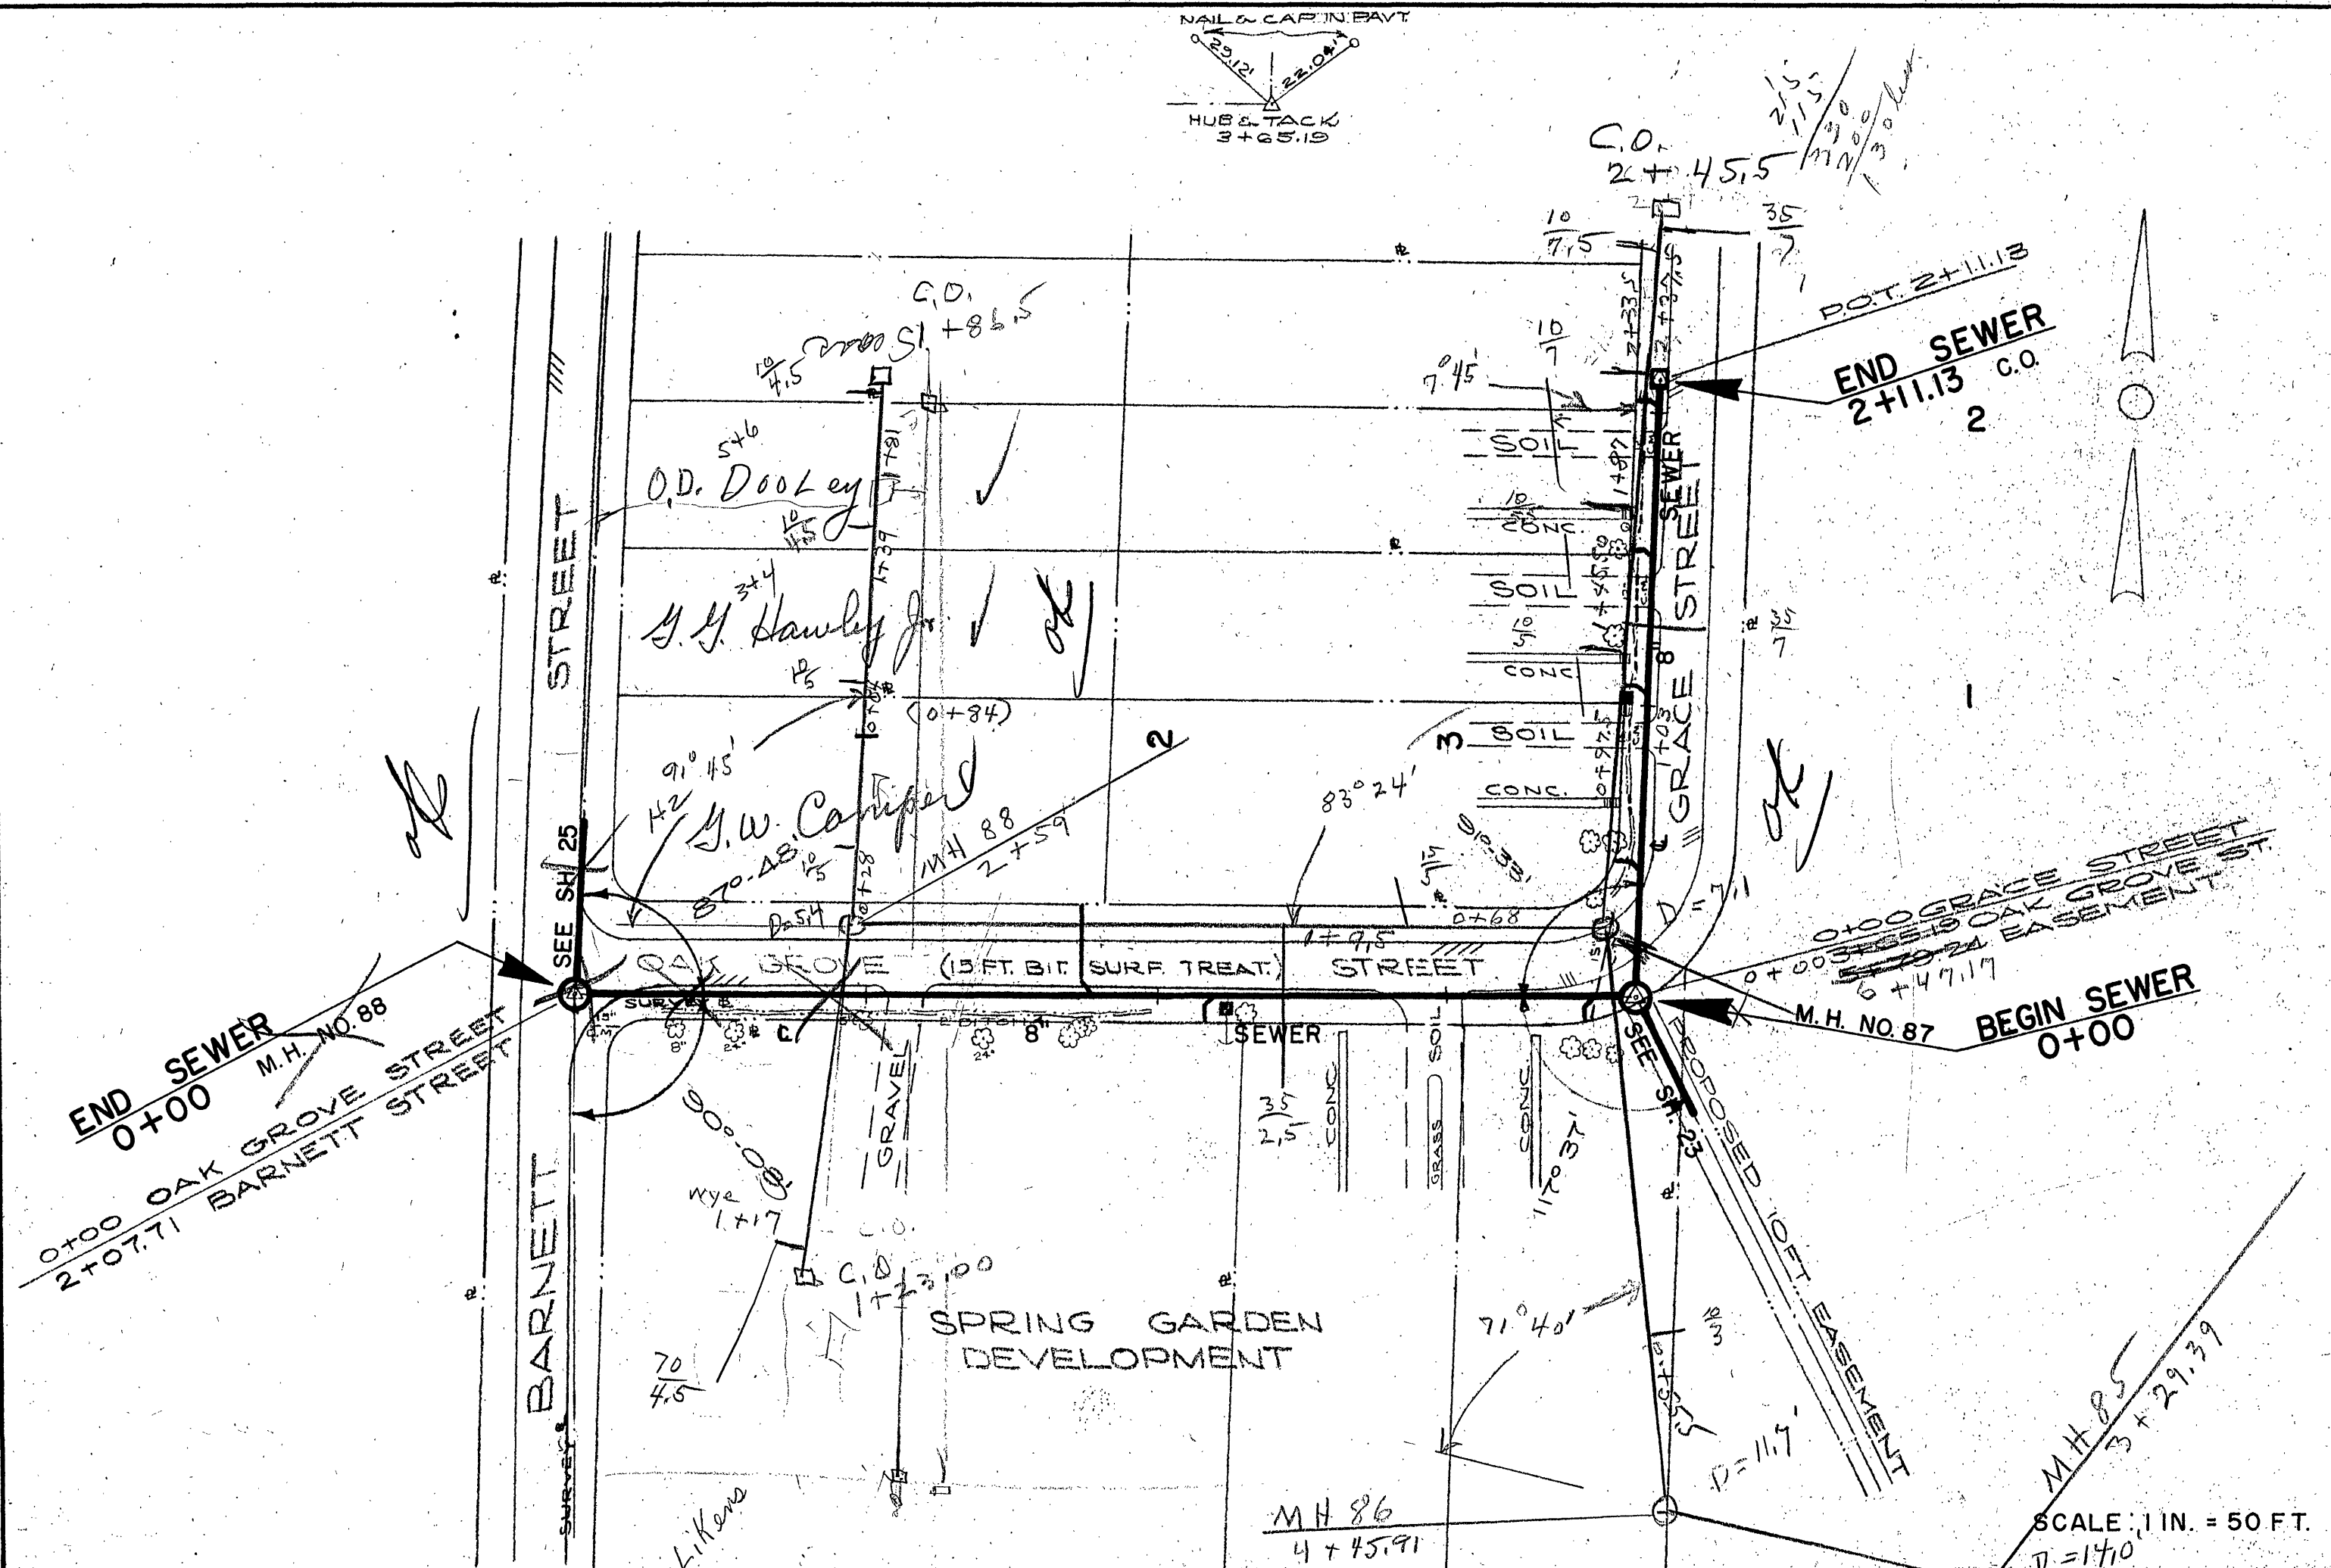

ROANOKE COUNTY SANITATION AUTHORITY				
ROANOKE COUNTY, VIRGINIA				
SANITARY		SEWERAGE		SYSTEM
PROJECT NO. 64-6				
OAK GROVE STREET - GRACE STREET				
STA. 0+00 TO 3+65.13 - STA. 0+00 TO 2+11.13				
DESIGNED:	W.E.C.	LANLEY AND McDONALD		SCALE: AS SHOWN
PLOTTED:	T.D.H.	CONSULTING ENGINEERS		DATE: DEC. 1, 1964
DRAWN:	T.D.H.	NORFOLK, VA.		SHEET: 24 OF 34
CHECKED:	W.C.O.			DWG. NO. 6161157