
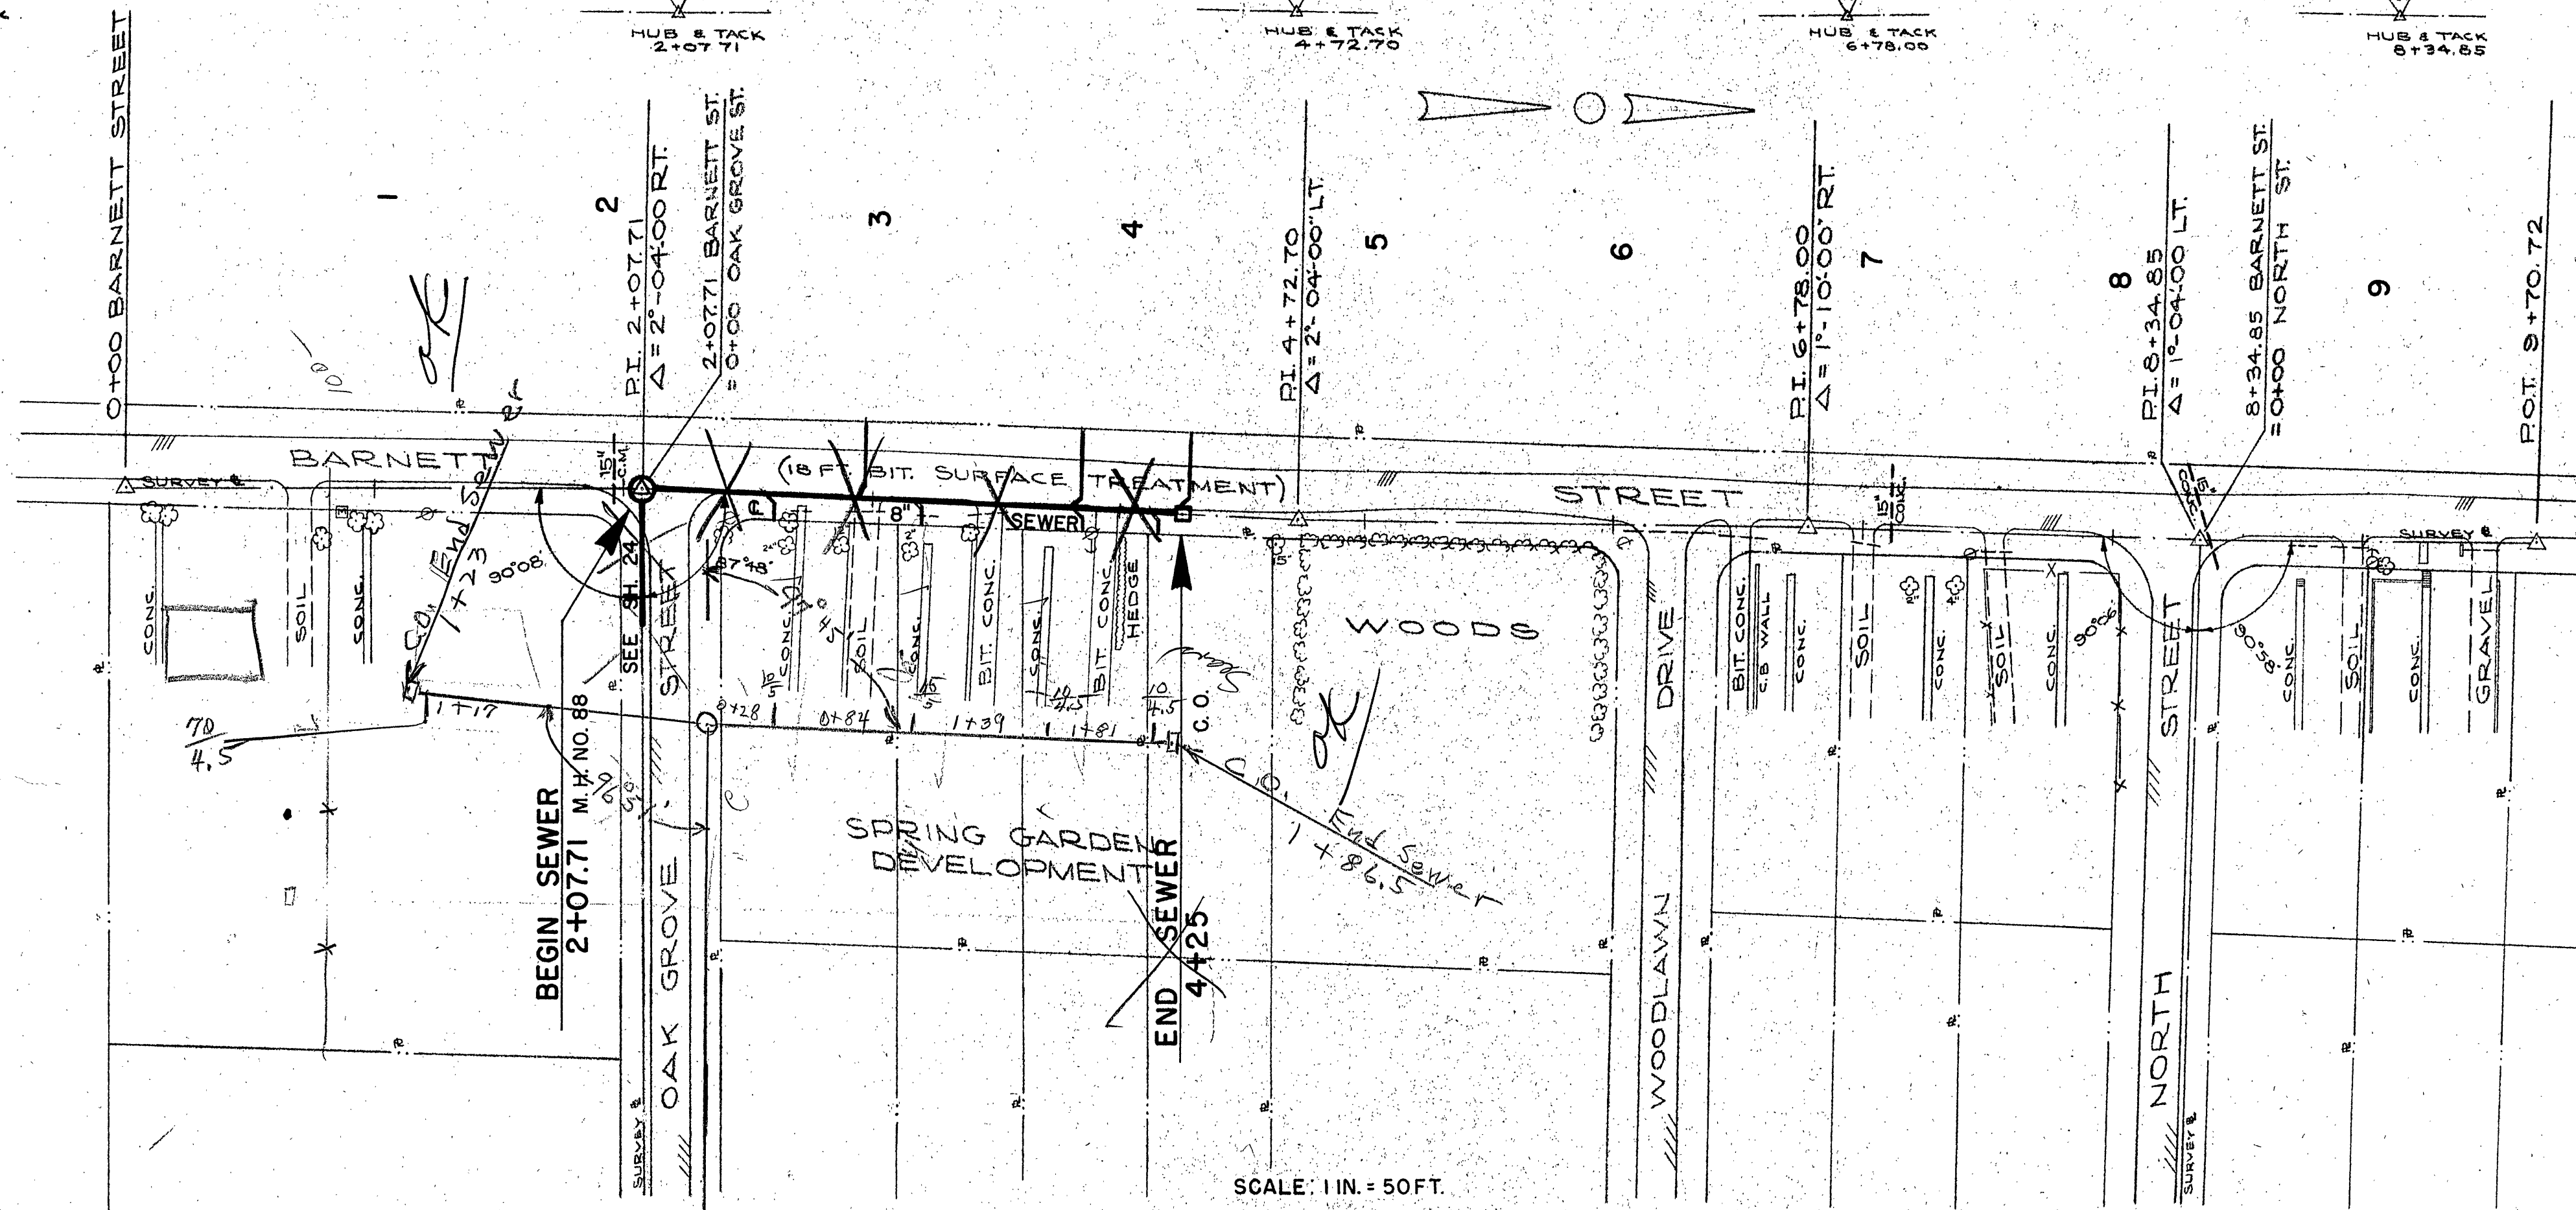
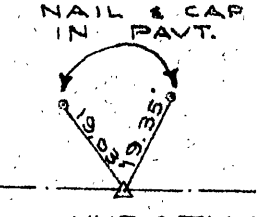
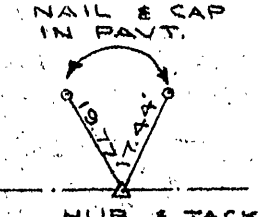
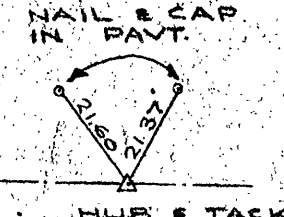
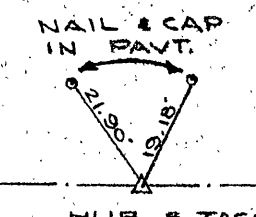




PLAN	DATE	BY	DATE
SURVISED	12/22/64	W.S.H.	12/22/64
NOTE BOOK			
NO.			

PROFILE	DATE	BY	DATE
SURVISED	12/22/64	W.S.H.	12/22/64
NOTE BOOK			
NO.			

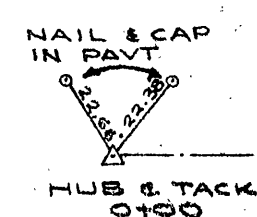

SCALE: 1 IN = 50 FT.

EE6

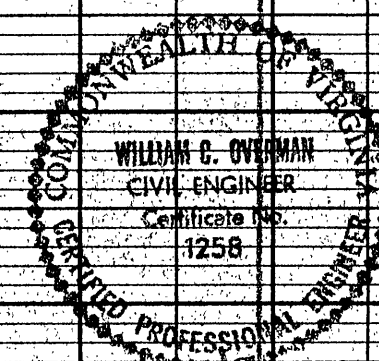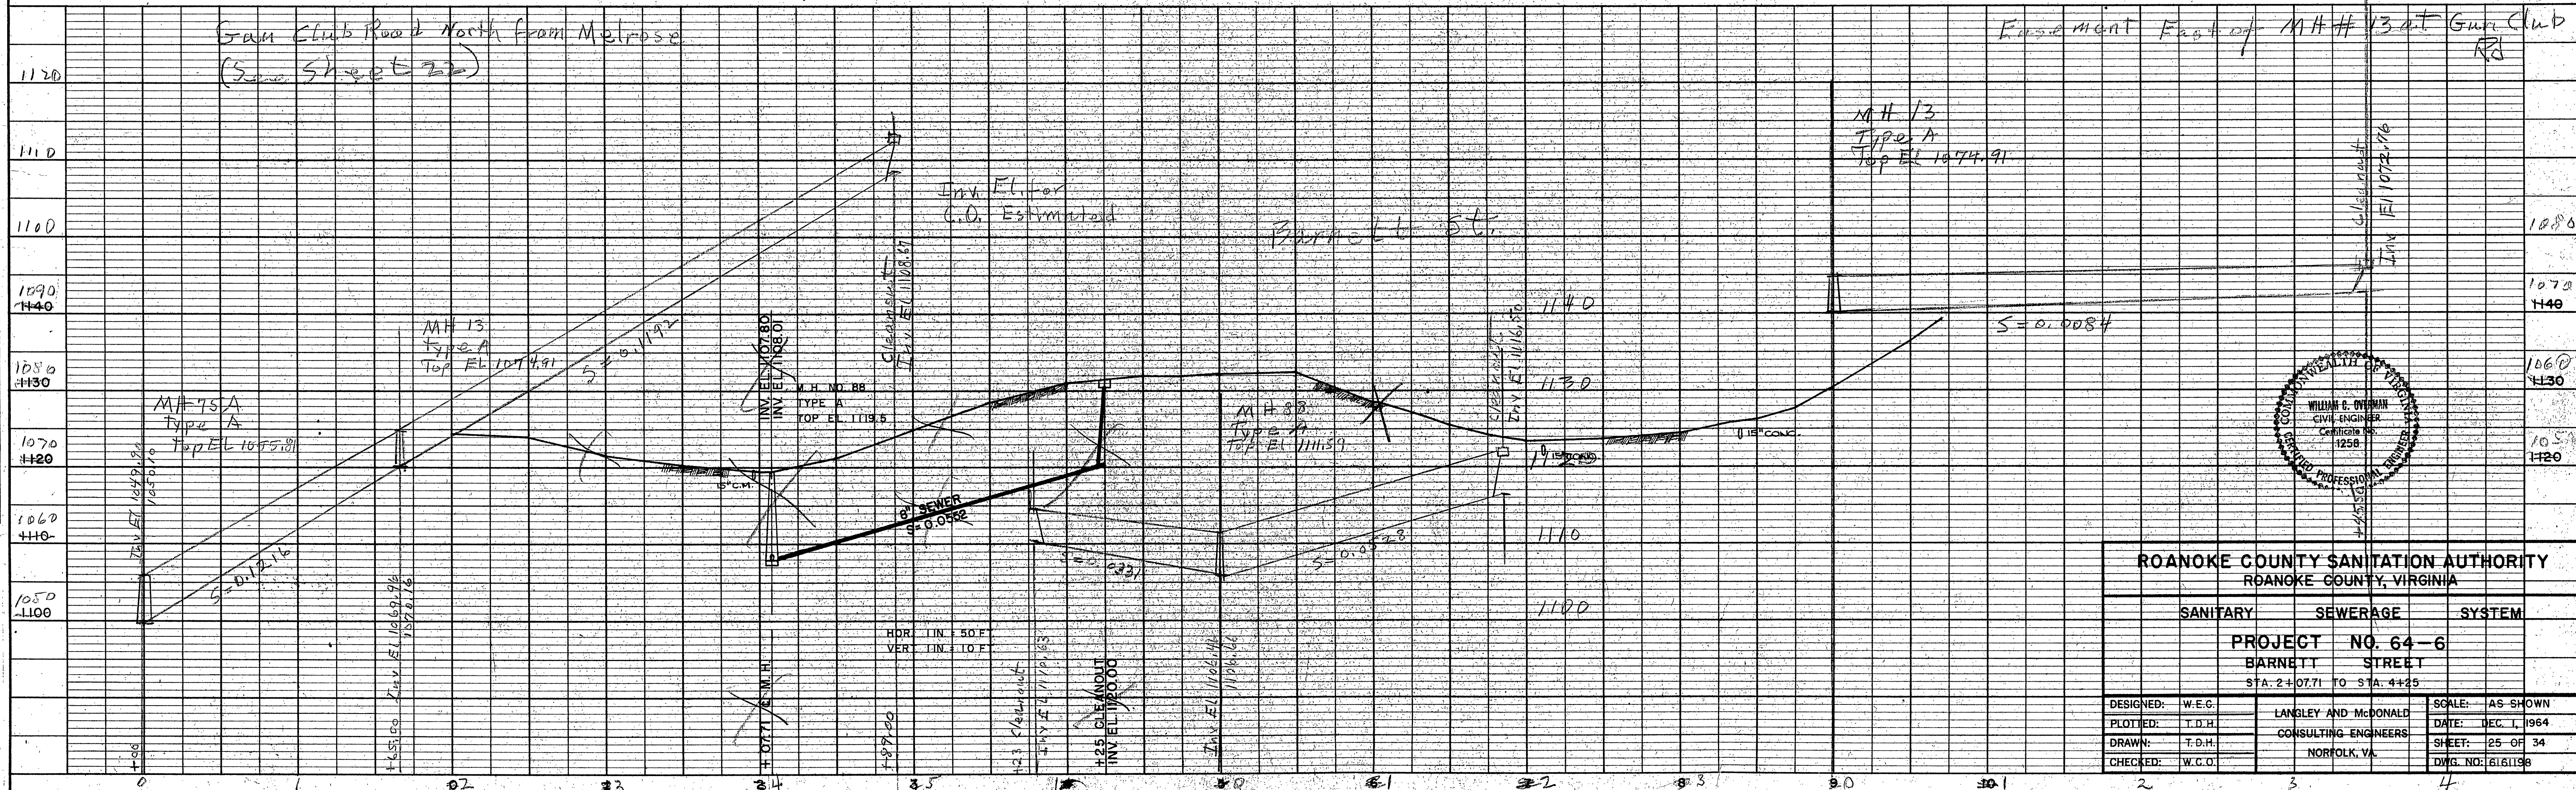

ROANOKE COUNTY SANITATION AUTHORITY ROANOKE COUNTY, VIRGINIA		
SANITARY	SEWERAGE	SYSTEM
PROJECT NO. 64-6 BARNETT STREET		
STA. 2+07.71 TO STA. 4+25		
DESIGNED: W.E.G.	LANGLEY AND McDONALD	SCALE: AS SHOWN
PLOTTED: T.D.H.	CONSULTING ENGINEERS	DATE: DEC. 1, 1964
DRAWN: T.D.H.	NORFOLK, VA.	SHEET: 25 OF 34
CHECKED: W.C.O.		DWG. NO: 6161198