
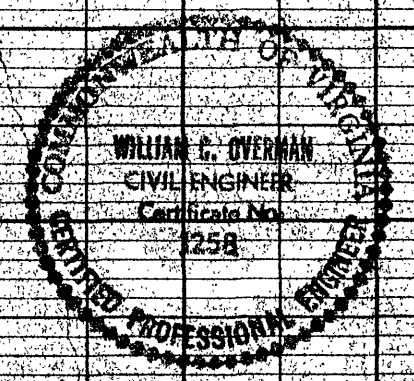
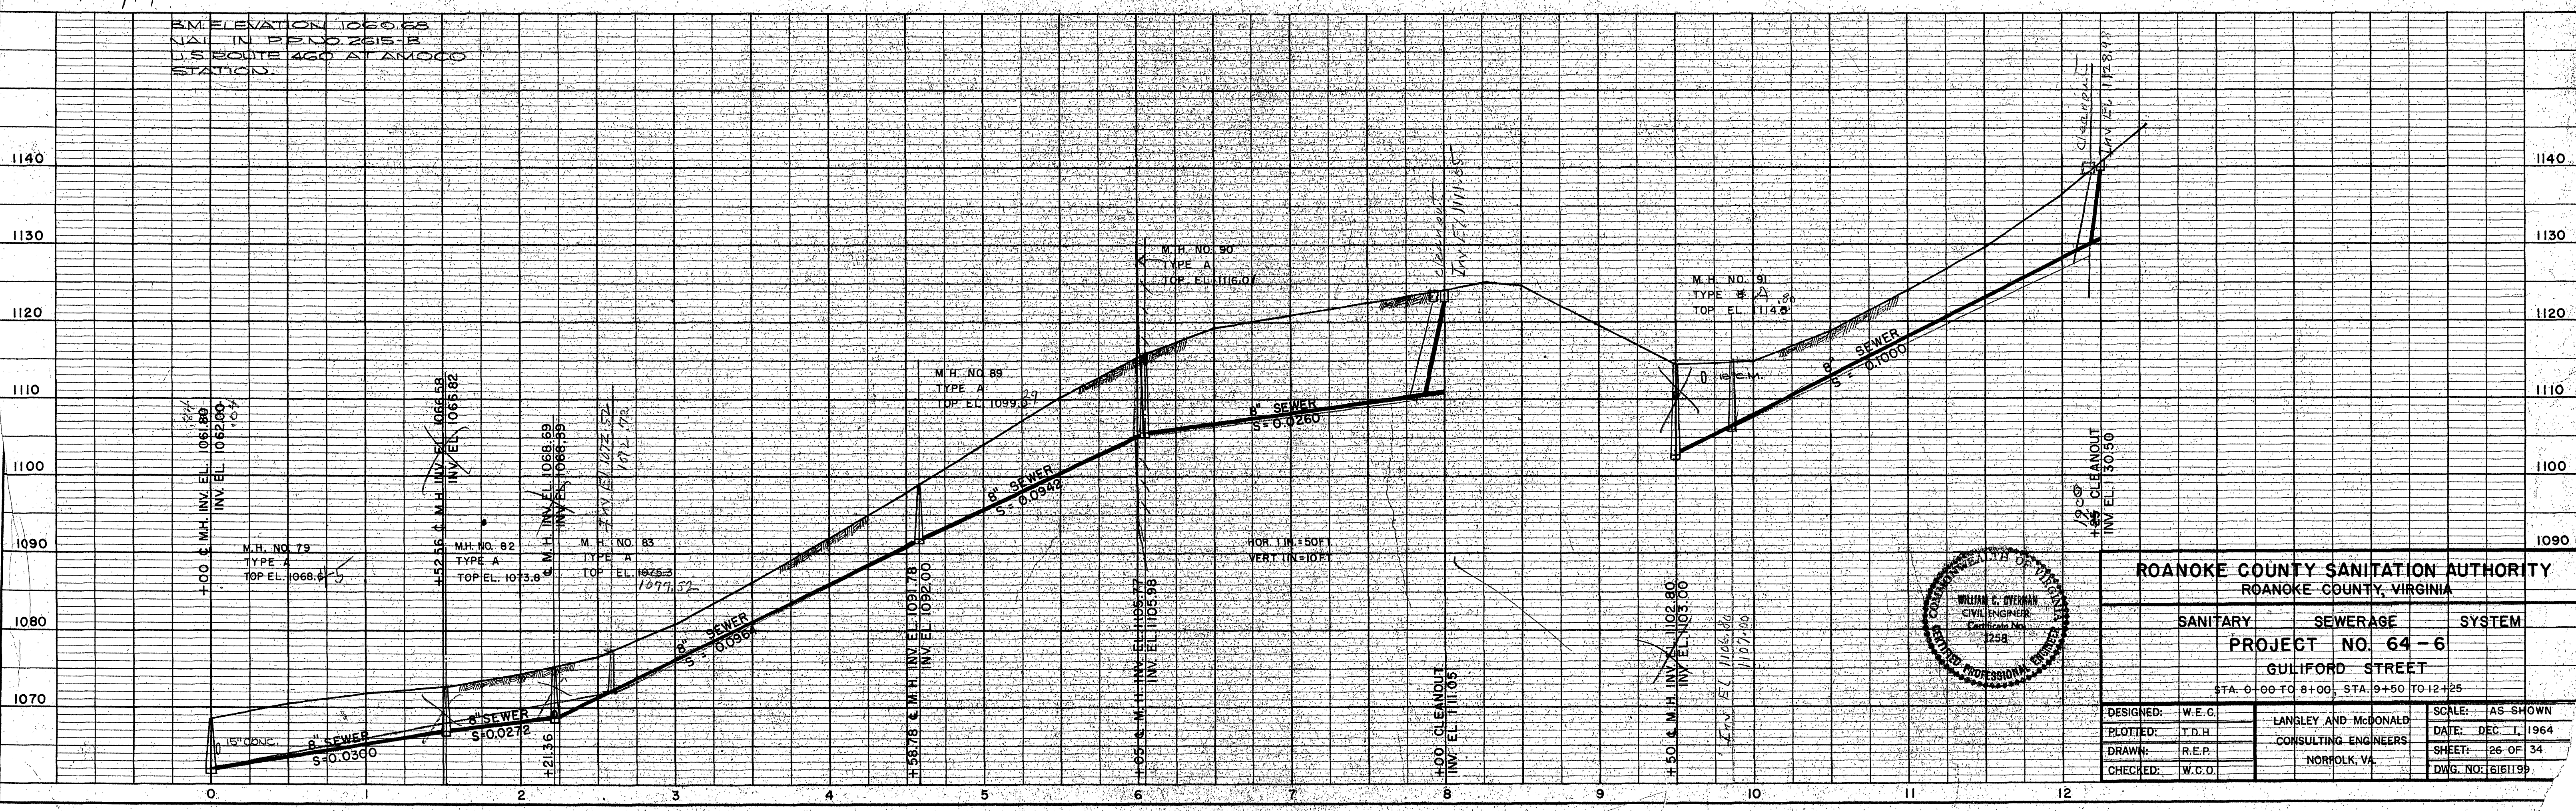


PLAN	DATE	BY	DATE
SURVEYED	10/22/64	W.S.	10/22/64
NOTE BOOK		W.S.	
NO.		RT. OF WAY CHECKED	

PROFILE	DATE	BY	DATE
PLOTTED	10/22/64	W.S.	10/22/64
NOTE BOOK		W.S.	
NO.		STRUCTURE NOTATIONS	

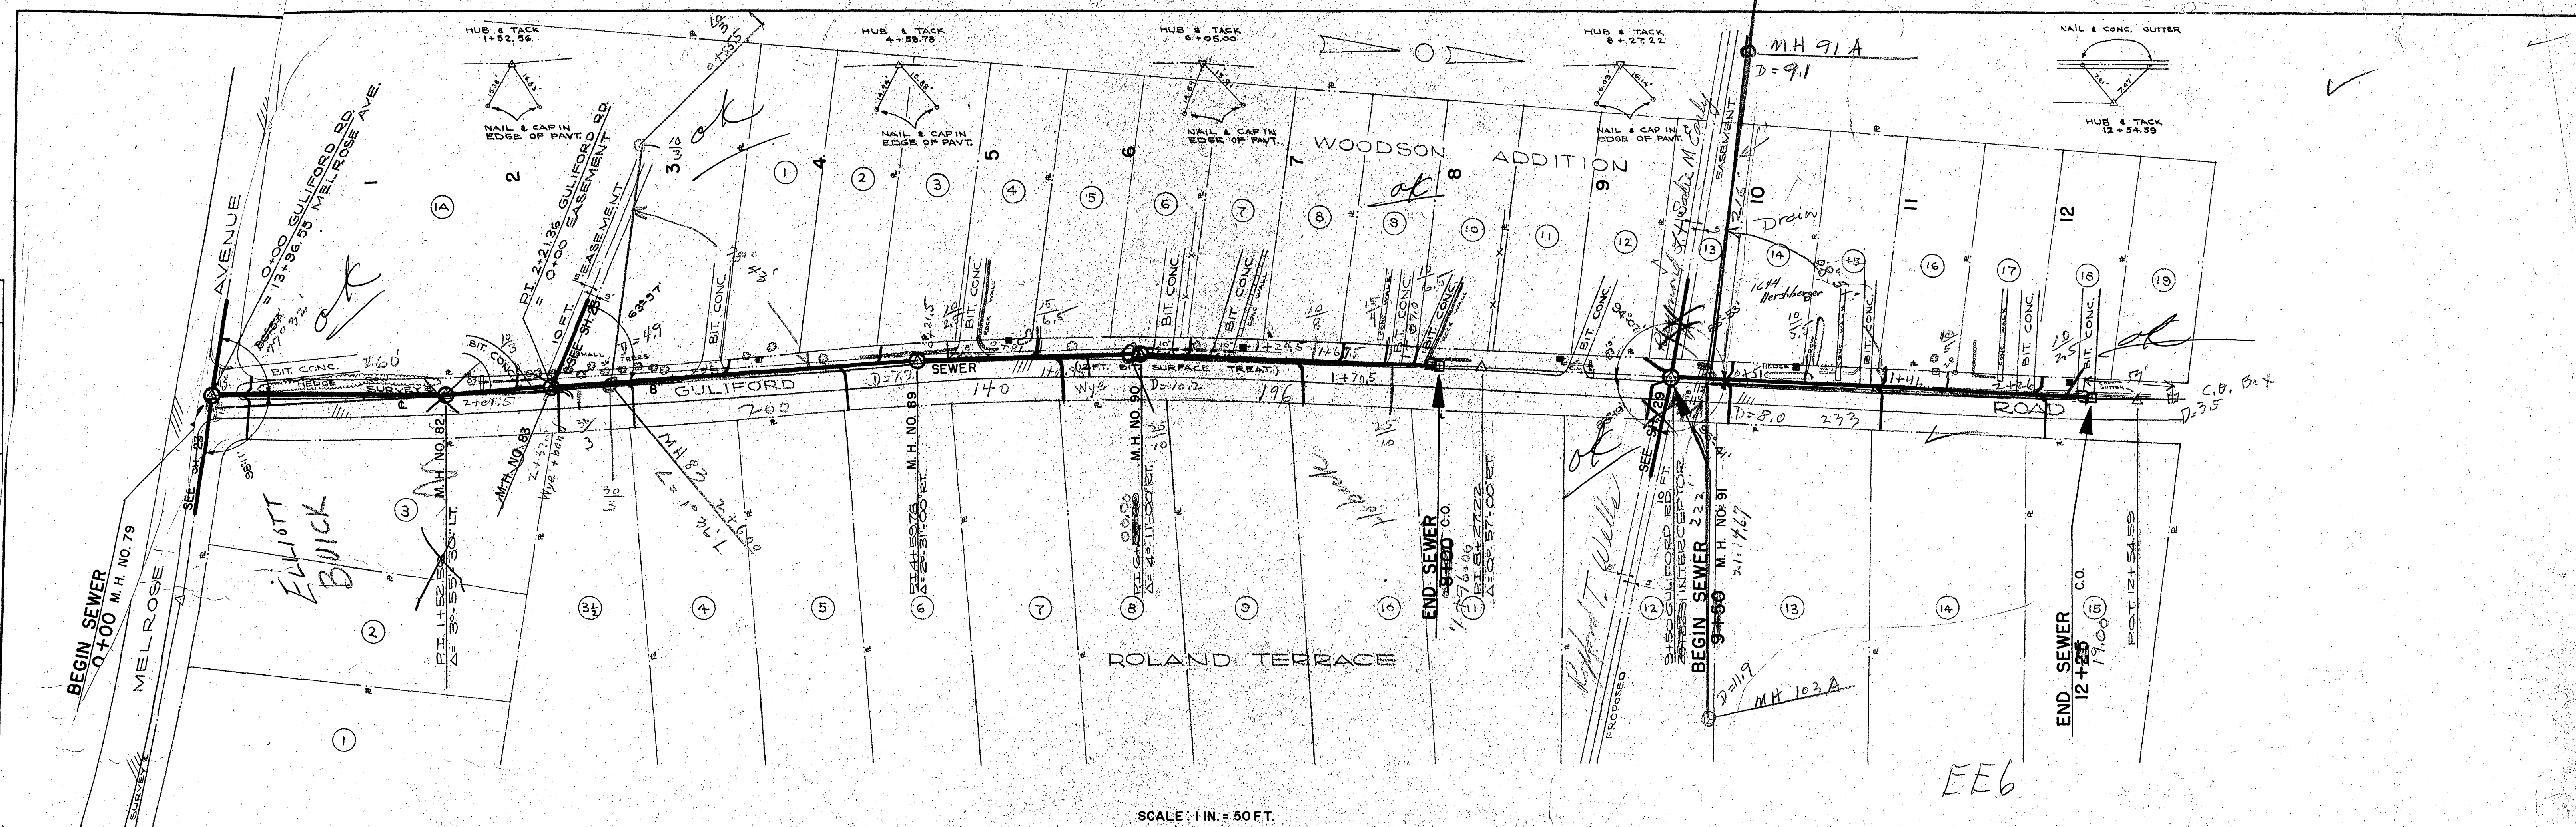

ROANOKE COUNTY SANITATION AUTHORITY ROANOKE COUNTY, VIRGINIA		
SANITARY	SEWERAGE	SYSTEM
PROJECT NO. 64-6		
GULIFORD STREET		
STA. 0+00 TO 8+00, STA. 9+50 TO 12+25		
DESIGNED: W.E.C.	LANSLEY AND McDONALD	SCALE: AS SHOWN
PLOTTED: T.D.H.	CONSULTING ENGINEERS	DATE: DEC. 1, 1964
DRAWN: R.E.P.	NORFOLK, VA.	SHEET: 26 OF 34
CHECKED: W.C.O.		DWG. NO. 6161199