



PLAN	DATE
NO.	10/2/64
NOTE BOOK	BY J.S.B.
RT. OF WAY CHECKED	DATE 10/2/64
ALIGNMENT CHECKED	
SURVEYED	

PROFILE	DATE
NO.	10/2/64
NOTE BOOK	BY J.S.B.
STRUCTURE NOTATION	DATE 10/2/64
VERT. CHECKED	
STRUCTURE NOTATION	

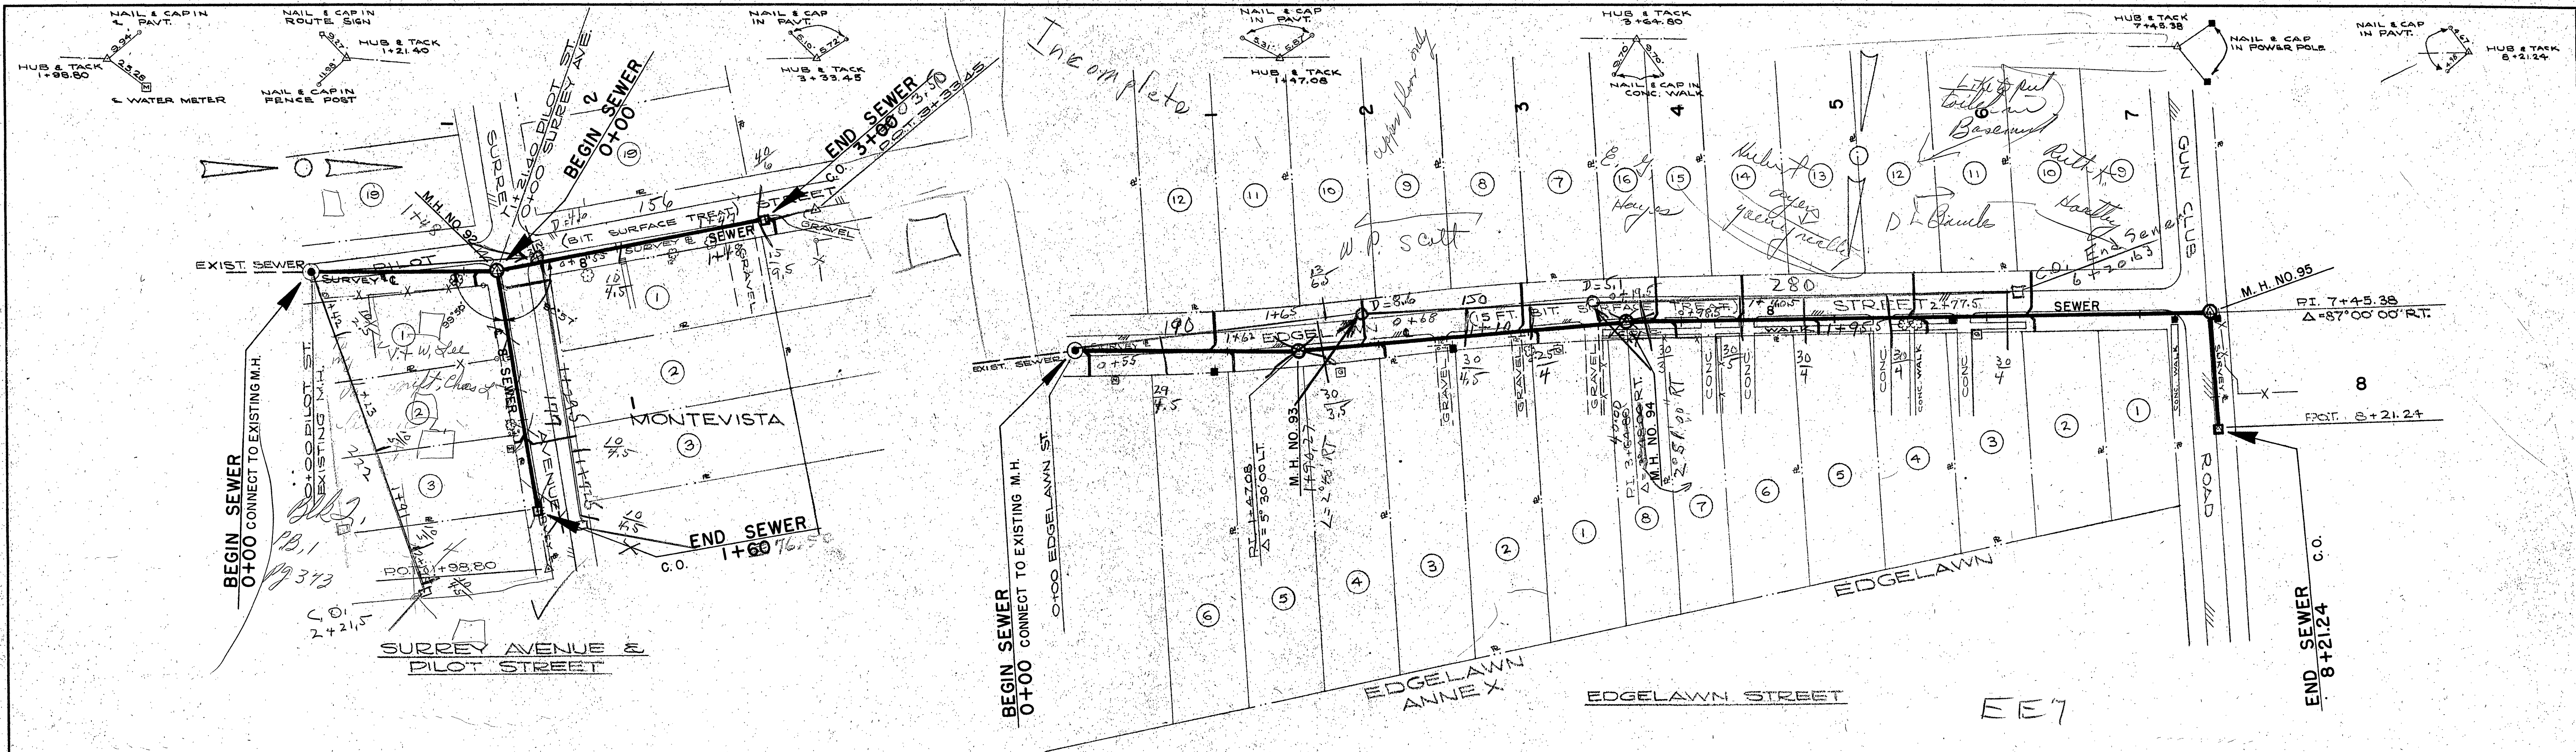

SCALE: 1 IN. = 50 FT.

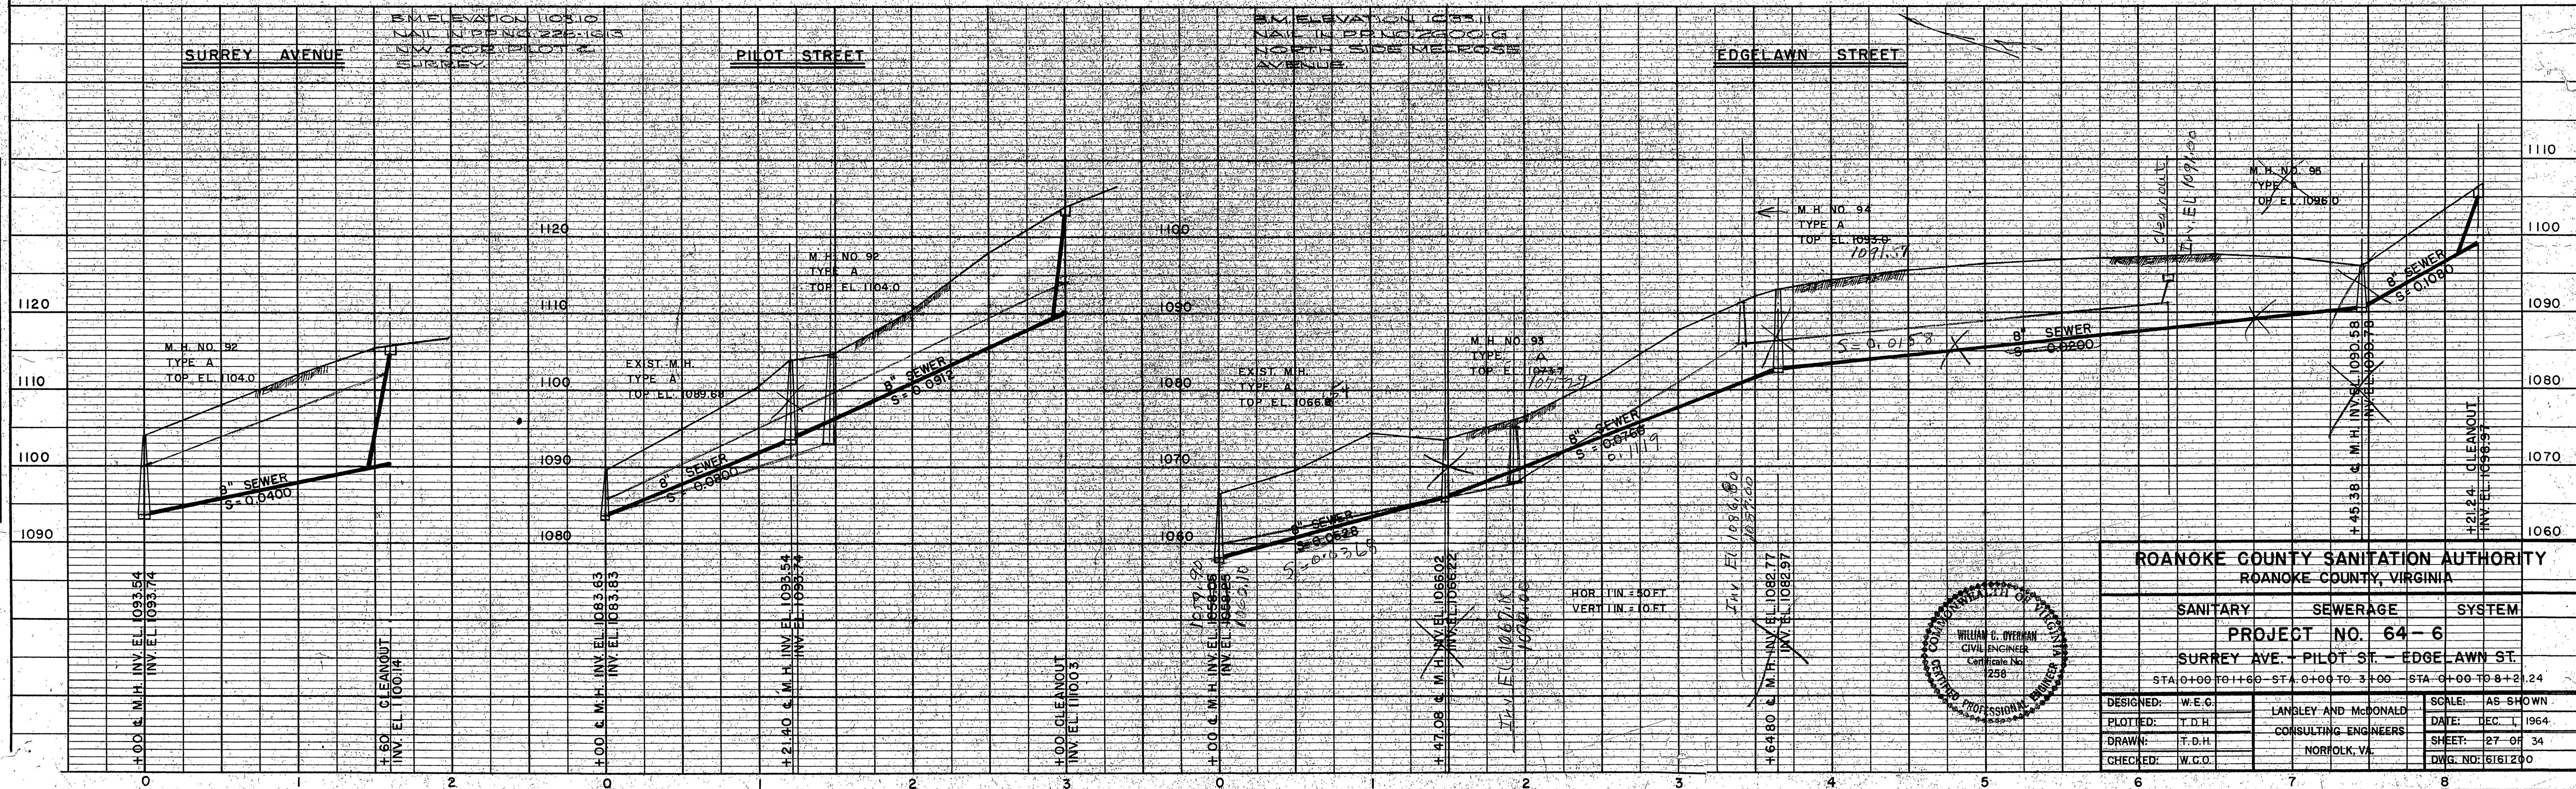

ROANOKE COUNTY SANITATION AUTHORITY ROANOKE COUNTY, VIRGINIA		
SANITARY	SEWERAGE	SYSTEM
PROJECT NO. 64-6		
SURREY AVE. - PILOT ST. - EDGE LAWN ST.		
STA. 0+00 TO 1+60 - STA. 0+00 TO 3+00 - STA. 0+00 TO 8+21.24		
DESIGNED: W.E.G.	LANGLEY AND McDONALD	SCALE: AS SHOWN
PLOTTED: T.D.H.	CONSULTING ENGINEERS	DATE: DEC. 1, 1964
DRAWN: T.D.H.	NORFOLK, VA.	SHEET: 27 OF 34
CHECKED: W.C.D.		DWG. NO: 16161200