



PLAN	DATE	BY	DATE
SURVEYED	11/15/62	J.C.S.	11/15/62
NOTED		C.A.E.	
NOTE BOOK		RT. OF WAY CHECKED	
NO.			

PROFILE	DATE	BY	DATE
PLOTTED	11/15/62	J.C.S.	11/15/62
NOTED		C.A.E.	
NOTE BOOK		STRUCTURE NOTATIONS CHD.	
NO.			

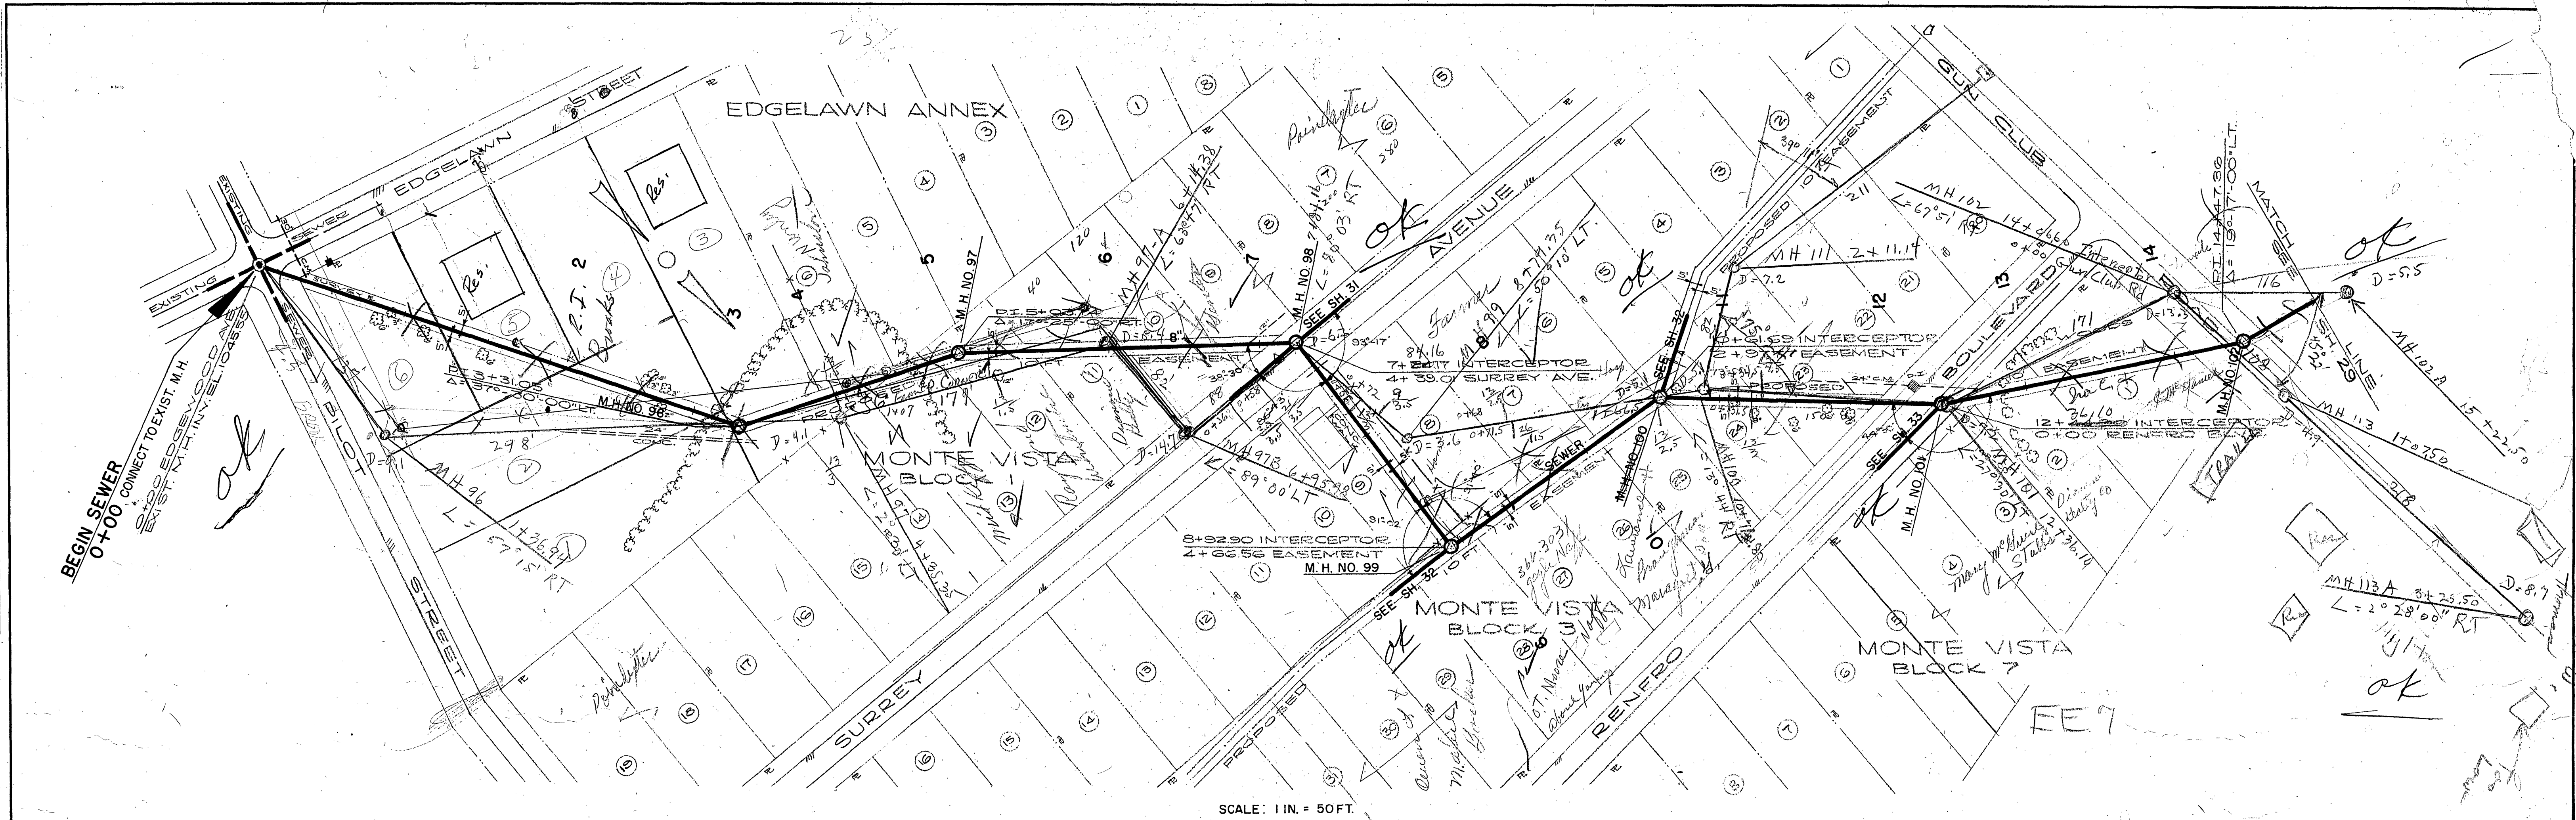

SCALE: 1 IN. = 50 FT.

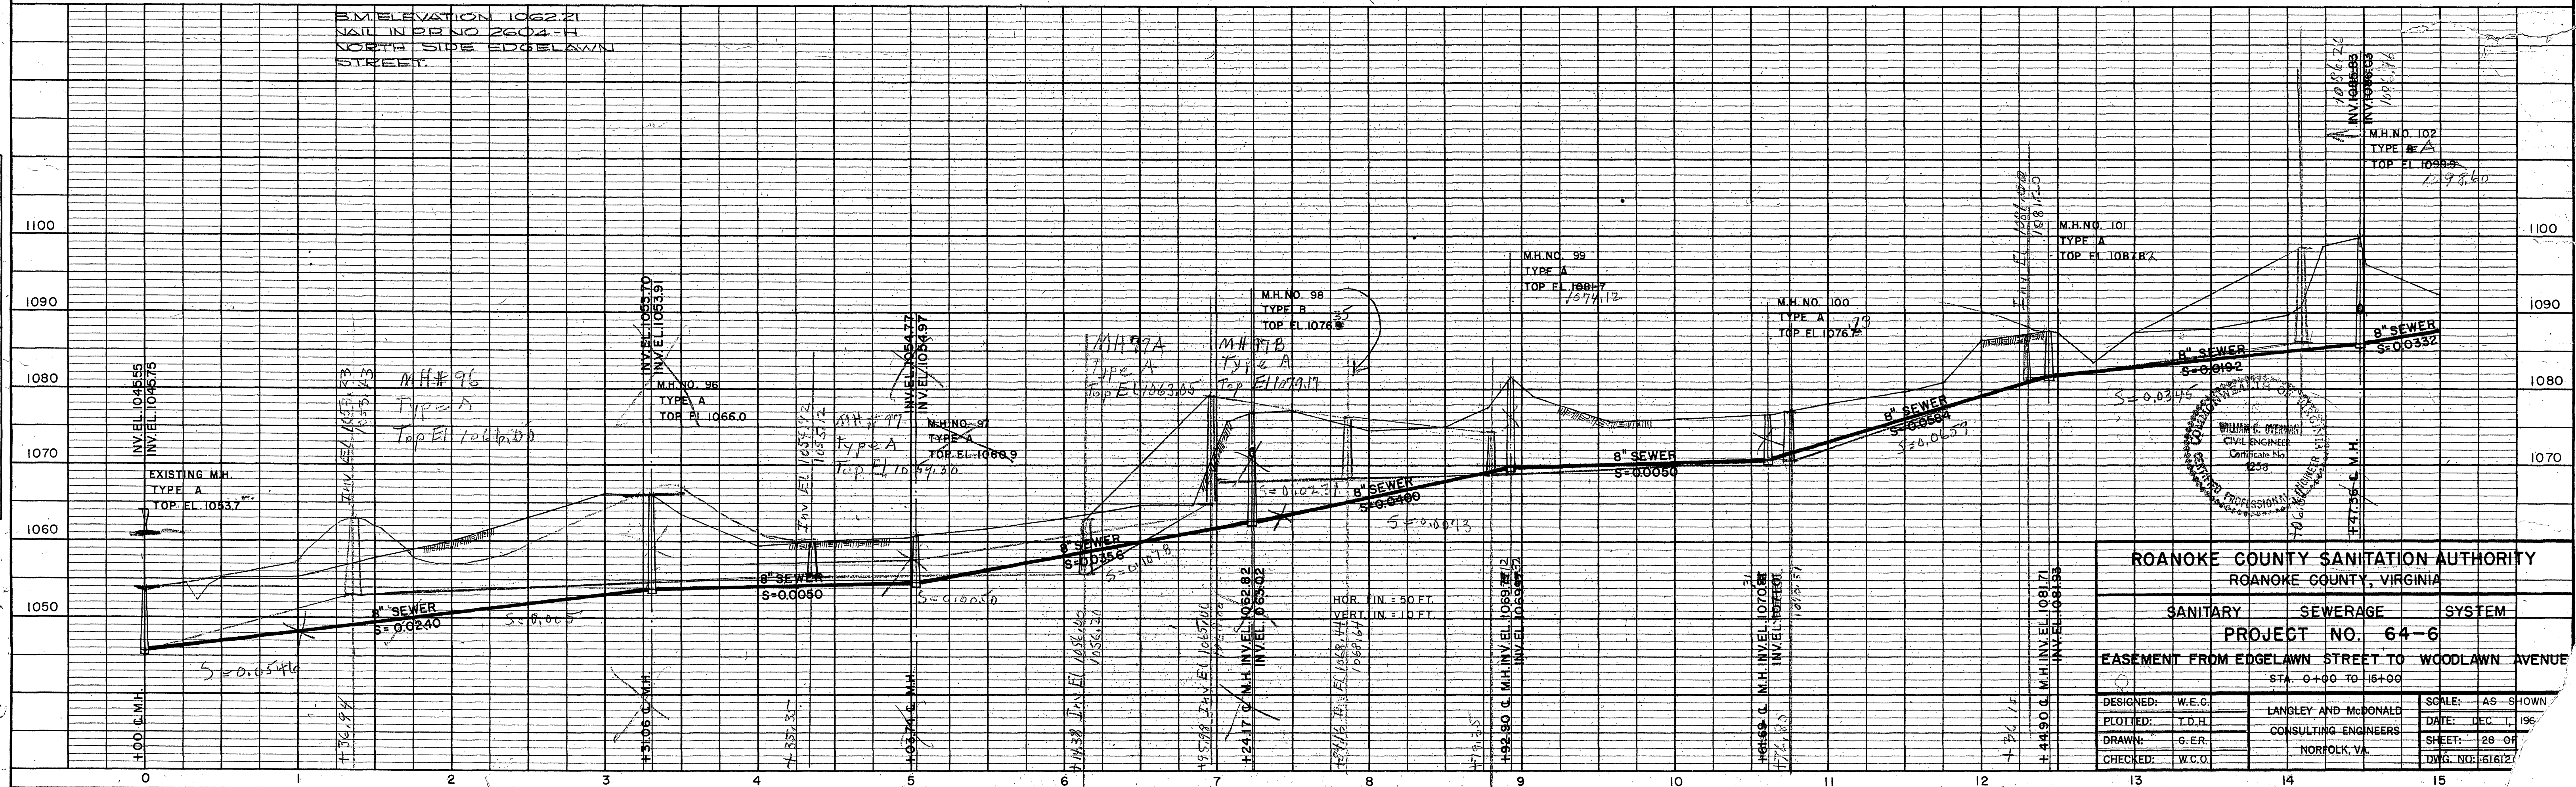

ROANOKE COUNTY SANITATION AUTHORITY			
ROANOKE COUNTY, VIRGINIA			
SANITARY		SEWERAGE	
PROJECT NO.		64-6	
EASEMENT FROM EDGLAWN STREET TO WOODLAWN AVENUE			
STA. 0+00 TO 15+00			
DESIGNED:	W.E.G.	LANGLEY AND McDONALD	SCALE: AS SHOWN
PLOTTED:	T.D.H.	CONSULTING ENGINEERS	DATE: DEC 1, 1962
DRAWN:	G.E.R.	NORFOLK, VA.	SHEET: 28 OF 28
CHECKED:	W.C.O.		DWG. NO. 616127