

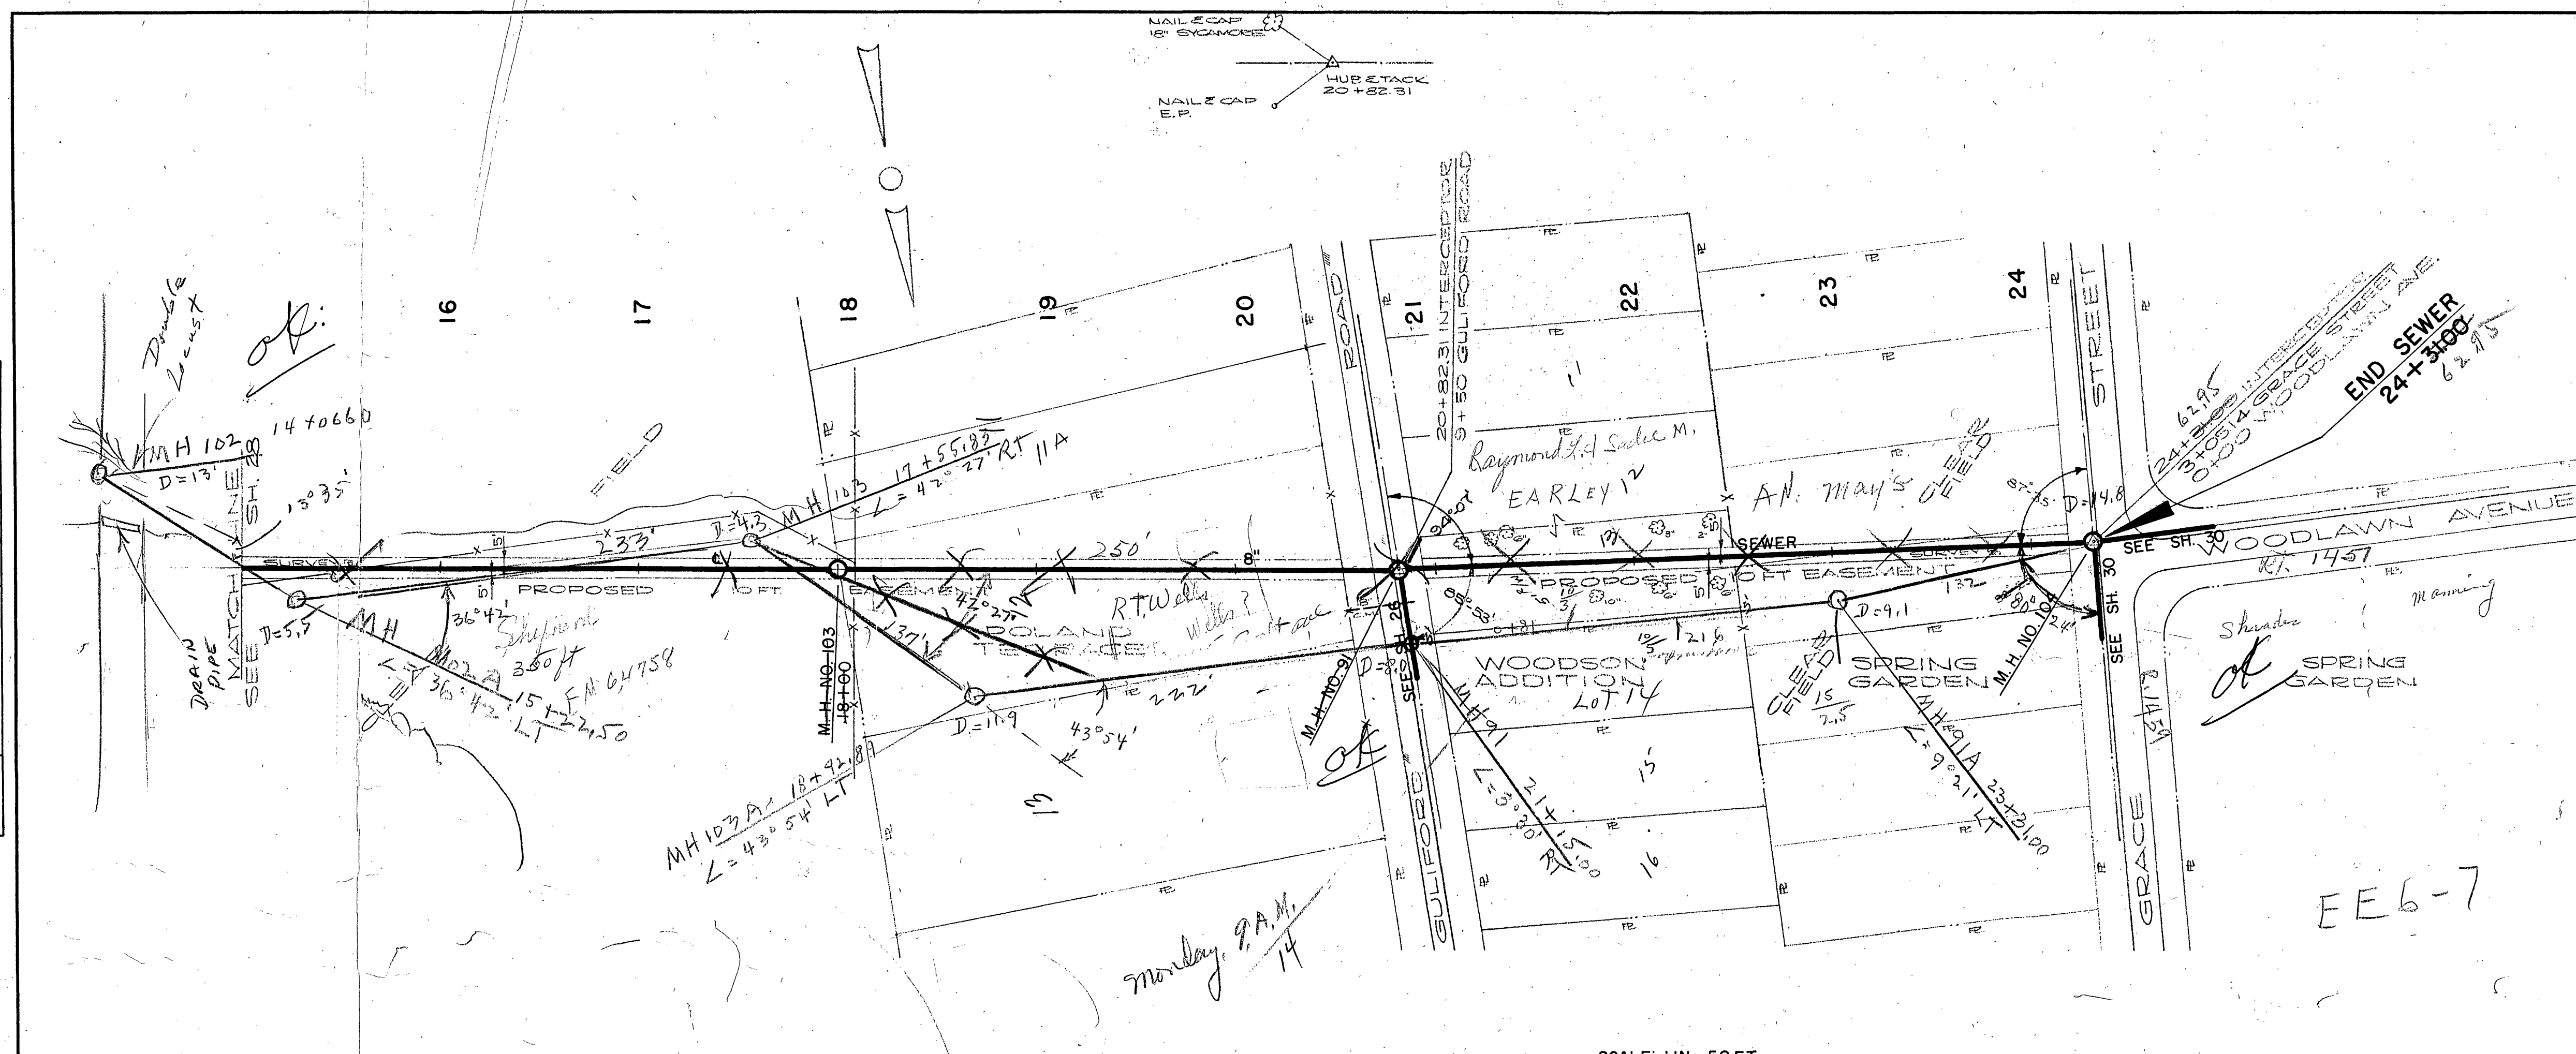


| PLAN      | DATE     | BY     | DATE     | BY     |
|-----------|----------|--------|----------|--------|
| SURVEYED  | 10/15/64 | J.C.B. | 10/15/64 | J.C.B. |
| PLOTTED   |          | J.C.B. |          | J.C.B. |
| NOTE BOOK |          |        |          |        |
| NO.       |          |        |          |        |

| PROFILE   | DATE     | BY     | DATE     | BY     |
|-----------|----------|--------|----------|--------|
| SURVEYED  | 10/15/64 | J.C.B. | 10/15/64 | J.C.B. |
| PLOTTED   |          | J.C.B. |          | J.C.B. |
| NOTE BOOK |          |        |          |        |
| NO.       |          |        |          |        |

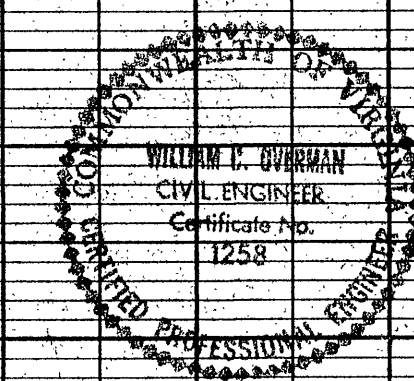

SCALE: 1 IN. = 50 FT.

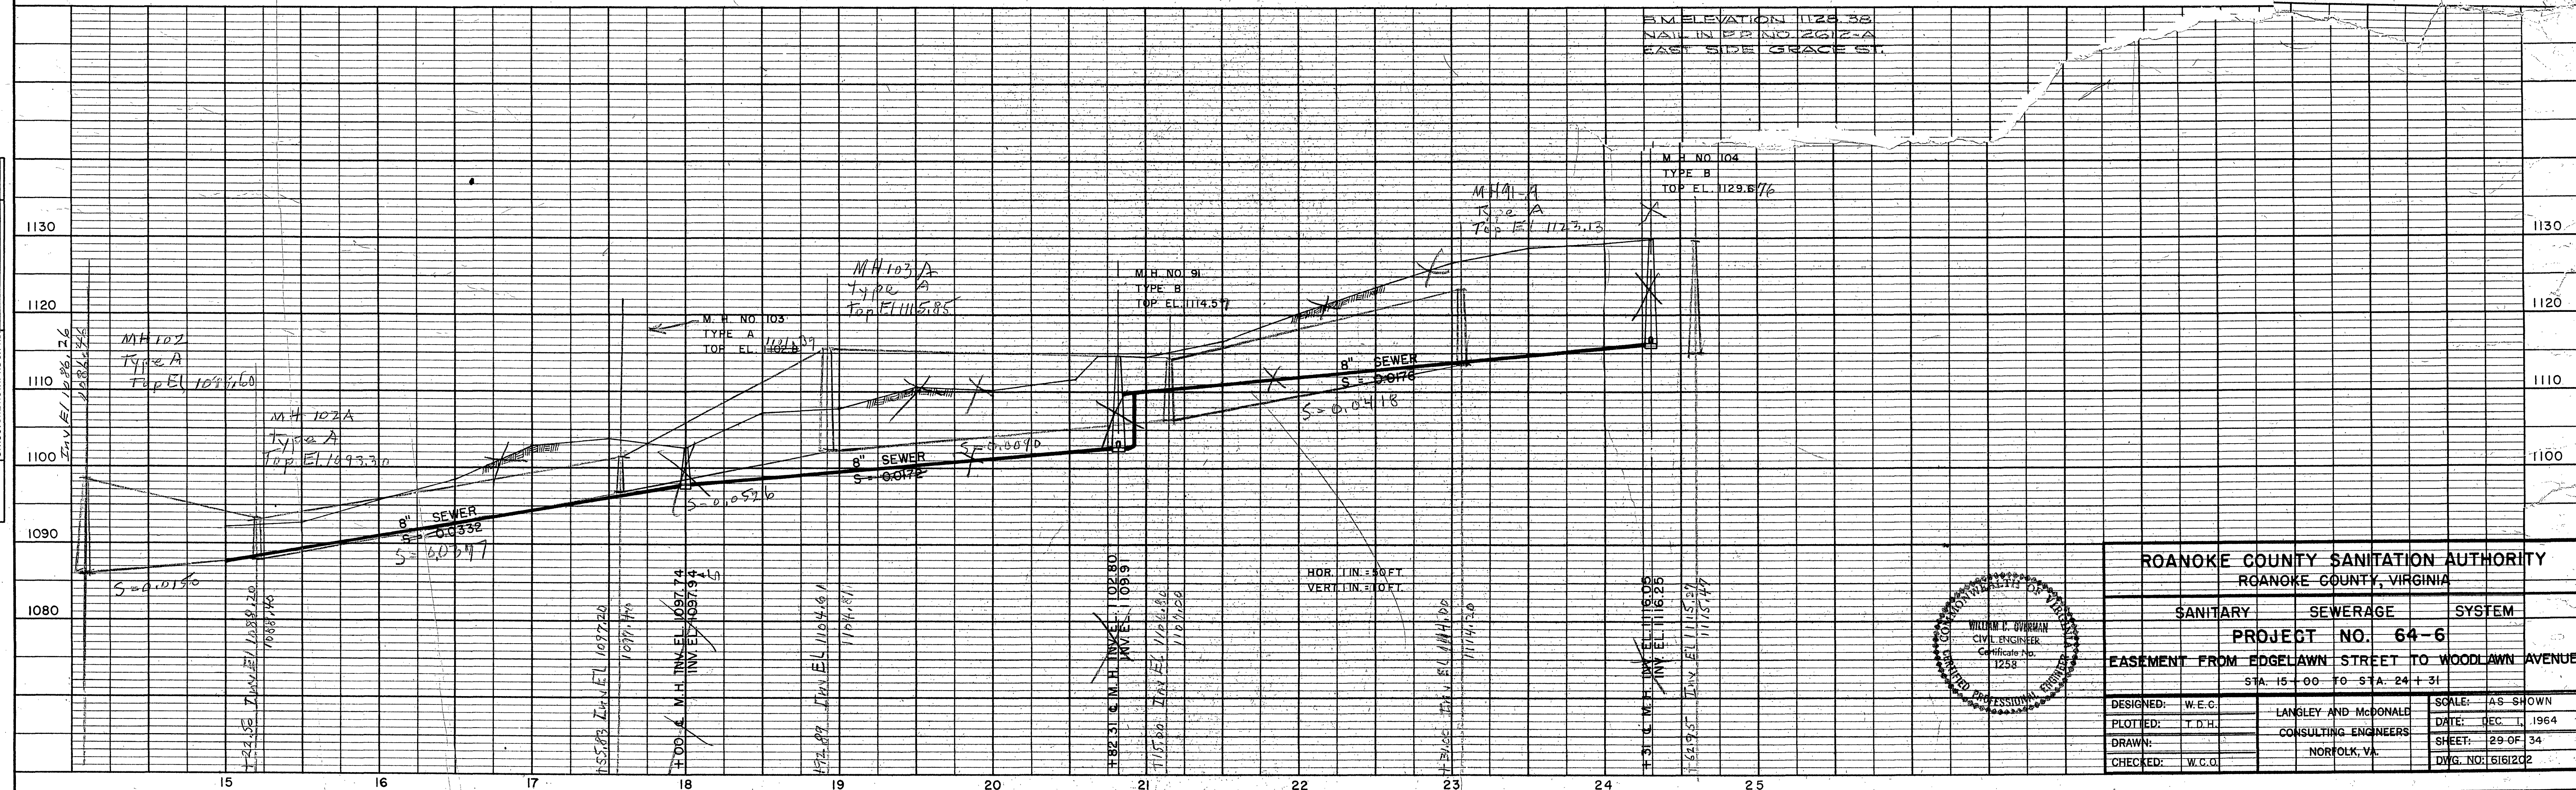

| ROANOKE COUNTY SANITATION AUTHORITY<br>ROANOKE COUNTY, VIRGINIA |                      |                    |
|-----------------------------------------------------------------|----------------------|--------------------|
| SANITARY                                                        | SEWERAGE             | SYSTEM             |
| PROJECT NO. 64-6                                                |                      |                    |
| EASEMENT FROM EDGELAWN STREET TO WOODLAWN AVENUE                |                      |                    |
| STA. 15+00 TO STA. 24+31                                        |                      |                    |
| DESIGNED: W.E.C.                                                | LANGLEY AND McDONALD | SCALE: AS SHOWN    |
| PLOTTED: T.D.H.                                                 | CONSULTING ENGINEERS | DATE: DEC. 1, 1964 |
| DRAWN:                                                          | NORFOLK, VA.         | SHEET: 29 OF 34    |
| CHECKED: W.C.C.                                                 |                      | DWG. NO: 6161202   |