

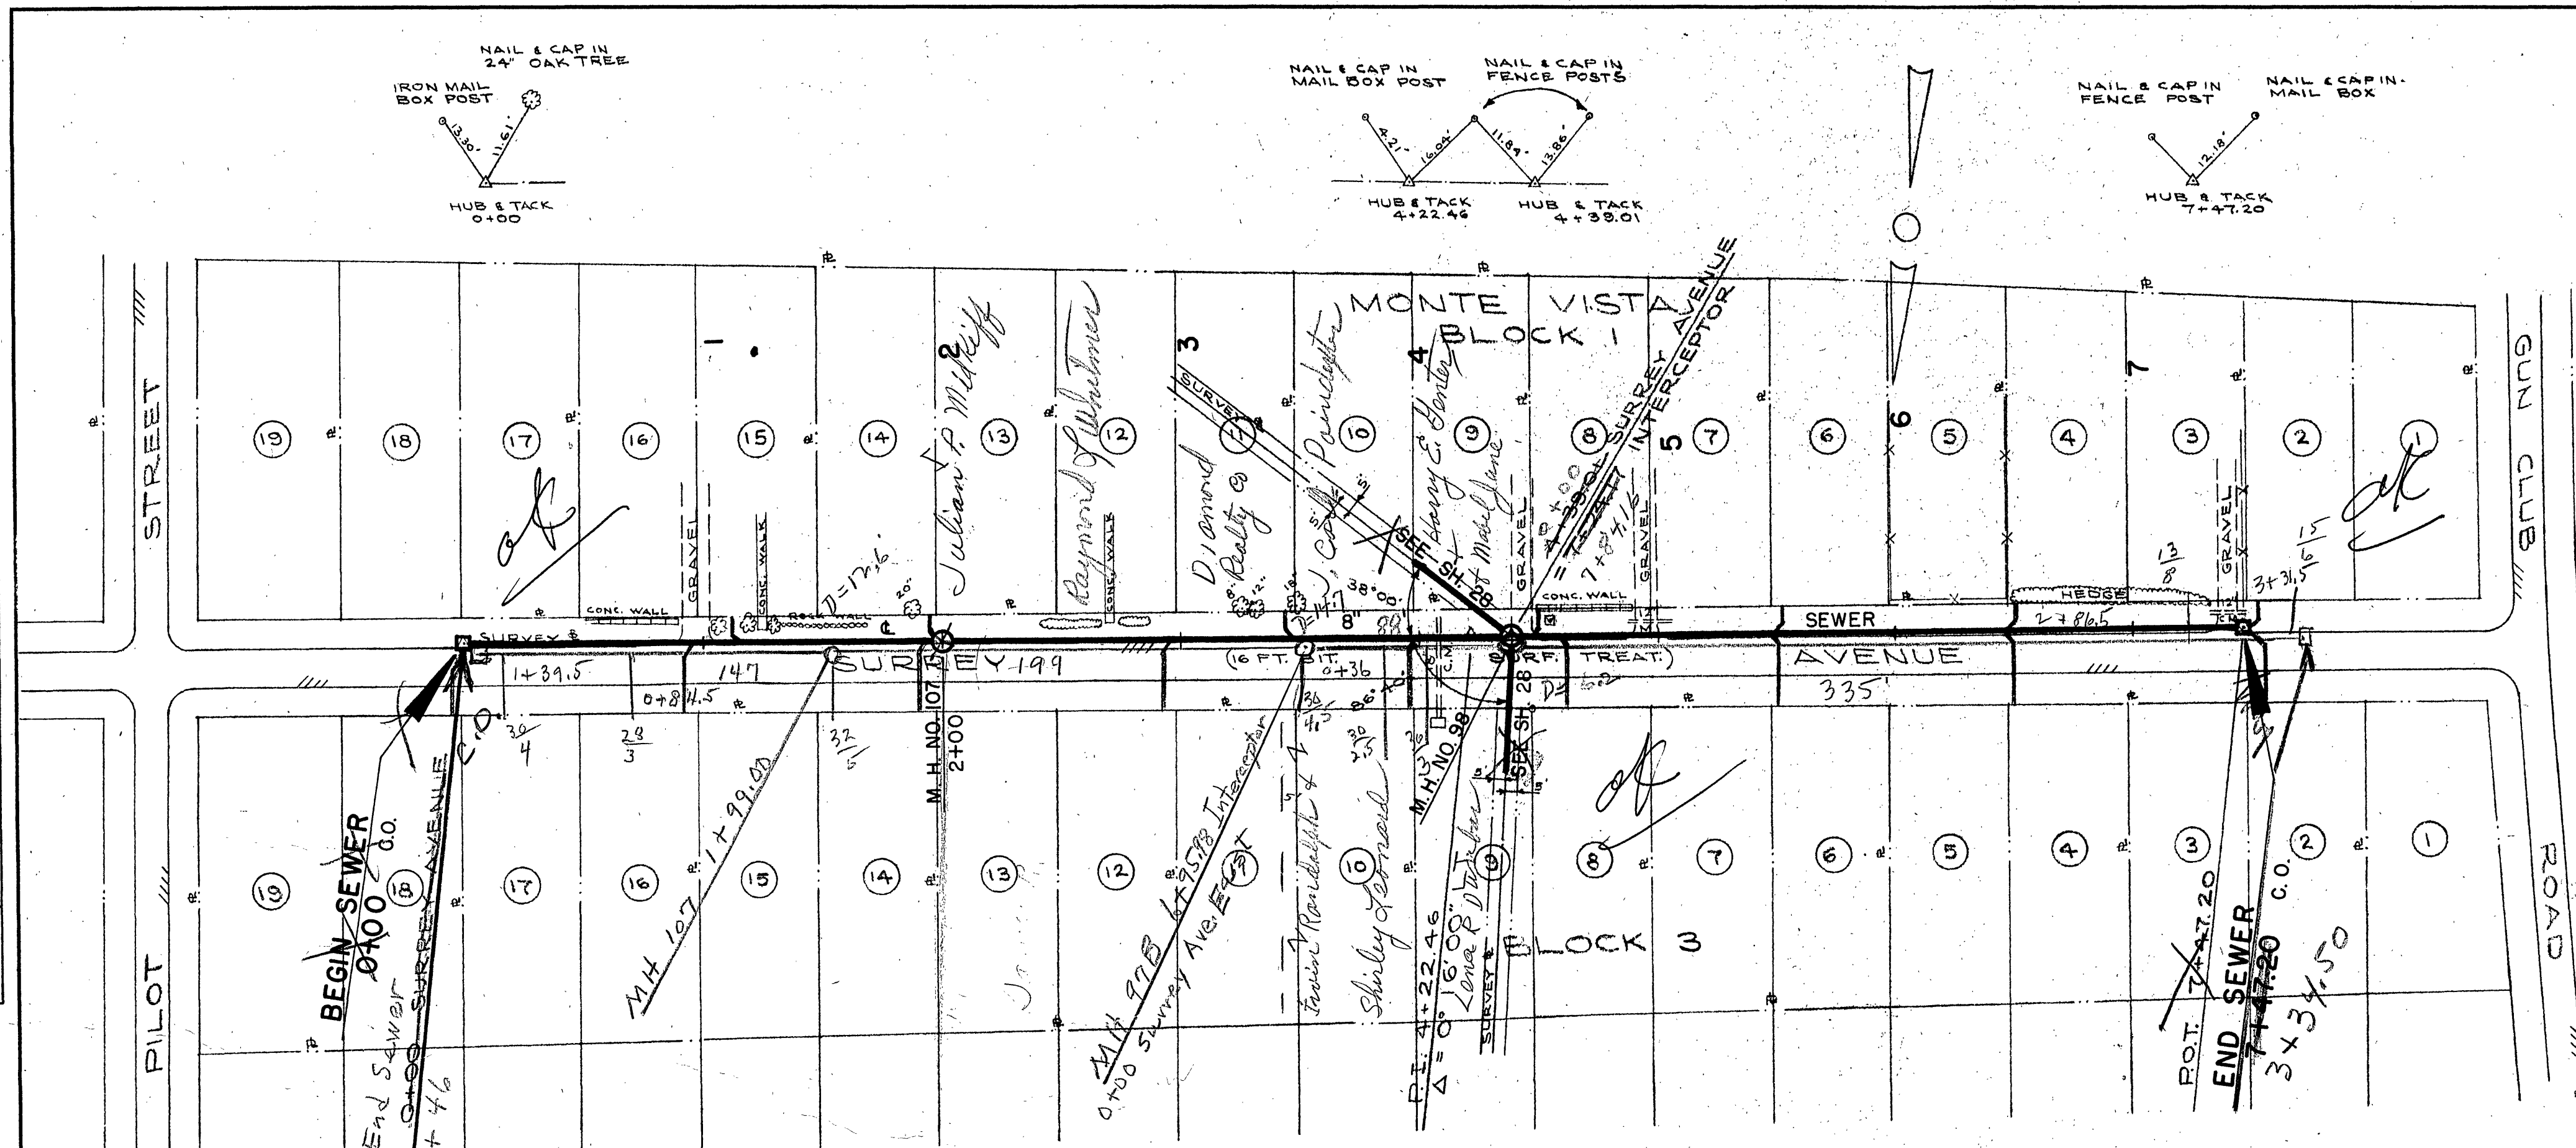


PLAN	SURVEYED	DATE
NOTE BOOK	PLOTTED	12/21/64
RT. OF WAY CHECKED	BY	R.E.B.
NO.		

PROFILE	SURVEYED	DATE
NOTE BOOK	PLOTTED	12/21/64
STRUCTURE NOTATIONS	BY	R.E.B.

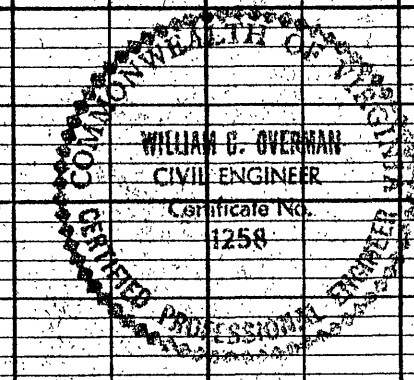

SCALE: 1/4" = 50 FT.

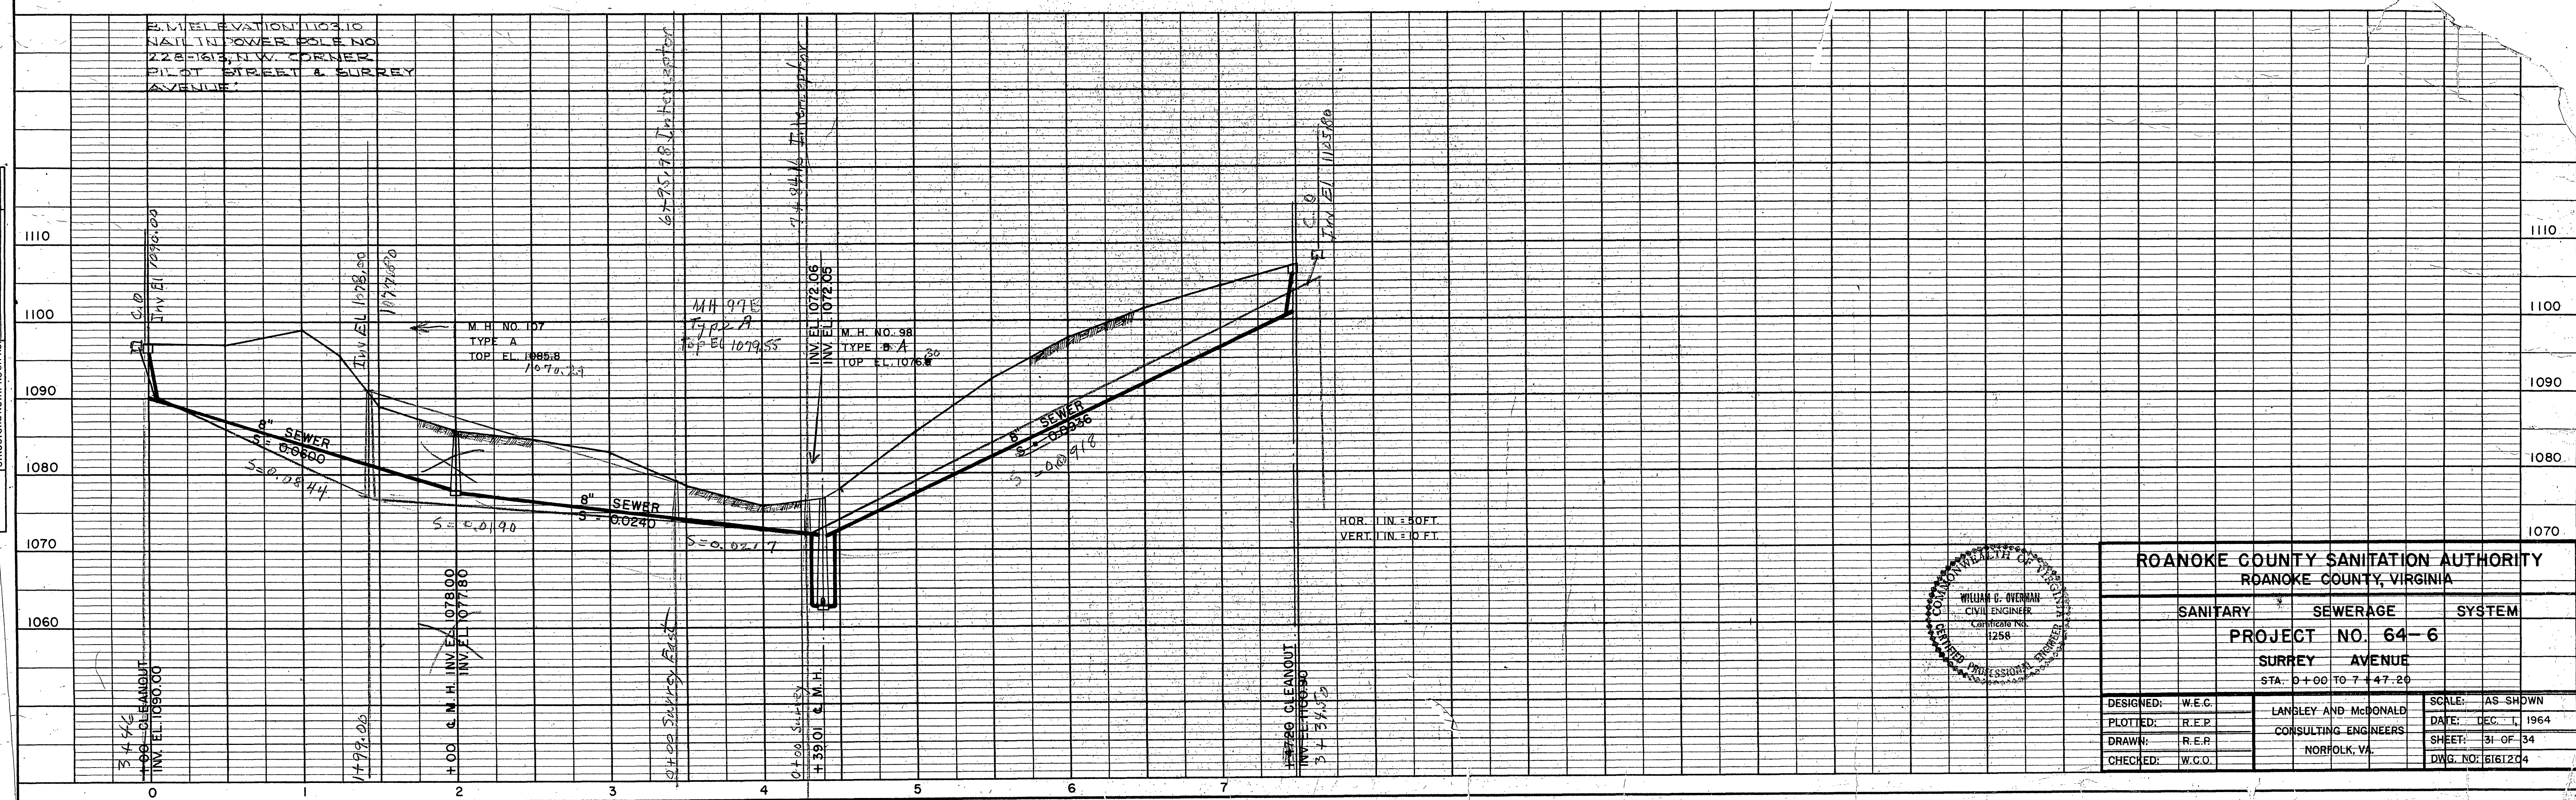

ROANOKE COUNTY SANITATION AUTHORITY ROANOKE COUNTY, VIRGINIA		
SANITARY	SEWERAGE	SYSTEM
PROJECT NO. 64-6		
SURREY AVENUE		
STA. 0+00 TO 7+47.20		
DESIGNED: W.E.C.	LANLEY AND McDONALD	SCALE: AS SHOWN
PLOTTED: R.E.P.	CONSULTING ENGINEERS	DATE: DEC. 1, 1964
DRAWN: R.E.P.	NORFOLK, VA.	SHEET: 31 OF 34
CHECKED: W.C.O.		DWG. NO: 6161204