

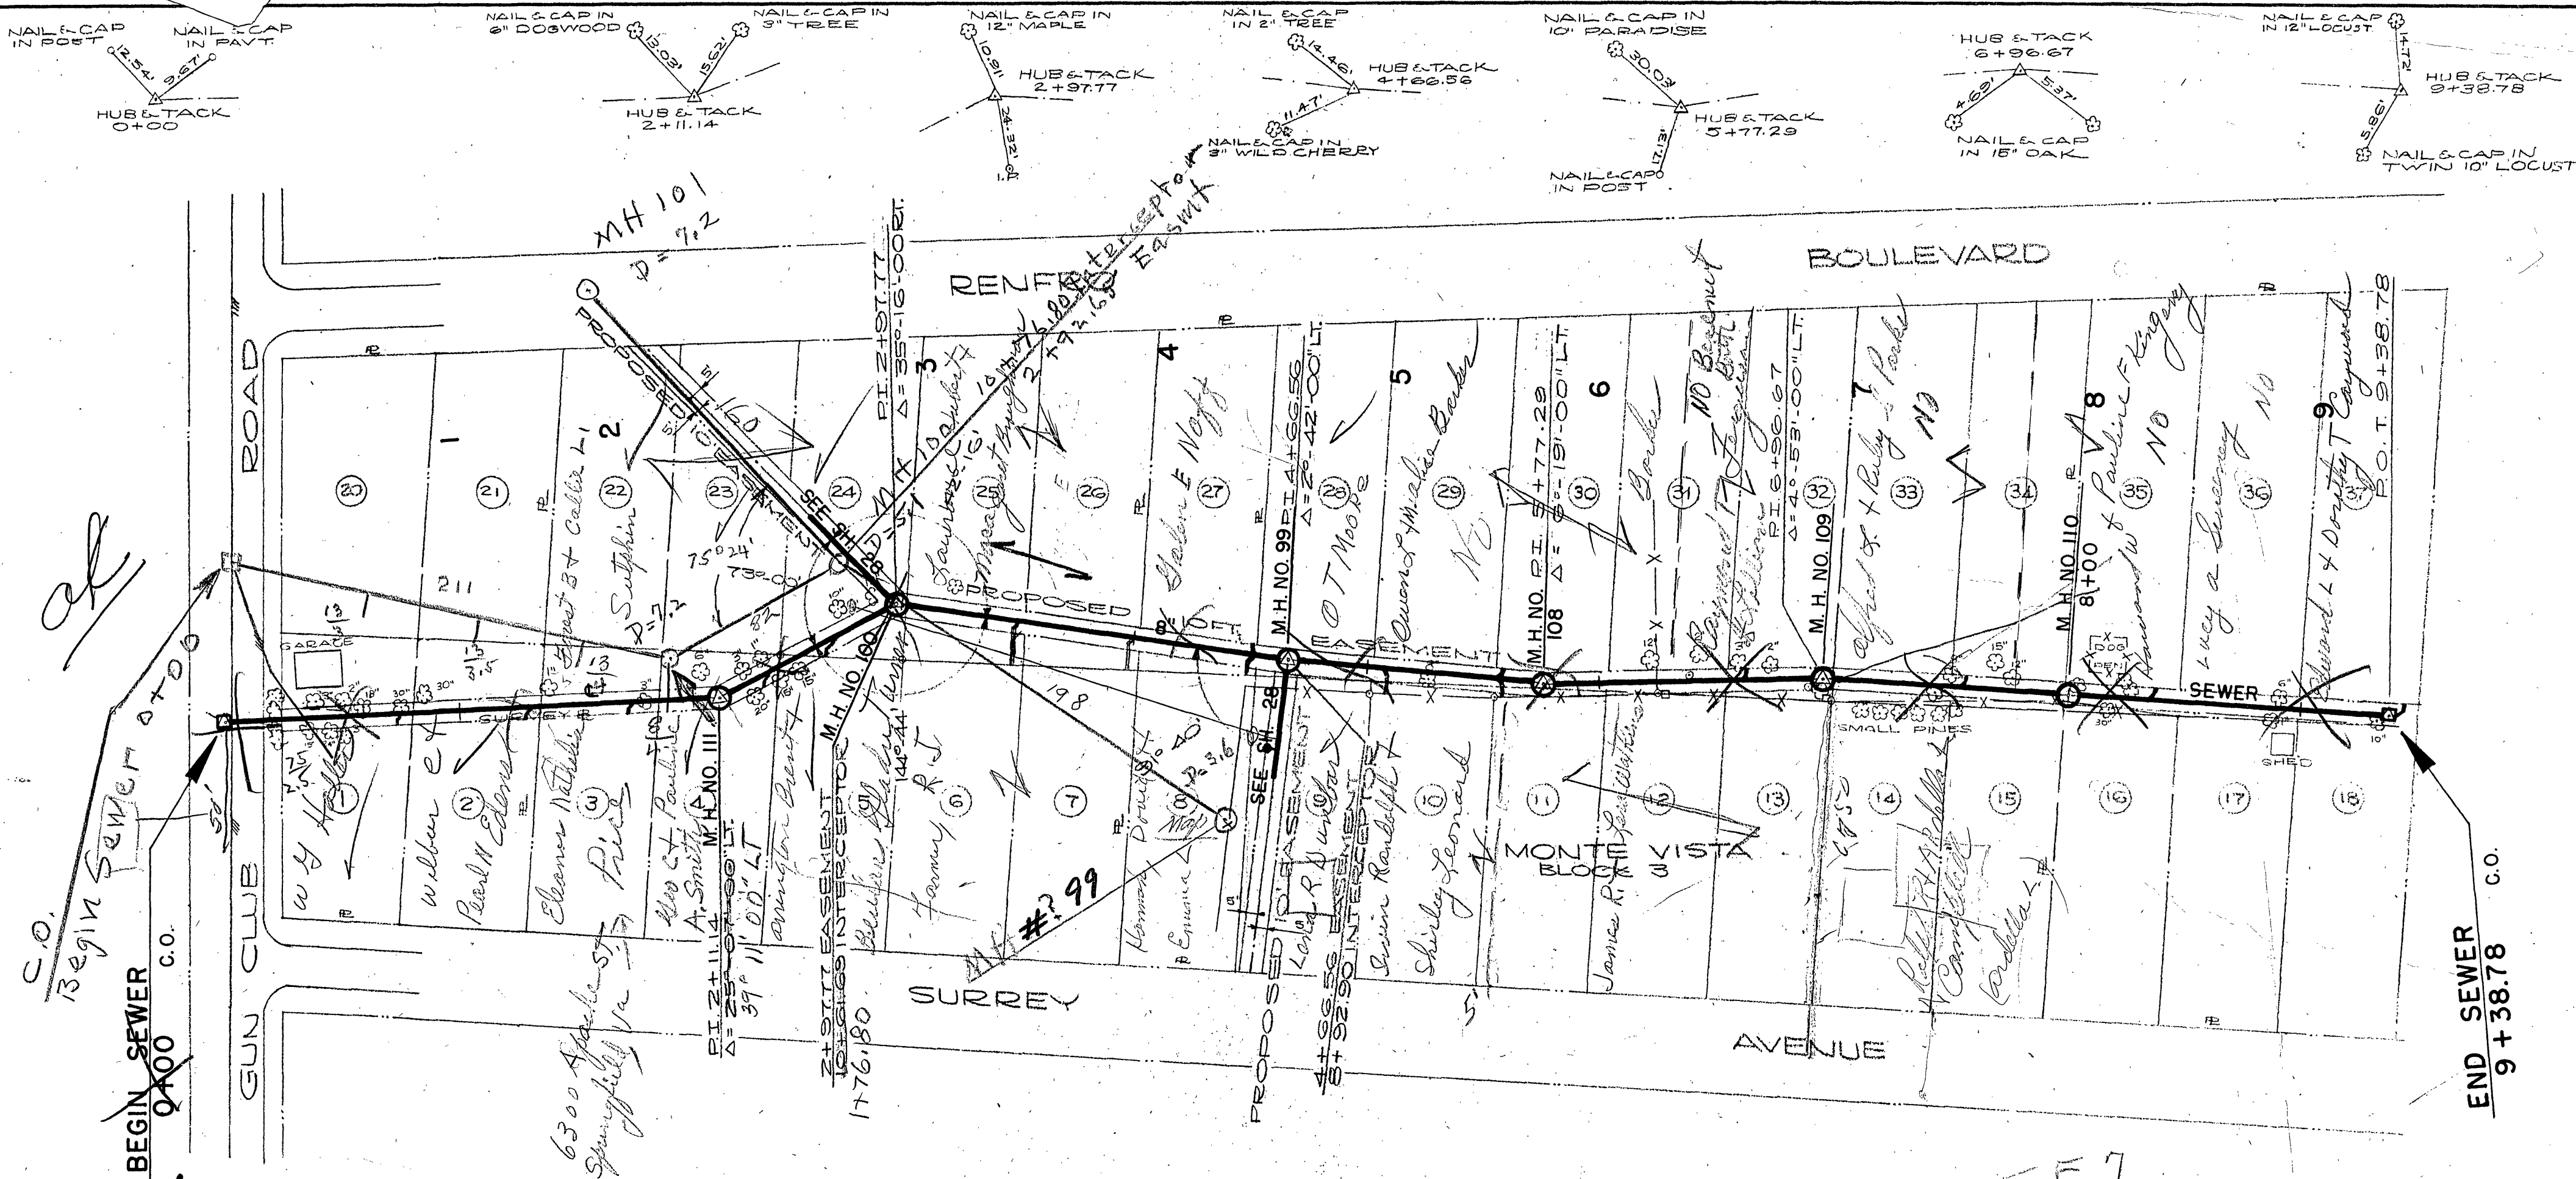


PLAN	NO.	DATE	BY	DATE	BY
SURVEYED					
ALIGNED					
RT. OF WAY CHECKED					
NO.					

PROFILE	NO.	DATE	BY	DATE	BY
SURVEYED					
GRADES CHECKED					
STRUCTURE NOTATIONS CH'NO.					
NO.					

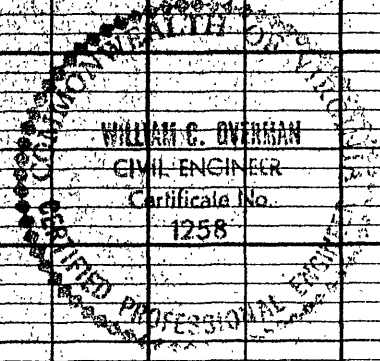

SCALE: 1 IN. = 50 FT.

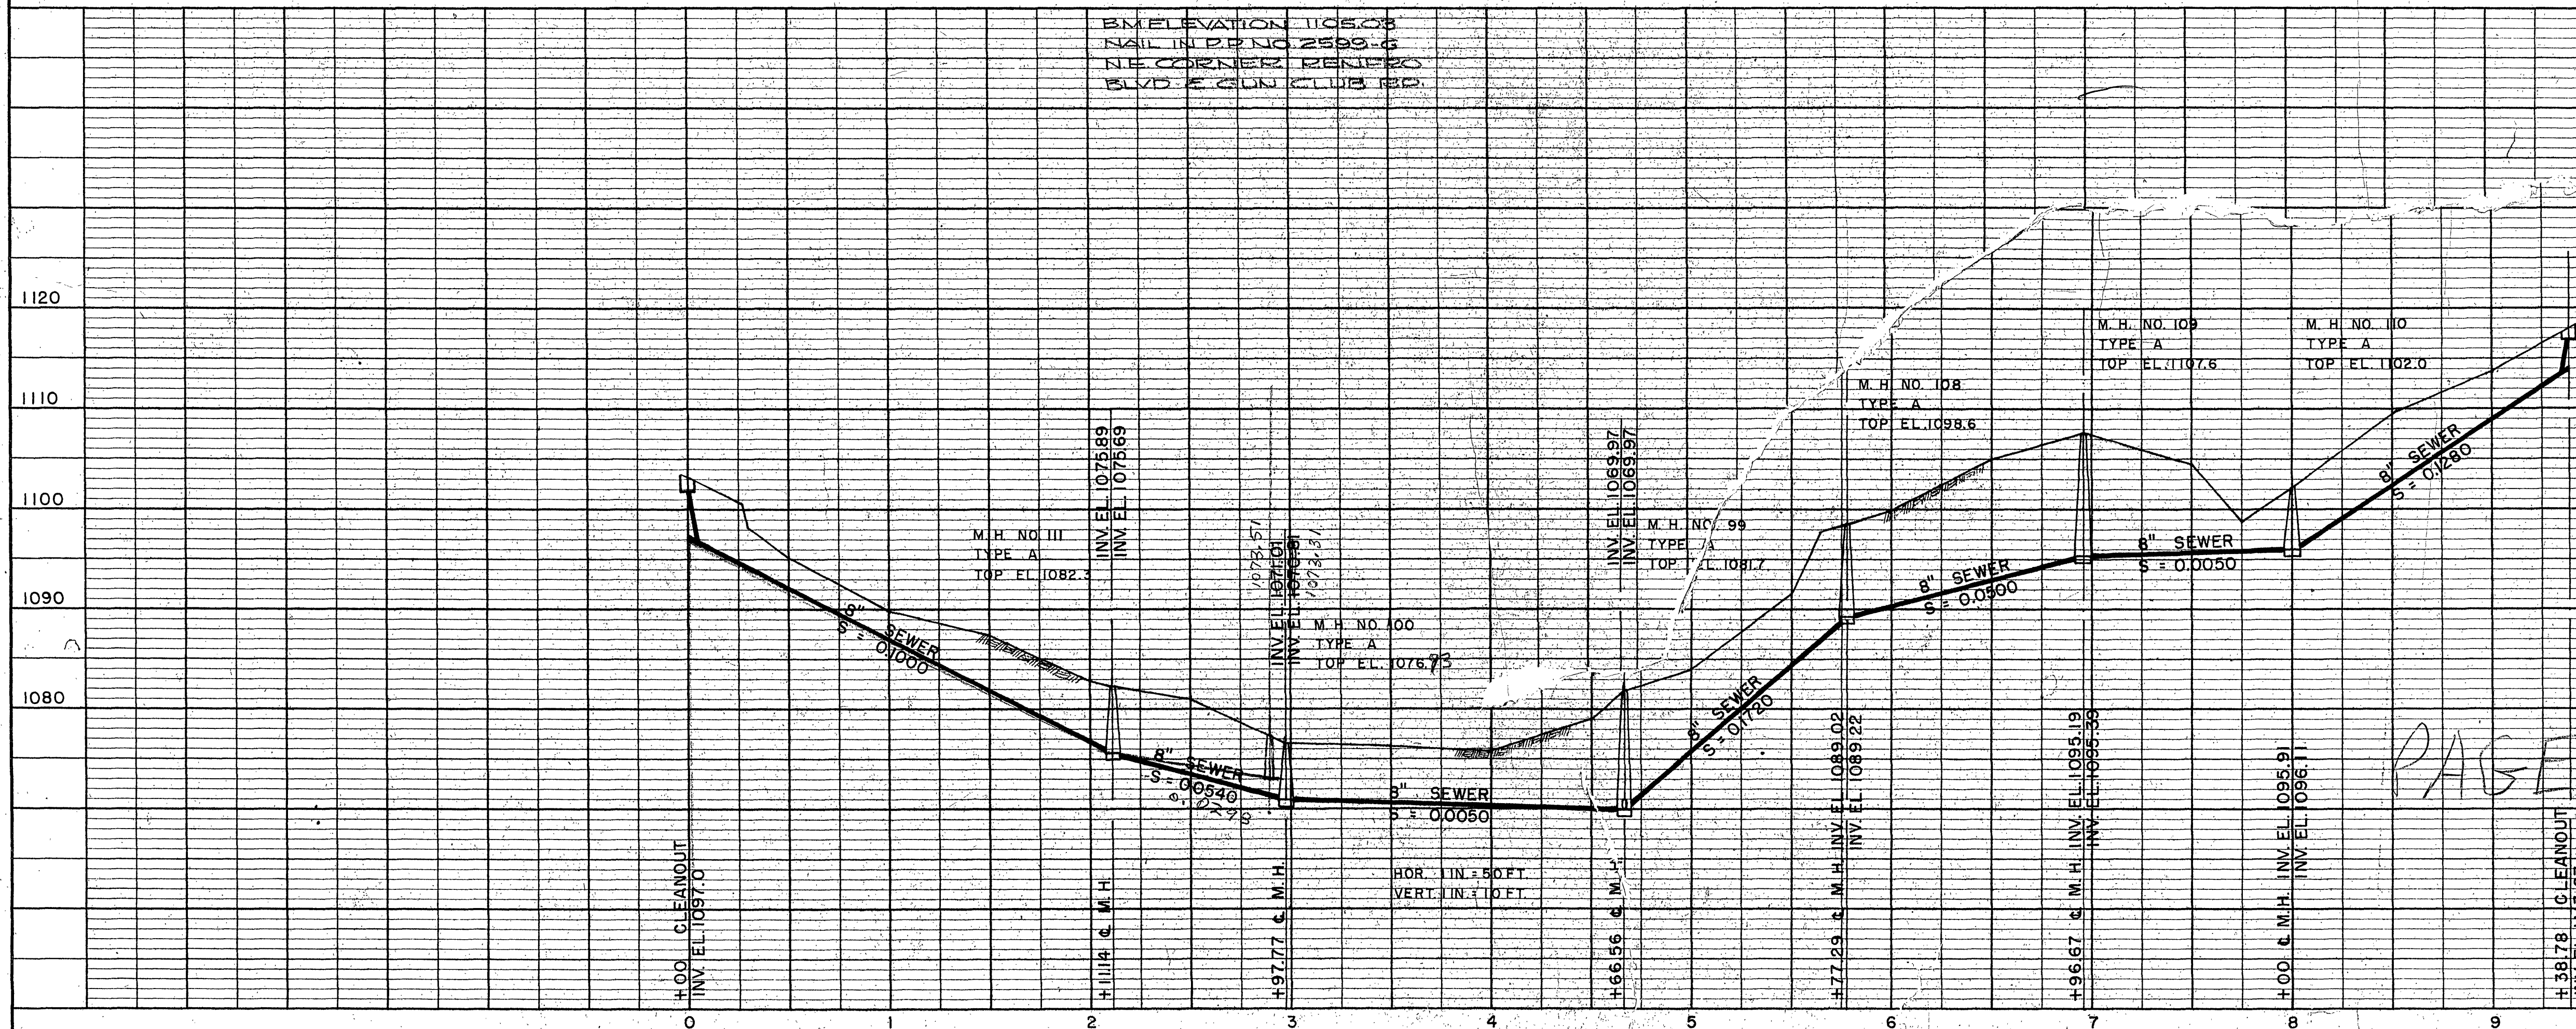

DESIGNED:	W.E.C.
PLOTTED:	T.D.H.
DRAWN:	T.D.H.
CHECKED:	W.E.C.

PAGE 32