


PLAN	DATE	BY	DATE	BY
SURVEYED	7-23-66	W.L.S.	7-23-66	W.L.S.
PLOTTED	8-24-66	J.L.S.	8-24-66	J.L.S.
NOTE BOOK				
NO.				

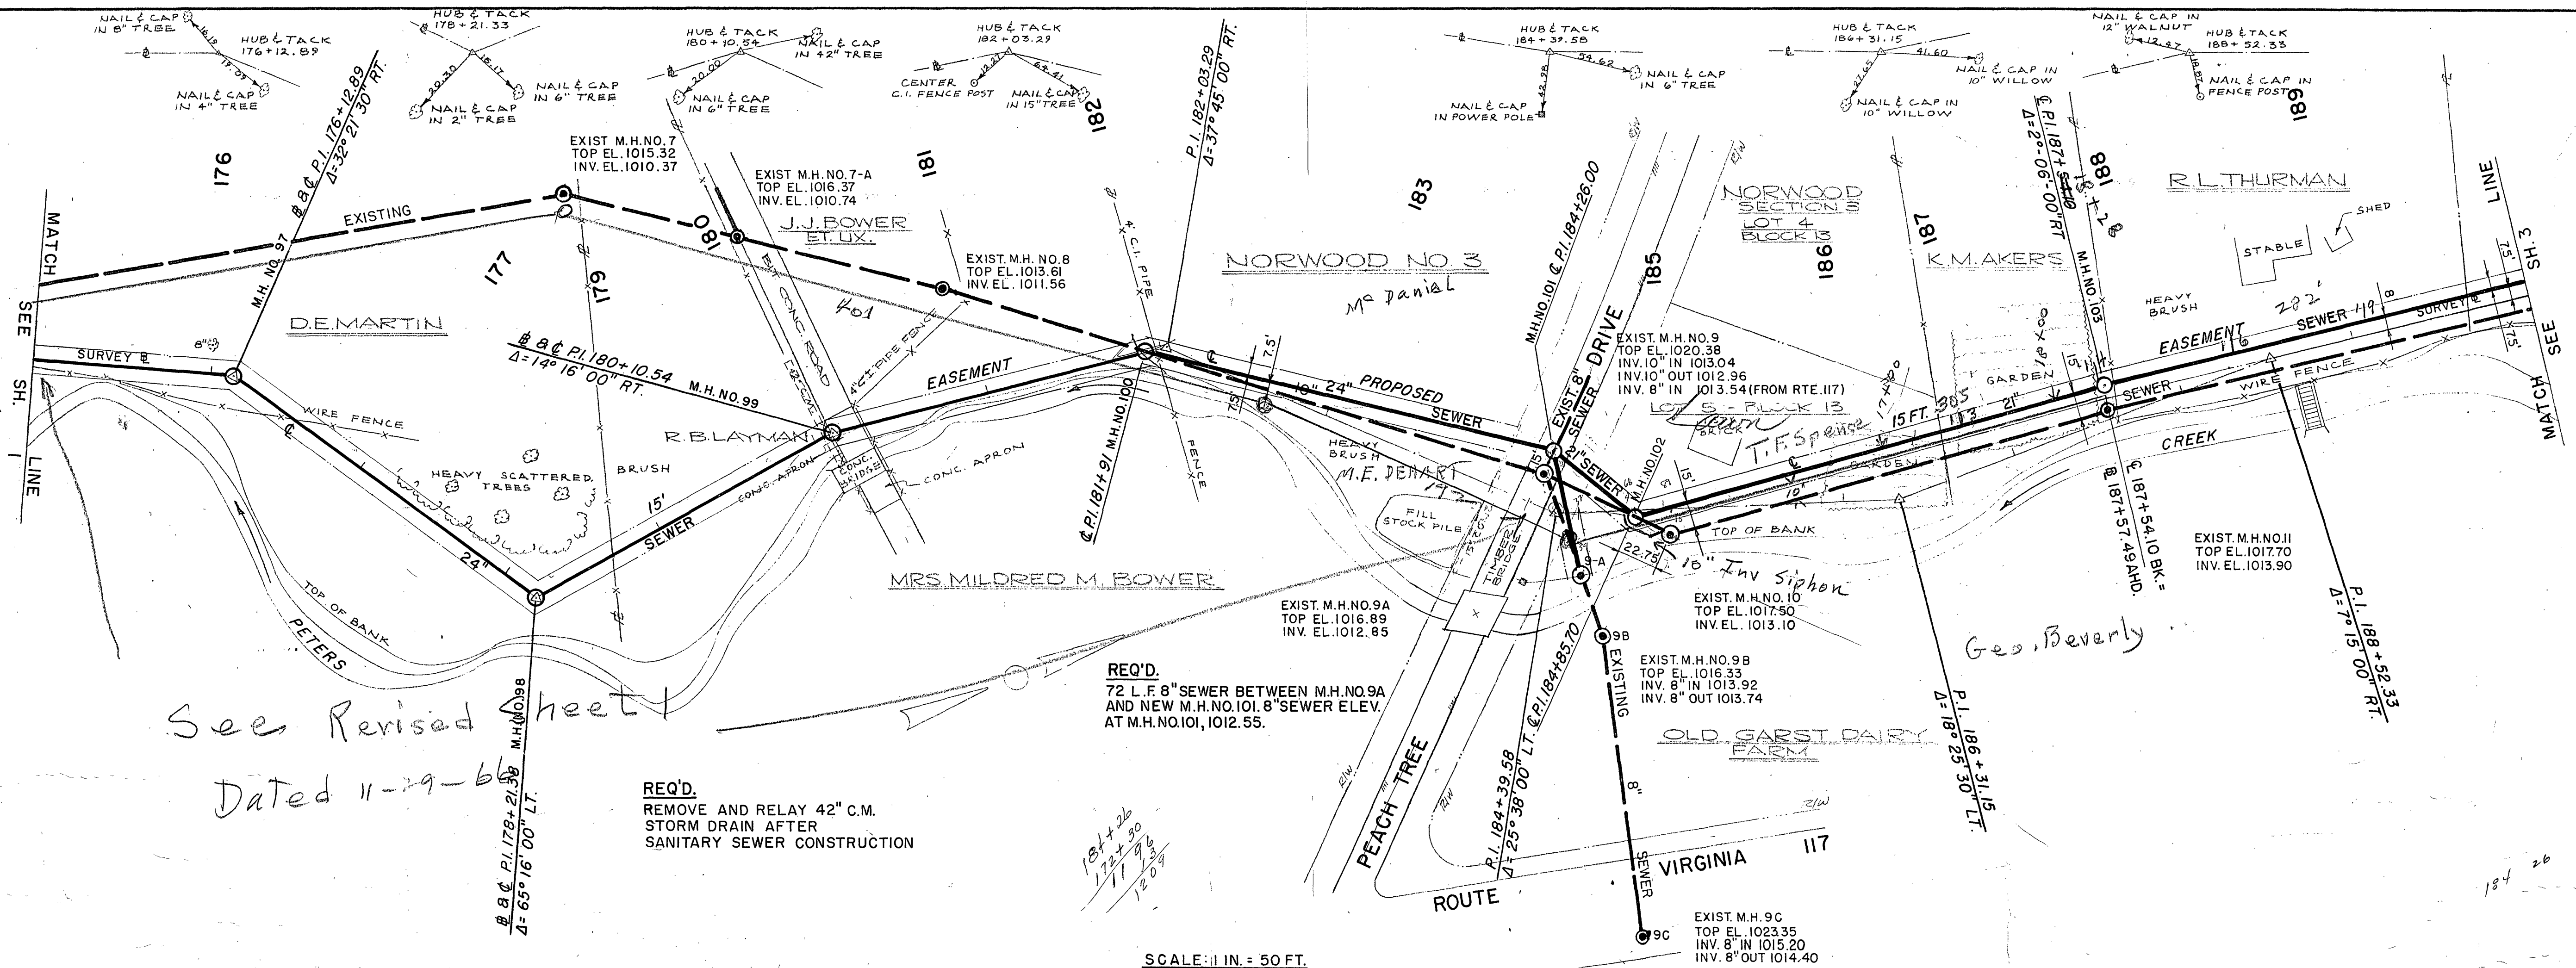

See Revised Sheet
Dated 11-19-66


REQ'D.
REMOVE AND RELAY 42\"/>

REQ'D.
72\"/>

181+26
172+30
111+96
120+9

SCALE: 1 IN. = 50 FT.

PROFILE	DATE	BY	DATE	BY
SURVEYED	7-23-66	W.L.S.	7-23-66	W.L.S.
PLOTTED	8-24-66	J.L.S.	8-24-66	J.L.S.
NOTE BOOK				
NO.				

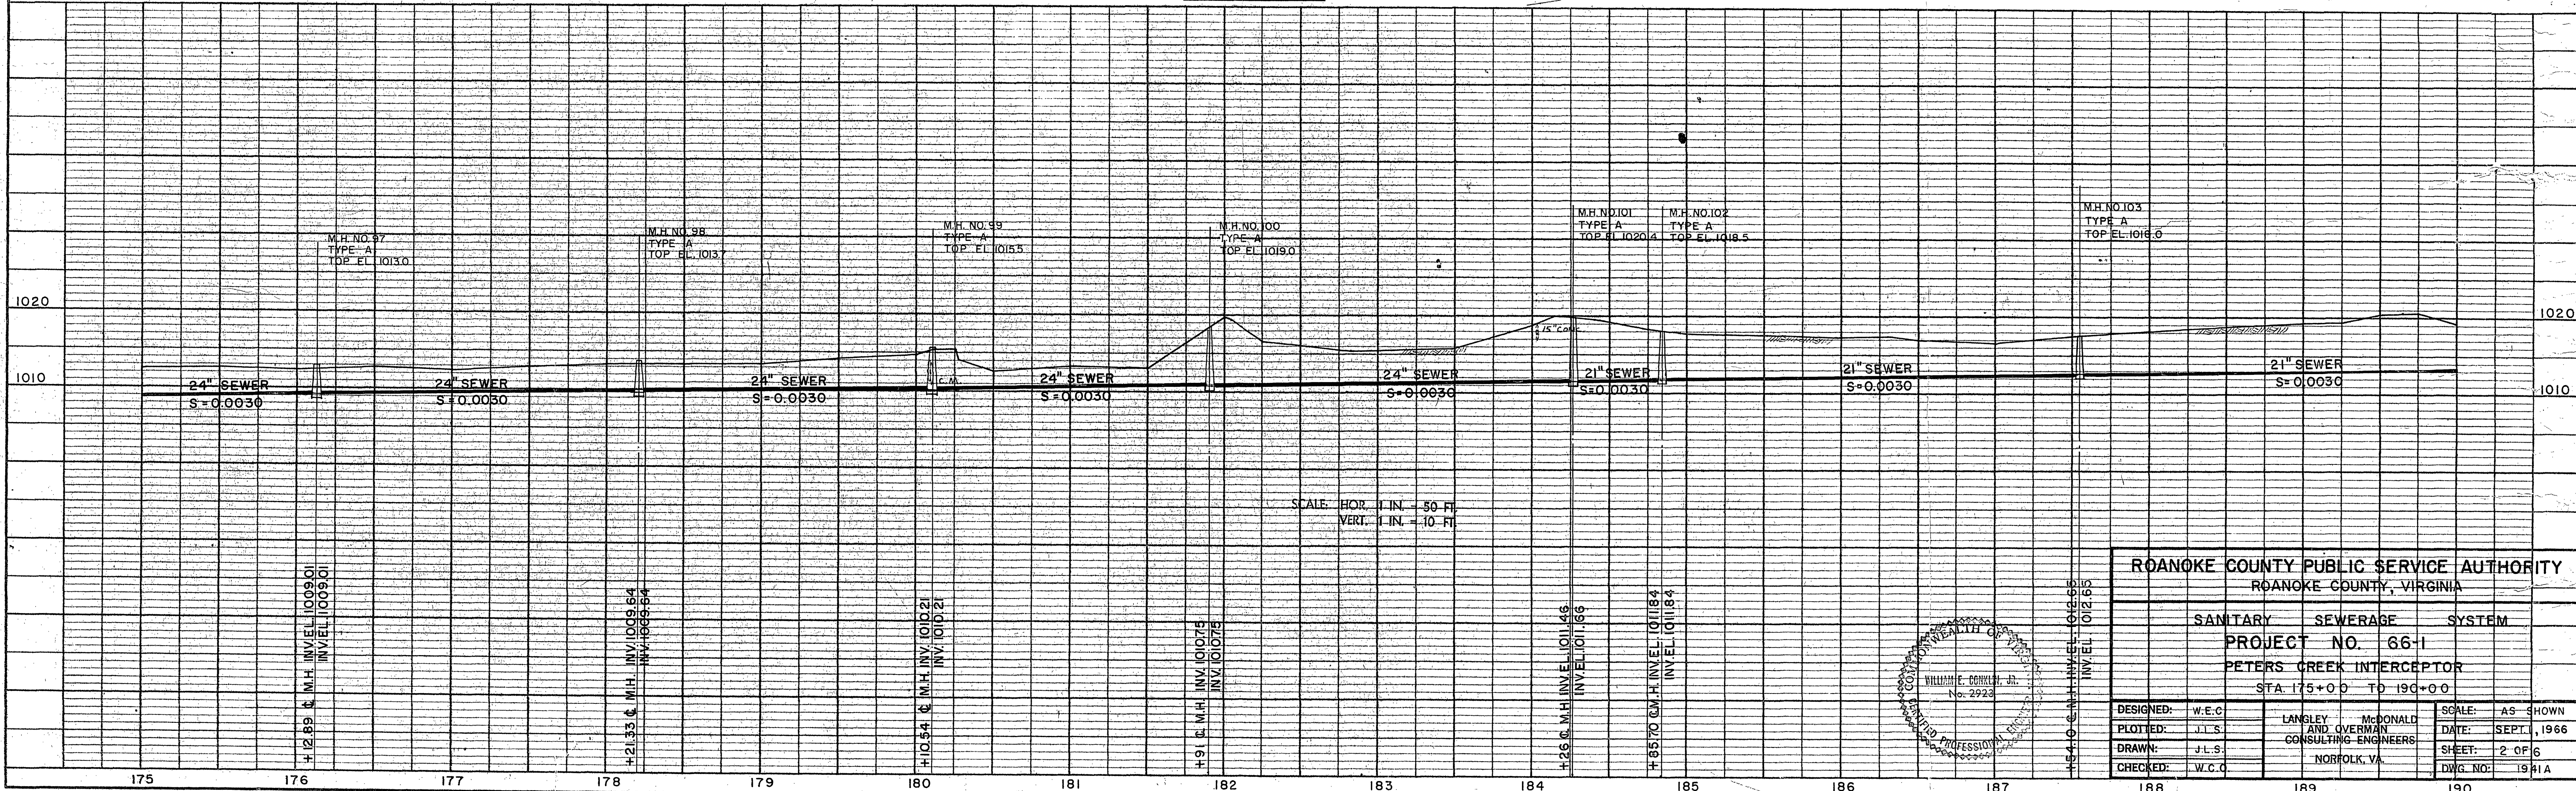

SCALE: HOR. 1 IN. = 50 FT.
VERT. 1 IN. = 10 FT.

ROANOKE COUNTY PUBLIC SERVICE AUTHORITY ROANOKE COUNTY, VIRGINIA			
SANITARY SEWERAGE SYSTEM			
PROJECT NO. 66-1			
PETERS CREEK INTERCEPTOR			
STA. 175+00 TO 190+00			
DESIGNED:	W.E.C.	LANGLEY, McDONALD AND OVERMAN CONSULTING ENGINEERS NORFOLK, VA.	SCALE: AS SHOWN DATE: SEPT., 1966 SHEET: 2 OF 6 DWG. NO.: 19#1A
PLOTTED:	J.L.S.		
DRAWN:	J.L.S.		
CHECKED:	W.C.O.		