
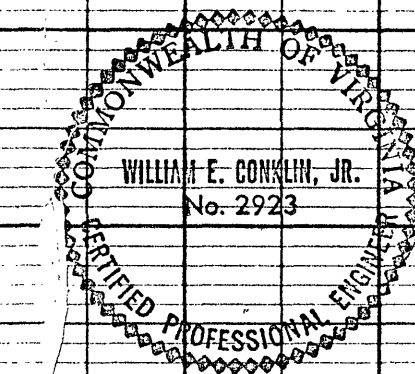
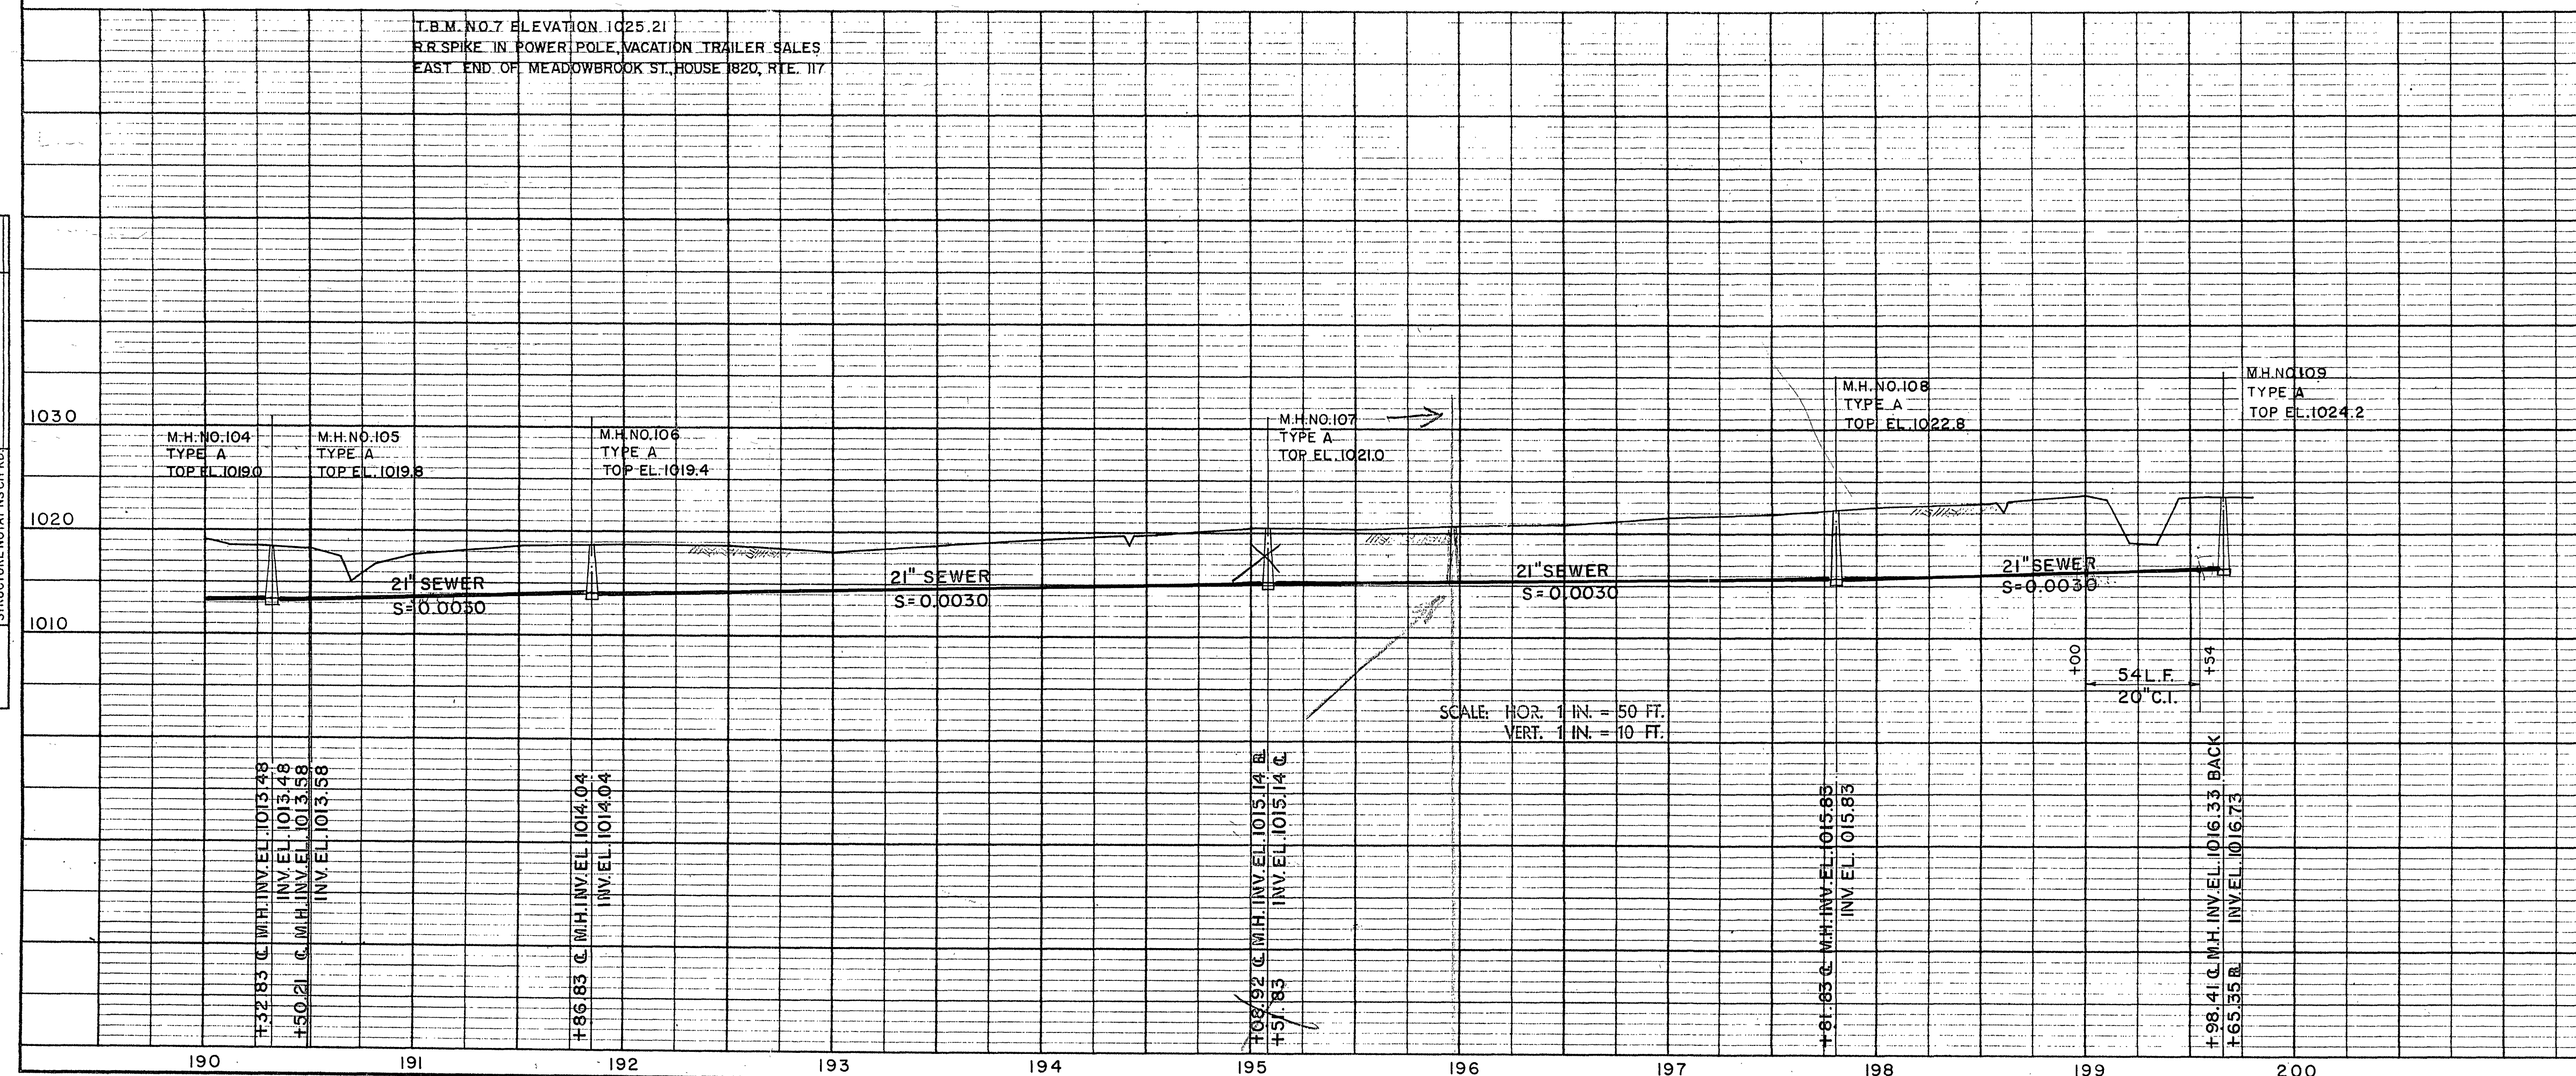


PLAN	DATE	BY	W.S.	DATE	BY
SURVEYED	7-23-56	J.L.S.			
NOTED	8-23-56	J.L.S.			
NOTE BOOK					
NO.					

PROFILE	DATE	BY	W.S.	DATE	BY
SURVEYED	7-23-56	J.L.S.			
NOTED	8-23-56	J.L.S.			
NOTE BOOK					
NO.					

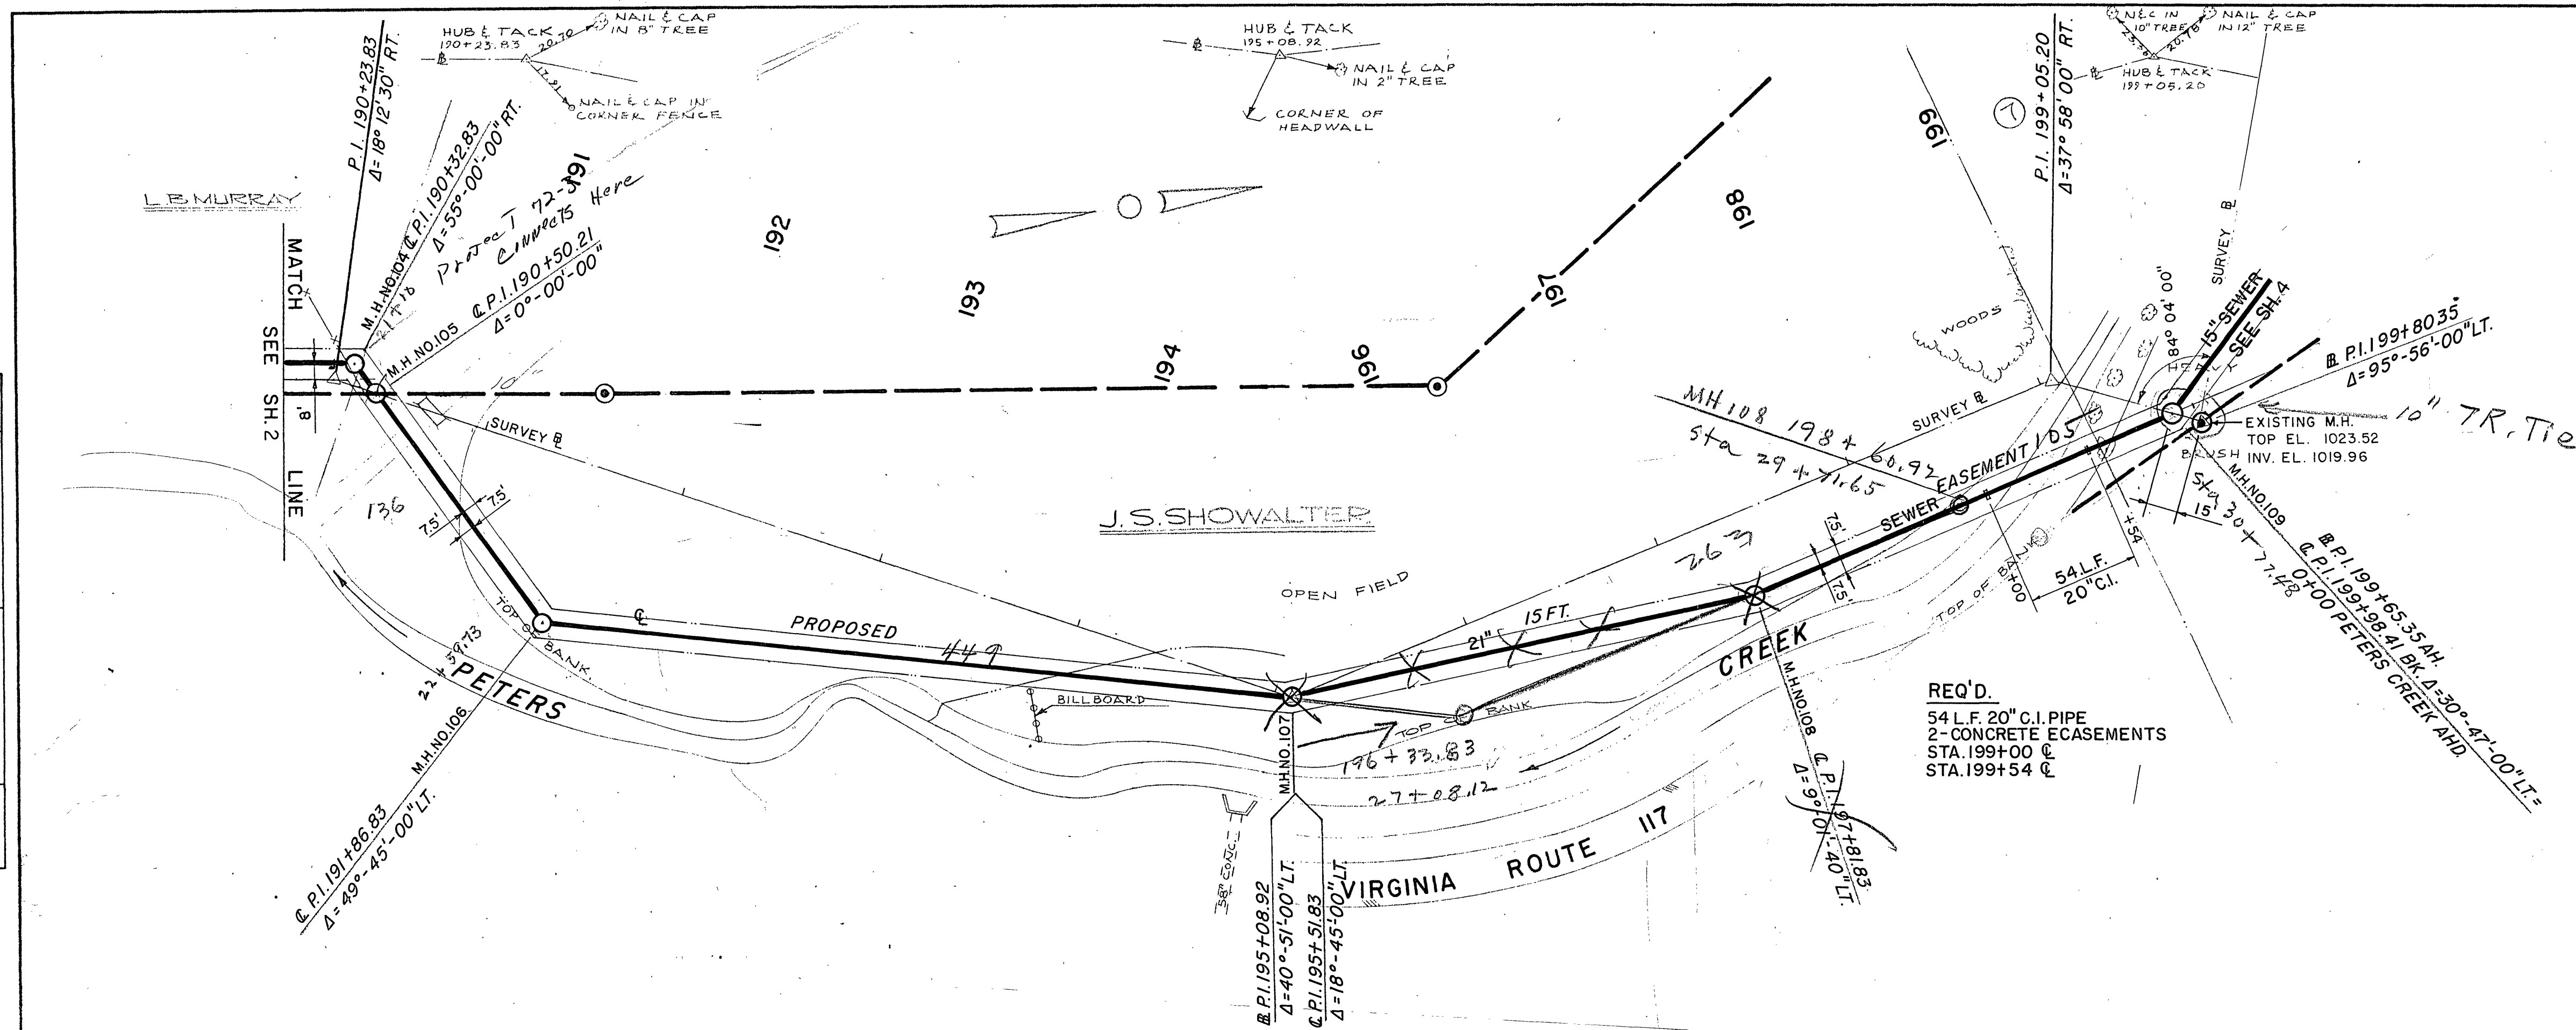

ROANOKE COUNTY PUBLIC SERVICE AUTHORITY				
ROANOKE COUNTY, VIRGINIA				
SANITARY SEWERAGE SYSTEM				
PROJECT NO. 66-1				
PETERS CREEK INTERCEPTOR				
STA. 190+00 TO 199+50.35				
DESIGNED:	W. E. C.	LANGLEY, McDONALD & OVERMAN		SCALE: AS SHOWN
PLOTTED:	J. L. S.	CONSULTING ENGINEERS		DATE: SEPT. 1, 1956
DRAWN:	J. L. S.	NORFOLK, VA.		SHEET: 3 OF 6
CHECKED:	W. C. O.			DWG. NO: 1942