



PLAN	DATE
SURVEYED	10/3
PLOTTED	11/12
ALIGNMENT CHECKED	11/12
RT. OF WAY CHECKED	11/12
NO.	

PROFILE	DATE
SURVEYED	10/3
GRADES CHECKED	11/12
B. M. NOTED	11/12
STRUCTURE NOTATIONS CHECKED	11/12
NO.	

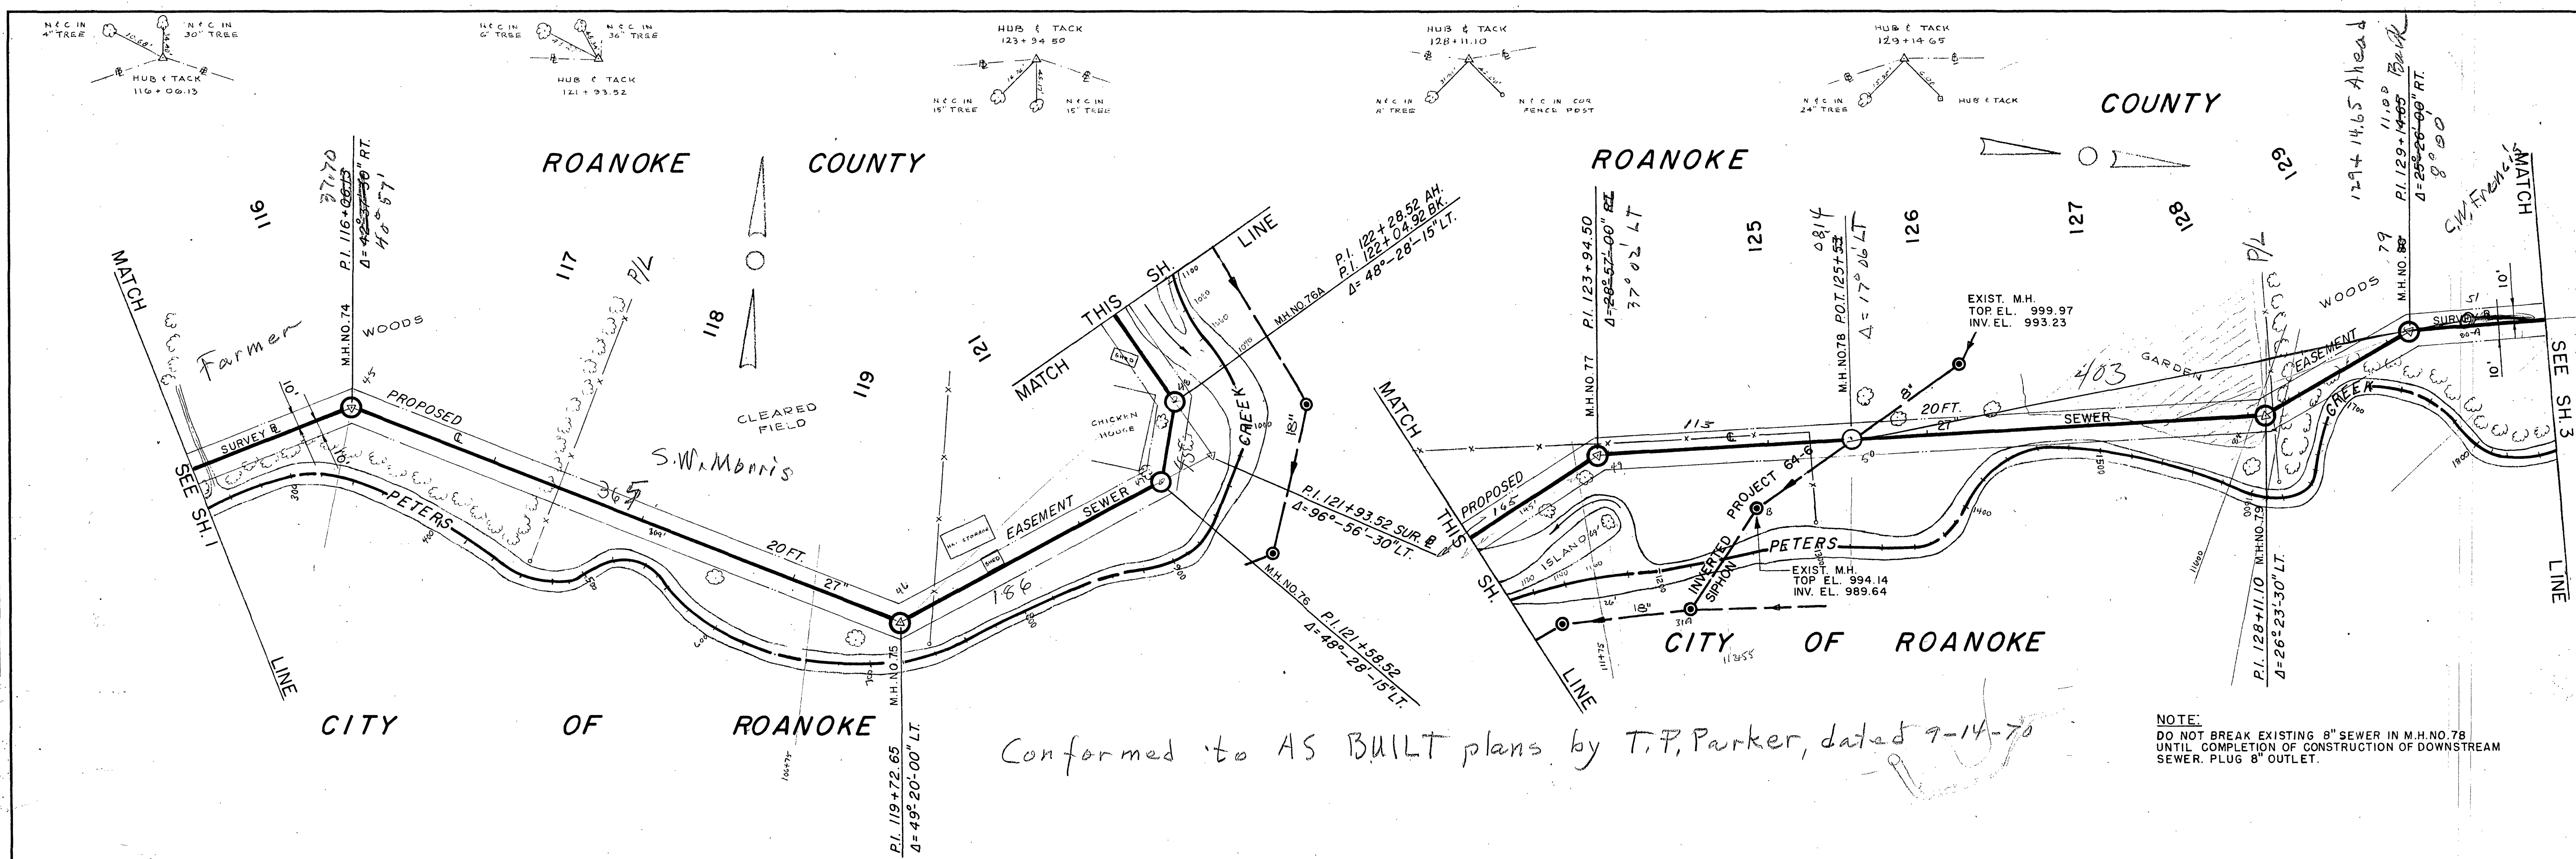

NOTE:
DO NOT BREAK EXISTING 8" SEWER IN M.H. NO. 78
UNTIL COMPLETION OF CONSTRUCTION OF DOWNSTREAM
SEWER. PLUG 8" OUTLET.

SCALE: 1 IN. = 50 FT.

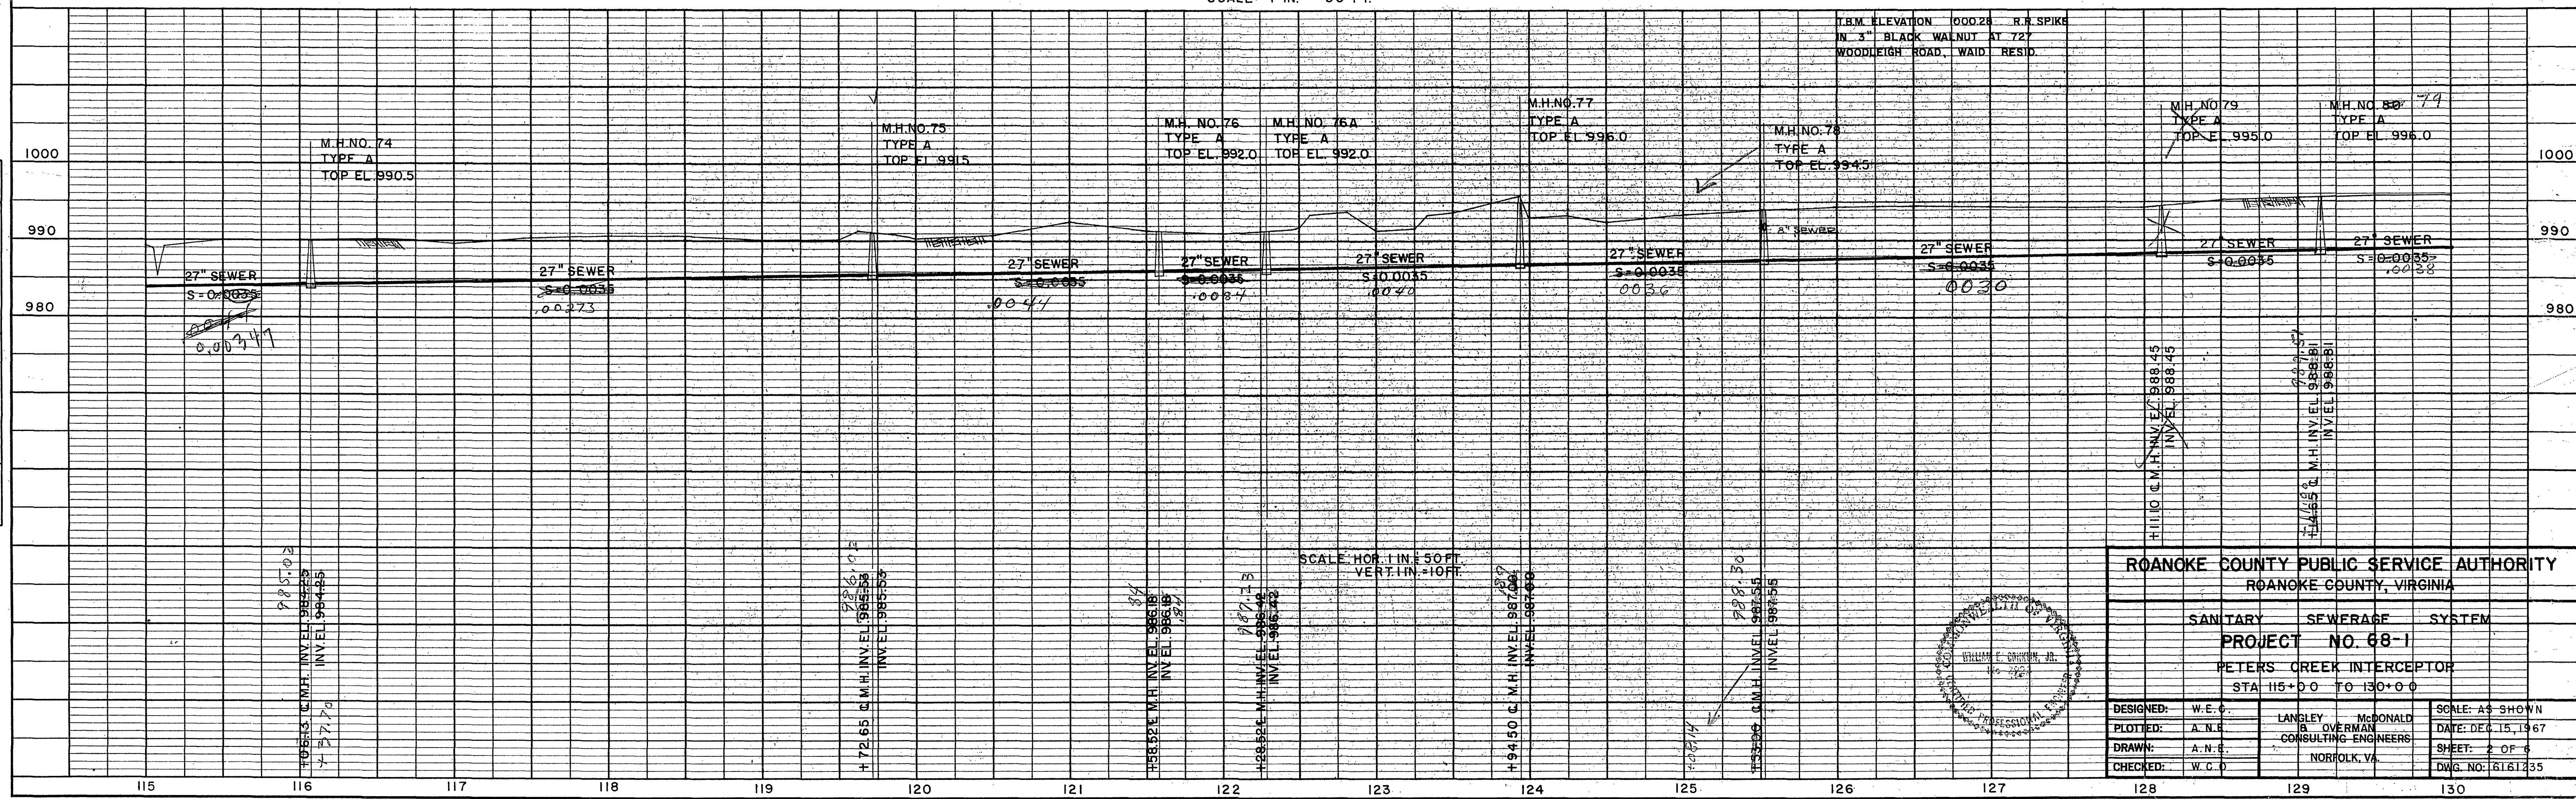

ROANOKE COUNTY PUBLIC SERVICE AUTHORITY ROANOKE COUNTY, VIRGINIA		
SANITARY	SEWERAGE	SYSTEM
PROJECT NO. 68-1		
PETERS CREEK INTERCEPTOR		
STA 115+00 TO 130+00		
DESIGNED: W.E.C.	LANGLEY & McDONALD	SCALE: AS SHOWN
PLOTTED: A.N.E.	OVERMAN	DATE: DEC. 15, 1967
DRAWN: A.N.E.	CONSULTING ENGINEERS	SHEET: 2 OF 6
CHECKED: W.C.D.	NORFOLK, VA.	DWG. NO. 6161235