



PLAN	DATE	BY
SURVEYED	5/1/72	W.L.S.
NOTE BOOK		
NO.		

PROFILE	DATE	BY
SURVEYED	5/1/72	W.L.S.
NOTE BOOK		
NO.		

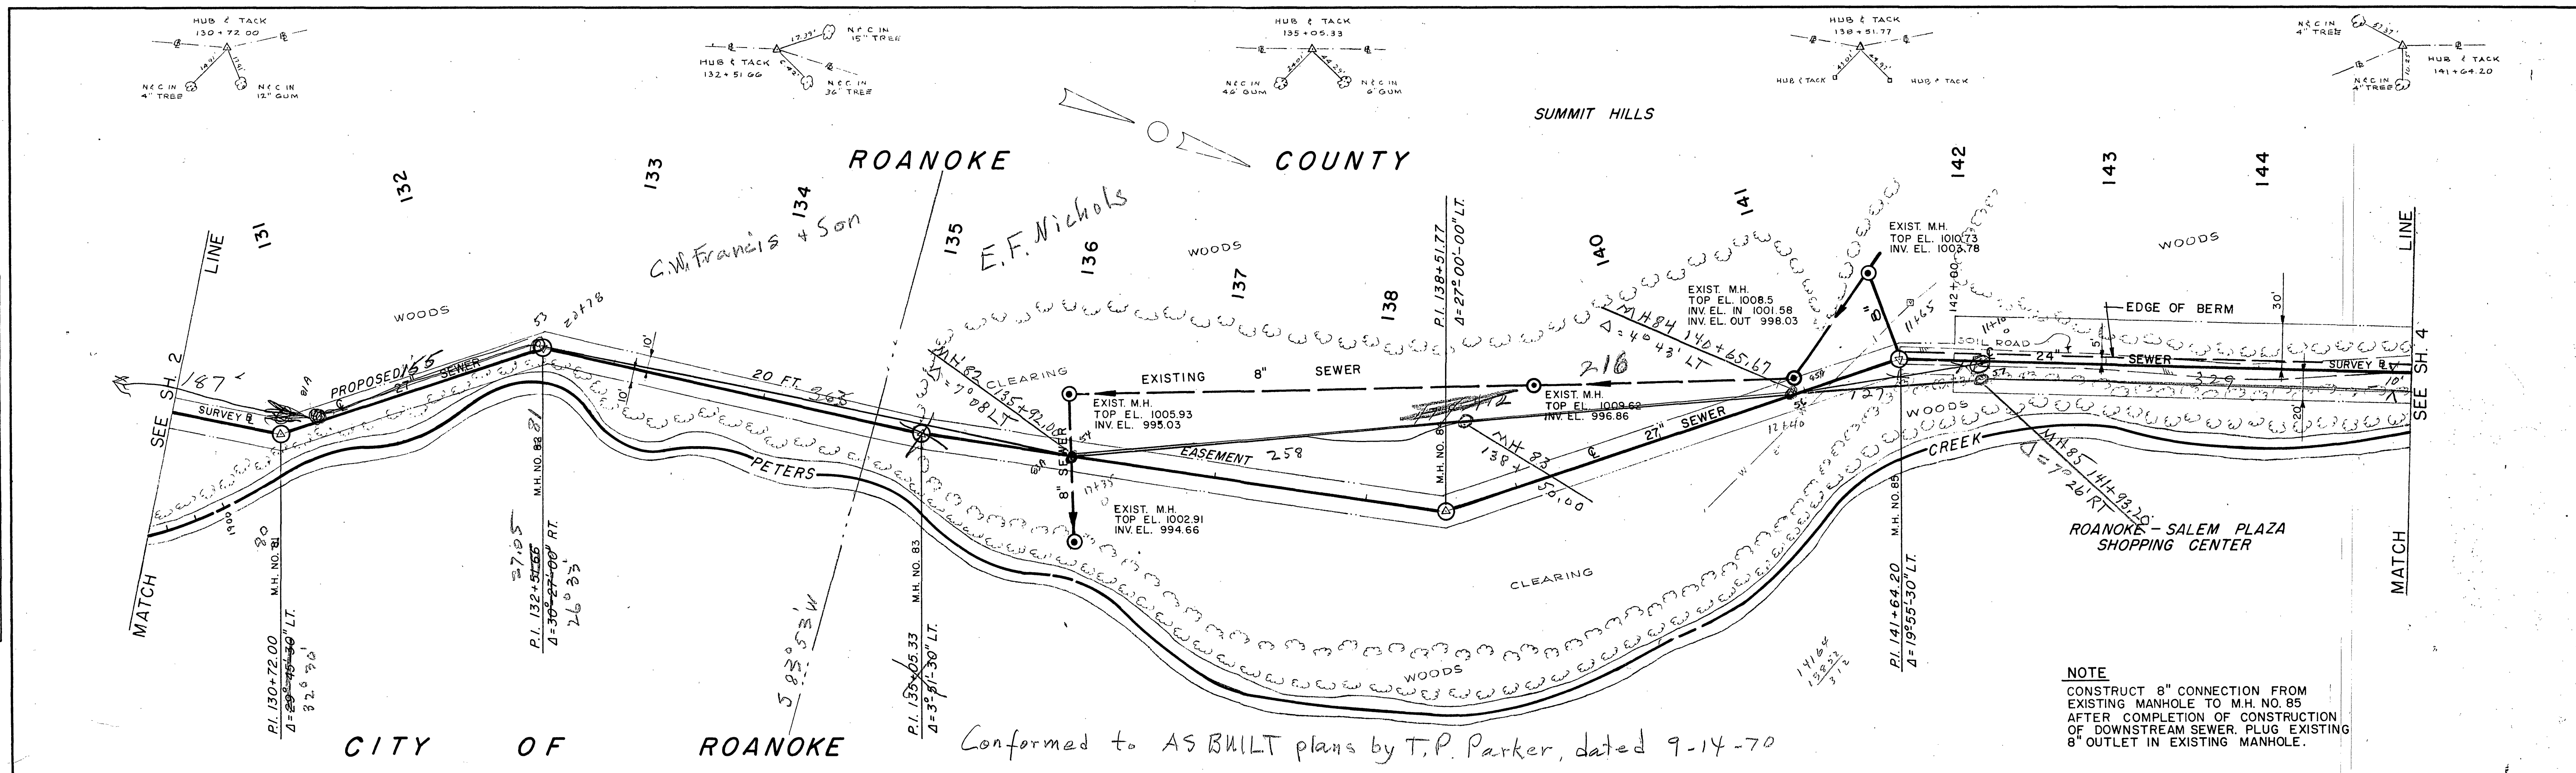

NOTE
 CONSTRUCT 8" CONNECTION FROM
 EXISTING MANHOLE TO M.H. NO. 85
 AFTER COMPLETION OF CONSTRUCTION
 OF DOWNSTREAM SEWER. PLUG EXISTING
 8" OUTLET IN EXISTING MANHOLE.

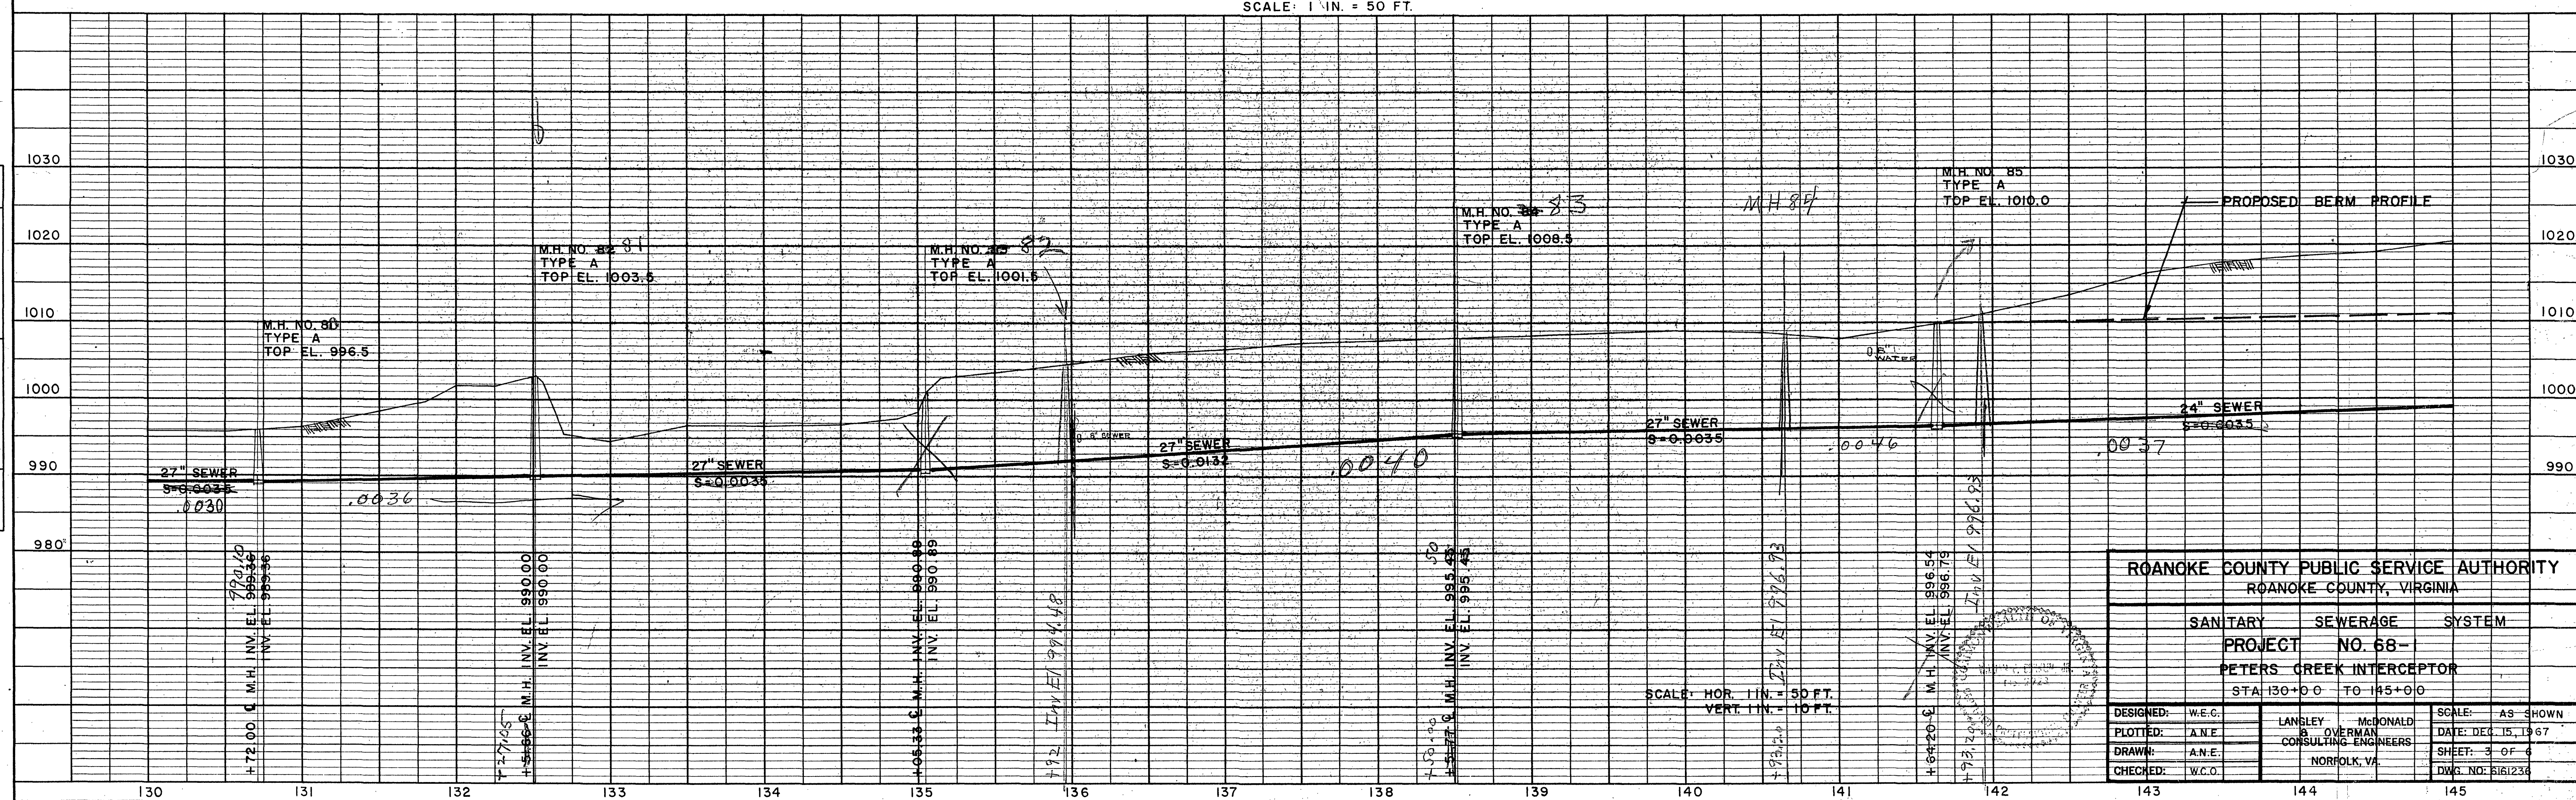

ROANOKE COUNTY PUBLIC SERVICE AUTHORITY ROANOKE COUNTY, VIRGINIA			
SANITARY		SEWERAGE	
SYSTEM			
PROJECT NO. 68-			
PETERS CREEK INTERCEPTOR			
STA 130+00 TO 145+00			
DESIGNED:	W.E.C.	LANSLEY	McDONALD
PLOTTED:	A.N.E.	OVERMAN	CONSULTING ENGINEERS
DRAWN:	A.N.E.	NORFOLK, VA.	
CHECKED:	W.C.O.		
SCALE:	AS SHOWN	DATE:	DEC. 15, 1967
		SHEET:	3 OF 4
		DWG. NO.:	6161236