


DATE	BY	DATE	BY
5-12-66	W.S.	5-12-66	W.S.
5-24-66	G.E.R.	5-24-66	G.E.R.
NO.		NO.	

DATE	BY	DATE	BY
5-12-66	W.S.	5-12-66	W.S.
5-24-66	G.E.R.	5-24-66	G.E.R.
NO.		NO.	

DATE	BY	DATE	BY
5-12-66	W.S.	5-12-66	W.S.
5-24-66	G.E.R.	5-24-66	G.E.R.
NO.		NO.	

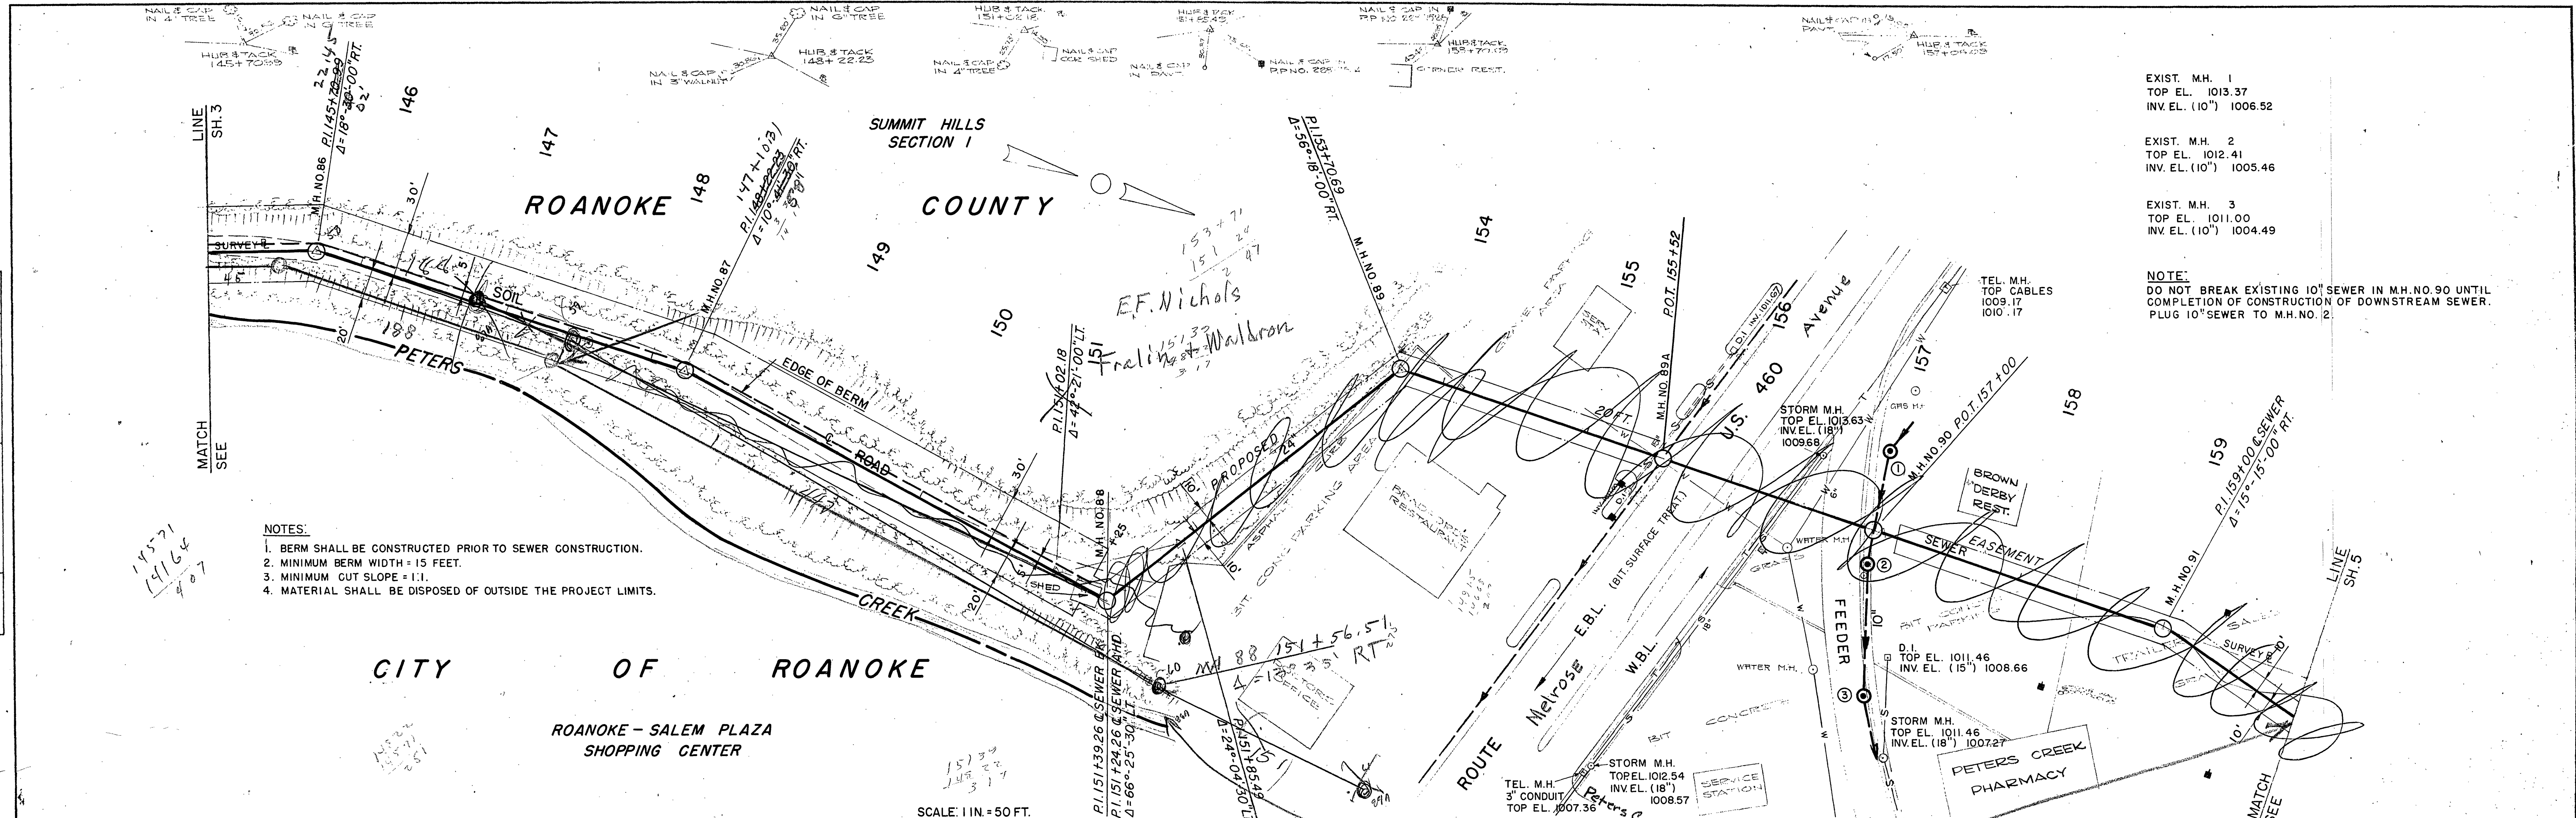

EXIST. M.H. 1
TOP EL. 1013.37
INV. EL. (10") 1006.52

EXIST. M.H. 2
TOP EL. 1012.41
INV. EL. (10") 1005.46

EXIST. M.H. 3
TOP EL. 1011.00
INV. EL. (10") 1004.49

NOTE:
DO NOT BREAK EXISTING 10" SEWER IN M.H. NO. 90 UNTIL
COMPLETION OF CONSTRUCTION OF DOWNSTREAM SEWER.
PLUG 10" SEWER TO M.H. NO. 2.


- NOTES:
1. BERM SHALL BE CONSTRUCTED PRIOR TO SEWER CONSTRUCTION.
 2. MINIMUM BERM WIDTH = 15 FEET.
 3. MINIMUM CUT SLOPE = 1:1.
 4. MATERIAL SHALL BE DISPOSED OF OUTSIDE THE PROJECT LIMITS.

T.B.M. ELEVATION 1000.28 R.R. SPIKE
IN 3" BLACK WALNUT TREE AT 727
WOODLEIGH RD. WARD RESIDENCE.

SCALE: 1 IN. = 50 FT.

See Sheet 5A, dated 6-15-70

U.S.C. & G.S. 1012.71 (H 369)
WEST END OF NORTH SIDEWALK
PETERS CREEK BRIDGE ON U.S. 460

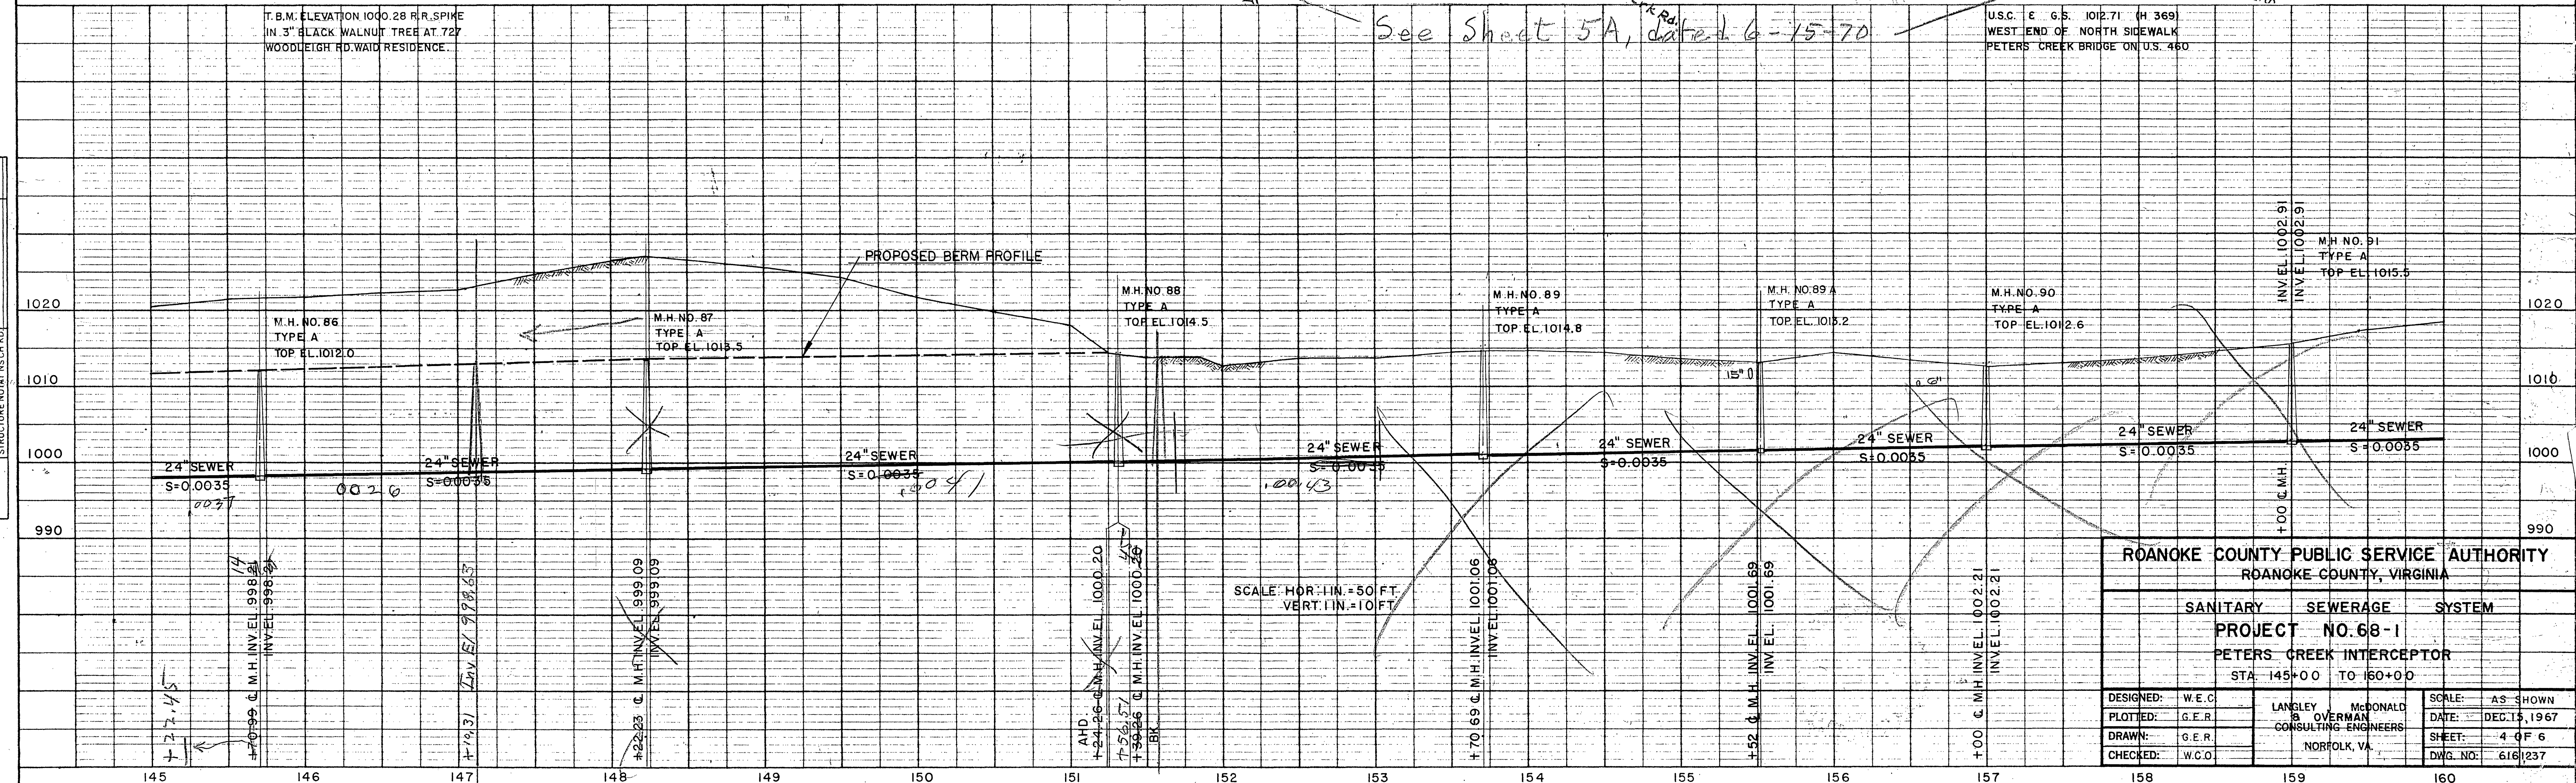

ROANOKE COUNTY PUBLIC SERVICE AUTHORITY			
ROANOKE COUNTY, VIRGINIA			
SANITARY		SEWERAGE	
SYSTEM			
PROJECT NO. 68-1			
PETERS CREEK INTERCEPTOR			
STA. 145+00 TO 160+00			
DESIGNED:	W.E.C.	LANGLEY & McDONALD	SCALE: AS SHOWN
PLOTTED:	G.E.R.	OVERMAN	DATE: DEC. 15, 1967
DRAWN:	G.E.R.	CONSULTING ENGINEERS	SHEET: 4 OF 6
CHECKED:	W.C.O.	NORFOLK, VA.	DWG. NO: 616/237
158	159	160	