


PLAN	SURVEYED	DATE
NOTE BOOK	PLOTTED	
NO.	RT. OF WAY CHECKED	

PROFILE	SURVEYED	DATE
NOTE BOOK	PLOTTED	
NO.	STRUCTURE NOTATIONS CHYD	

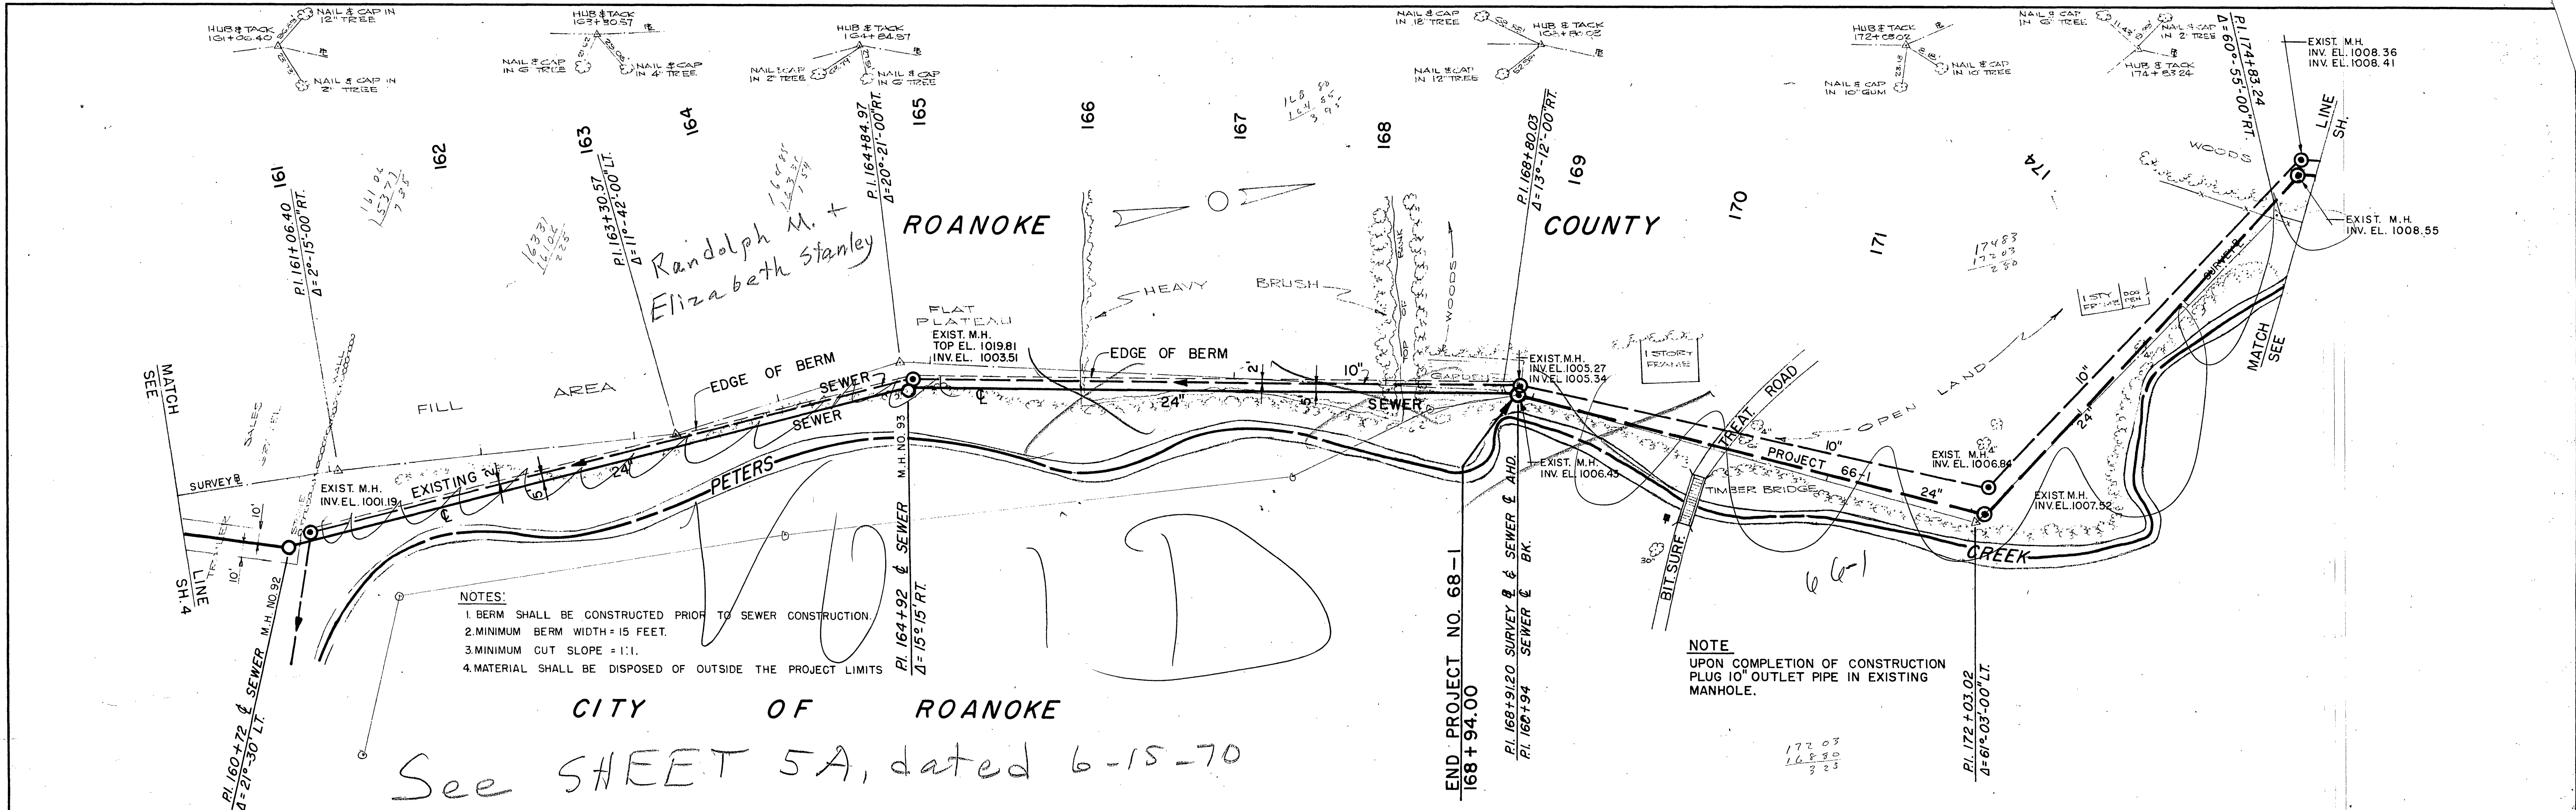

REVISION	DESCRIPTION	DATE
1	GENERAL REVISION	8/15/68
ROANOKE COUNTY PUBLIC SERVICE AUTHORITY		
ROANOKE COUNTY, VIRGINIA		
SANITARY SEWERAGE SYSTEM		
PROJECT NO. 68 - 1		
PETERS CREEK INTERCEPTOR		
STA. 160+00 TO 168+94		
DESIGNED: W.E.C.	LANLEY OVERMAN	SCALE: AS SHOWN
PLOTTED: G.E.R.	CONSULTING ENGINEERS	DATE: DEC. 15, 1967
DRAWN: G.E.R.	NORFOLK, VA.	SHEET: 5 OF 6
CHECKED: W.C.O.		DWG. NO: 6161236