


PROFILE	DATE
SURVEYED	BY
PLOTTED	BY
NOTE BOOK GRADES CHECKED	BY
NO. _____	DATE
STRUCTURE NOTATIONS CHKD	

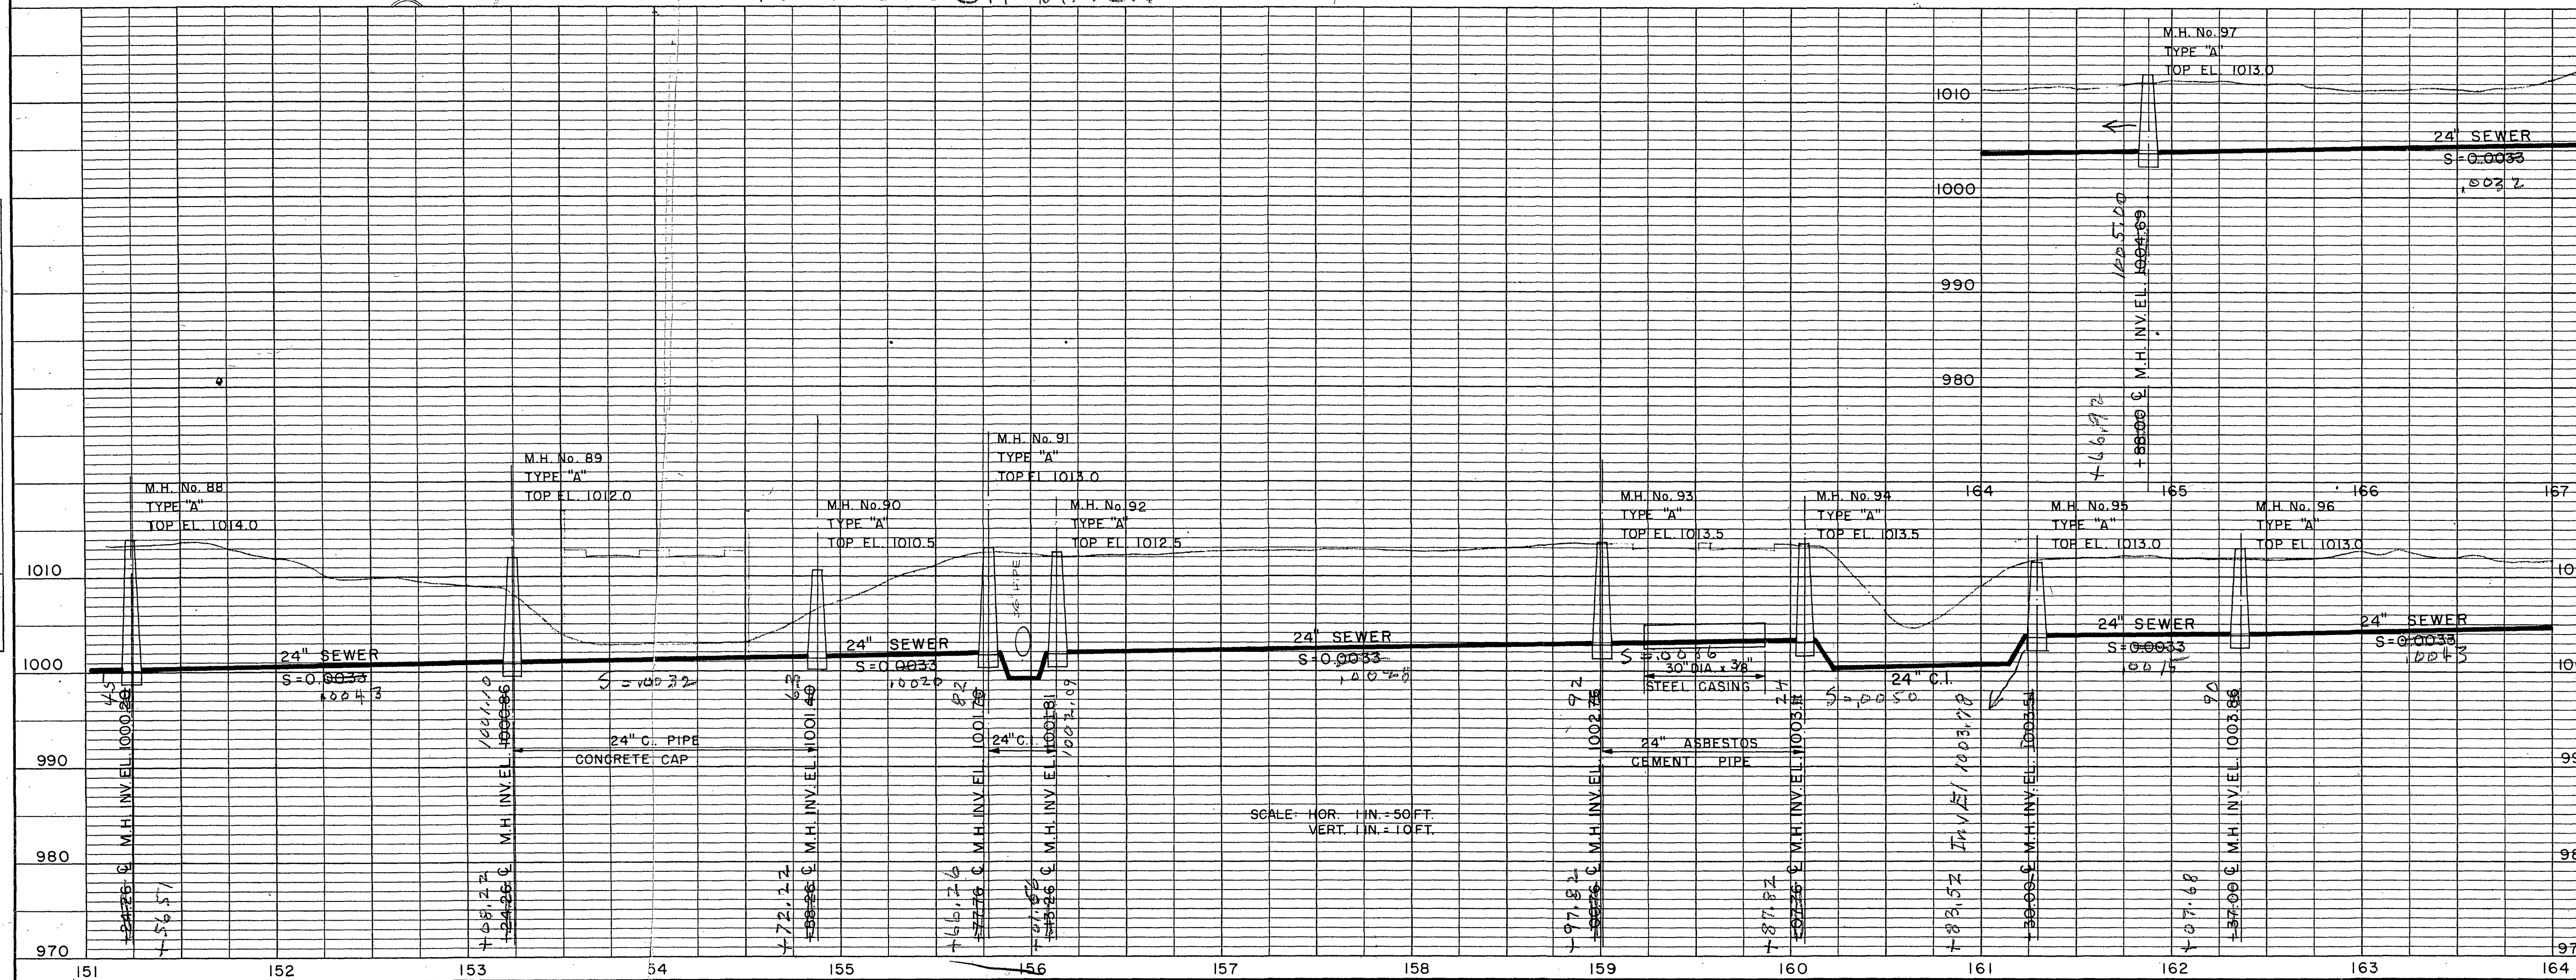

ROANOKE COUNTY PUBLIC SERVICE AUTHORITY		
ROANOKE COUNTY, VIRGINIA		
SANITARY	SEWERAGE	SYSTEM
PROJECT NO. 68-1		
PETERS CREEK INTERCEPTOR		
STA. 151+24.26 TO 169+83.00		
DES: W.E.C.	LANGLEY, McDONALD and OVERMAN	SCALE: 1" = 50'
DR: NEP	CONSULTING ENGINEERS	DATE: JUNE 15, '70
CK: W.E.C.	NORFOLK, VIRGINIA	SHEET 5A OF 5