
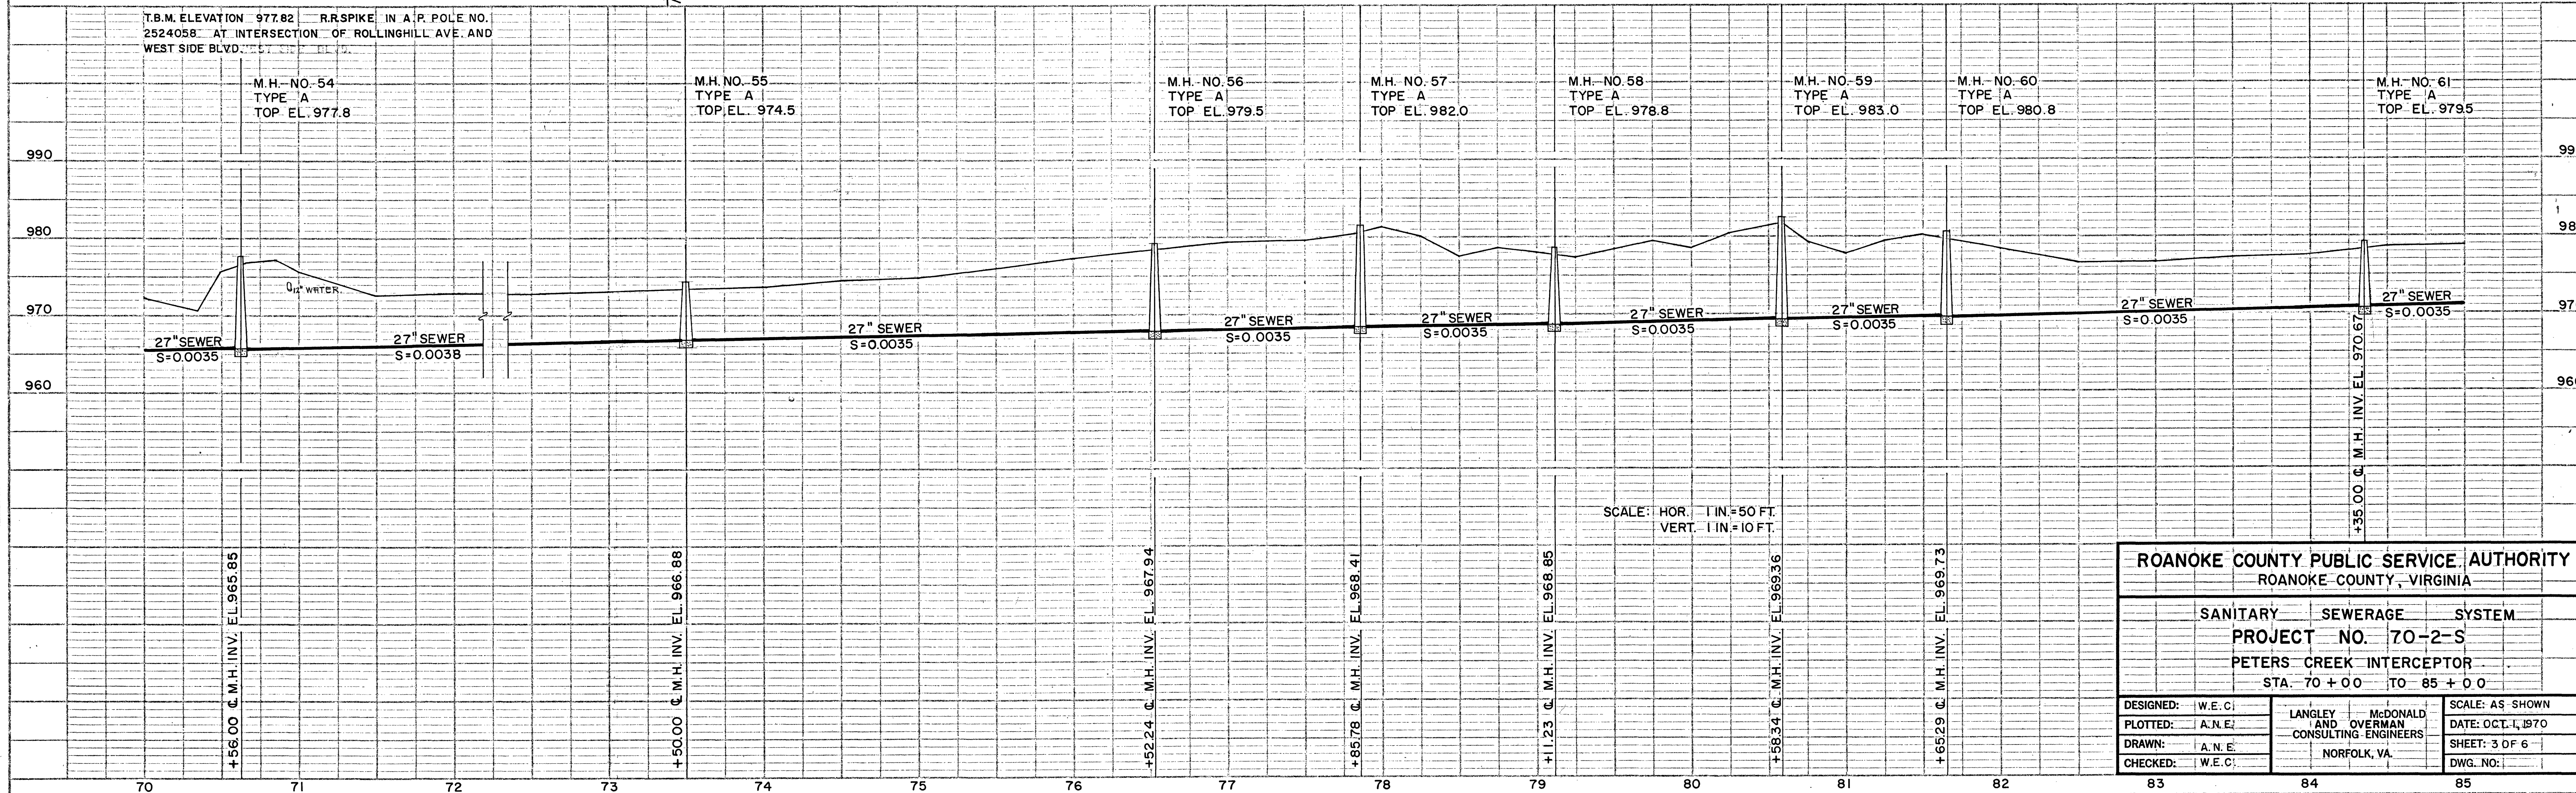


PLAN	DESIGNED	W.E.C.
	PLOTTED	A.N.E.
	NOTE BOOK	ALIGNED CHECKED
	NO.	RT. OF WAY CHECKED

PROFILE	DESIGNED	W.E.C.
	PLOTTED	A.N.E.
	NOTE BOOK	GRADES CHECKED
	NO.	STRUCTURE/STATIONING CHECKED

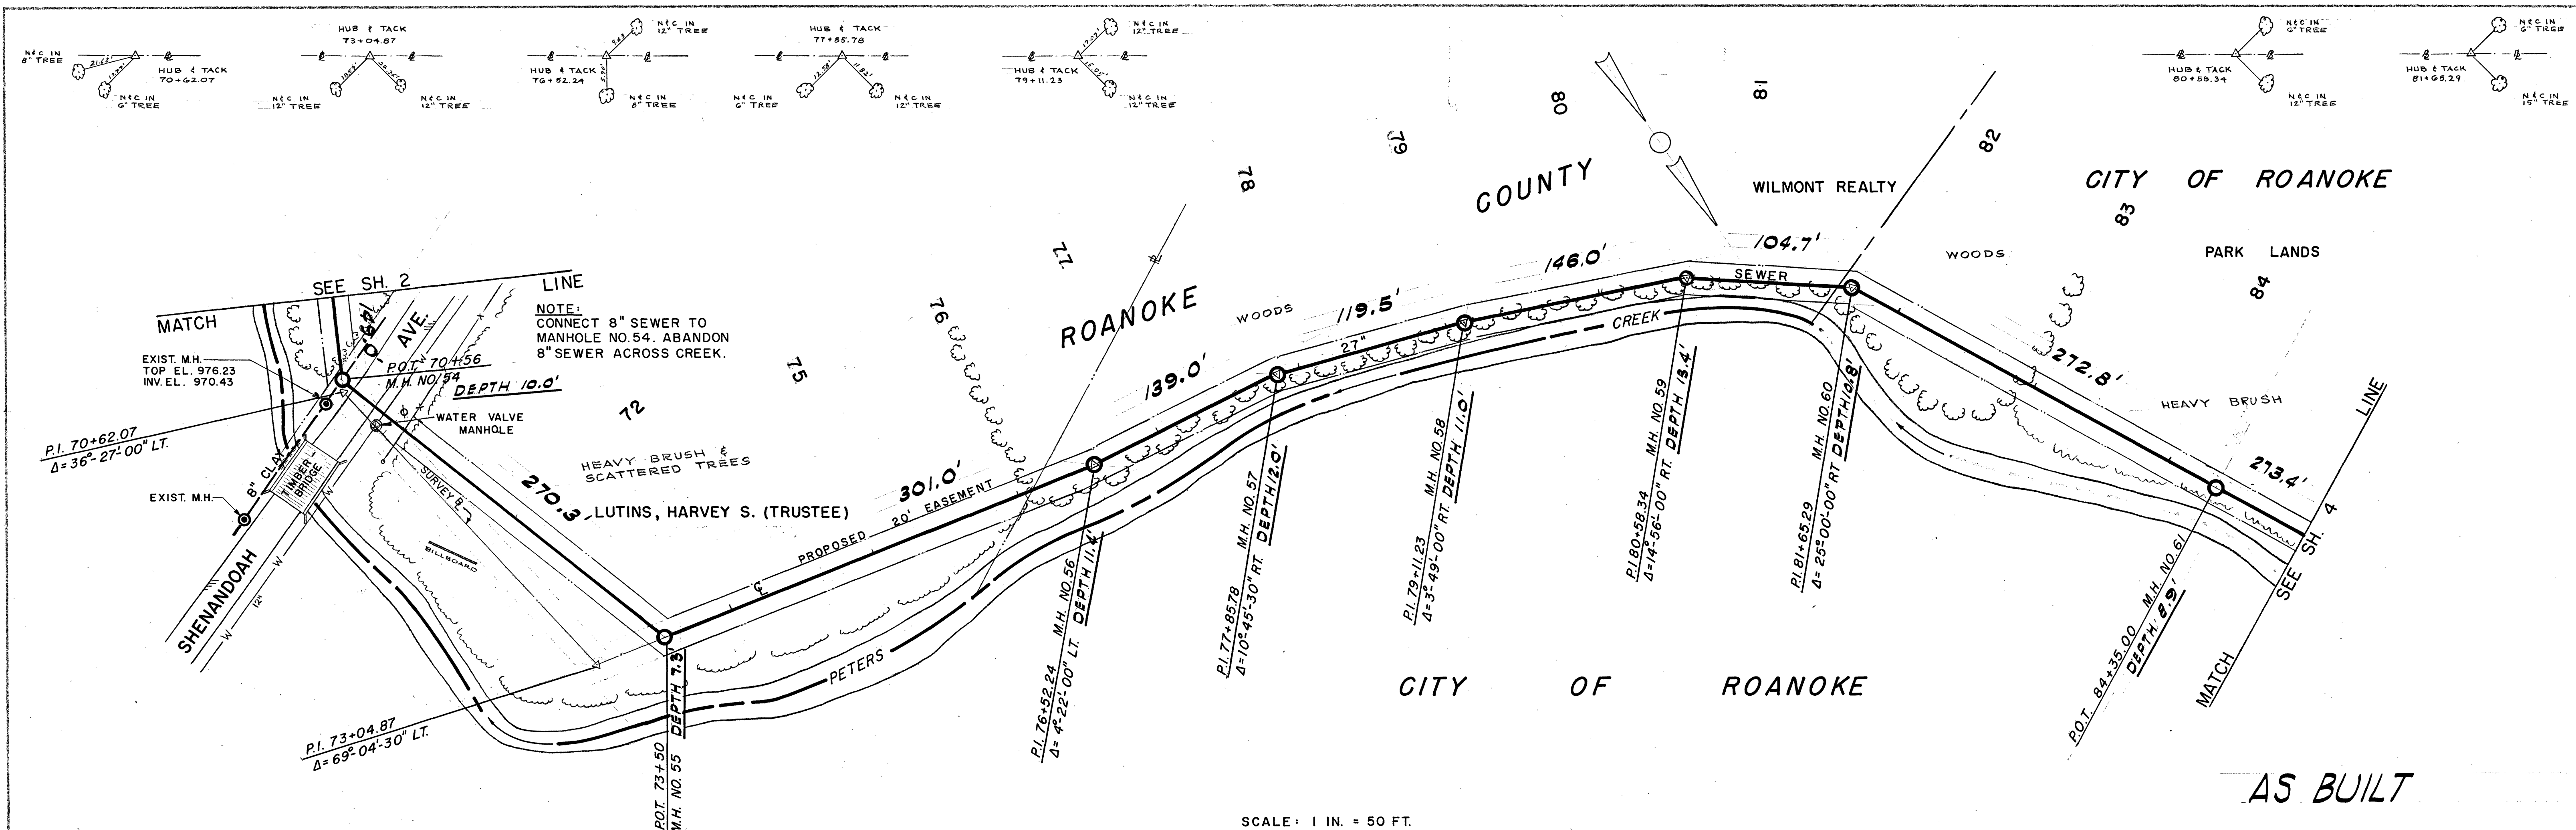

ROANOKE COUNTY PUBLIC SERVICE AUTHORITY ROANOKE COUNTY, VIRGINIA		
SANITARY SEWERAGE SYSTEM		
PROJECT NO. 70-2-S		
PETERS CREEK INTERCEPTOR		
STA. 70+00 TO 85+00		
DESIGNED:	W.E.C.	SCALE: AS SHOWN
PLOTTED:	A.N.E.	DATE: OCT. 1, 1970
DRAWN:	A.N.E.	SHEET: 3 OF 6
CHECKED:	W.E.C.	DWG. NO.: