
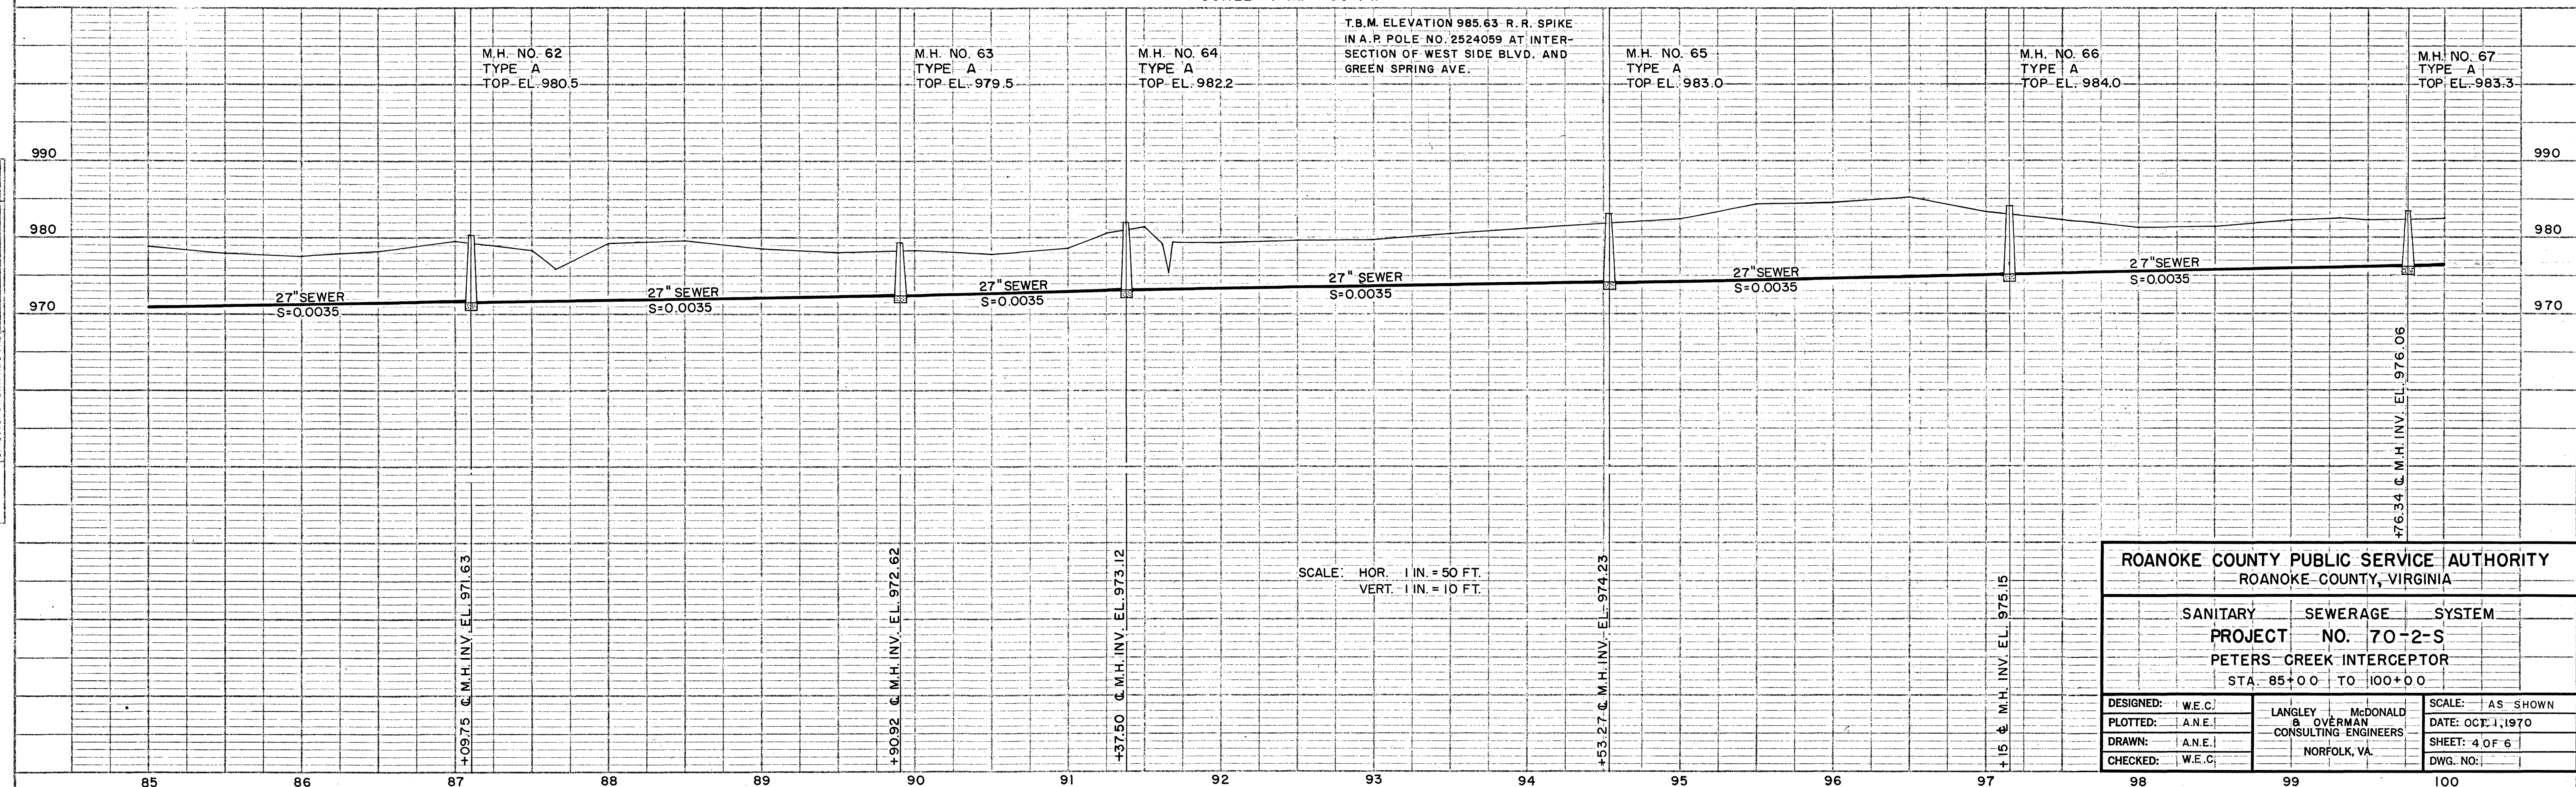


PLAN	DESIGNED	DATE
	PLOTTED	DATE
	ALIGNED CHECKED	DATE
	RT. OF WAY CHECKED	DATE
	NO.	

PROFILE	DESIGNED	DATE
	PLOTTED	DATE
	GRADES CHECKED	DATE
	B.M. NOTED	DATE
	STRUCTURE NOTED	DATE
	NO.	

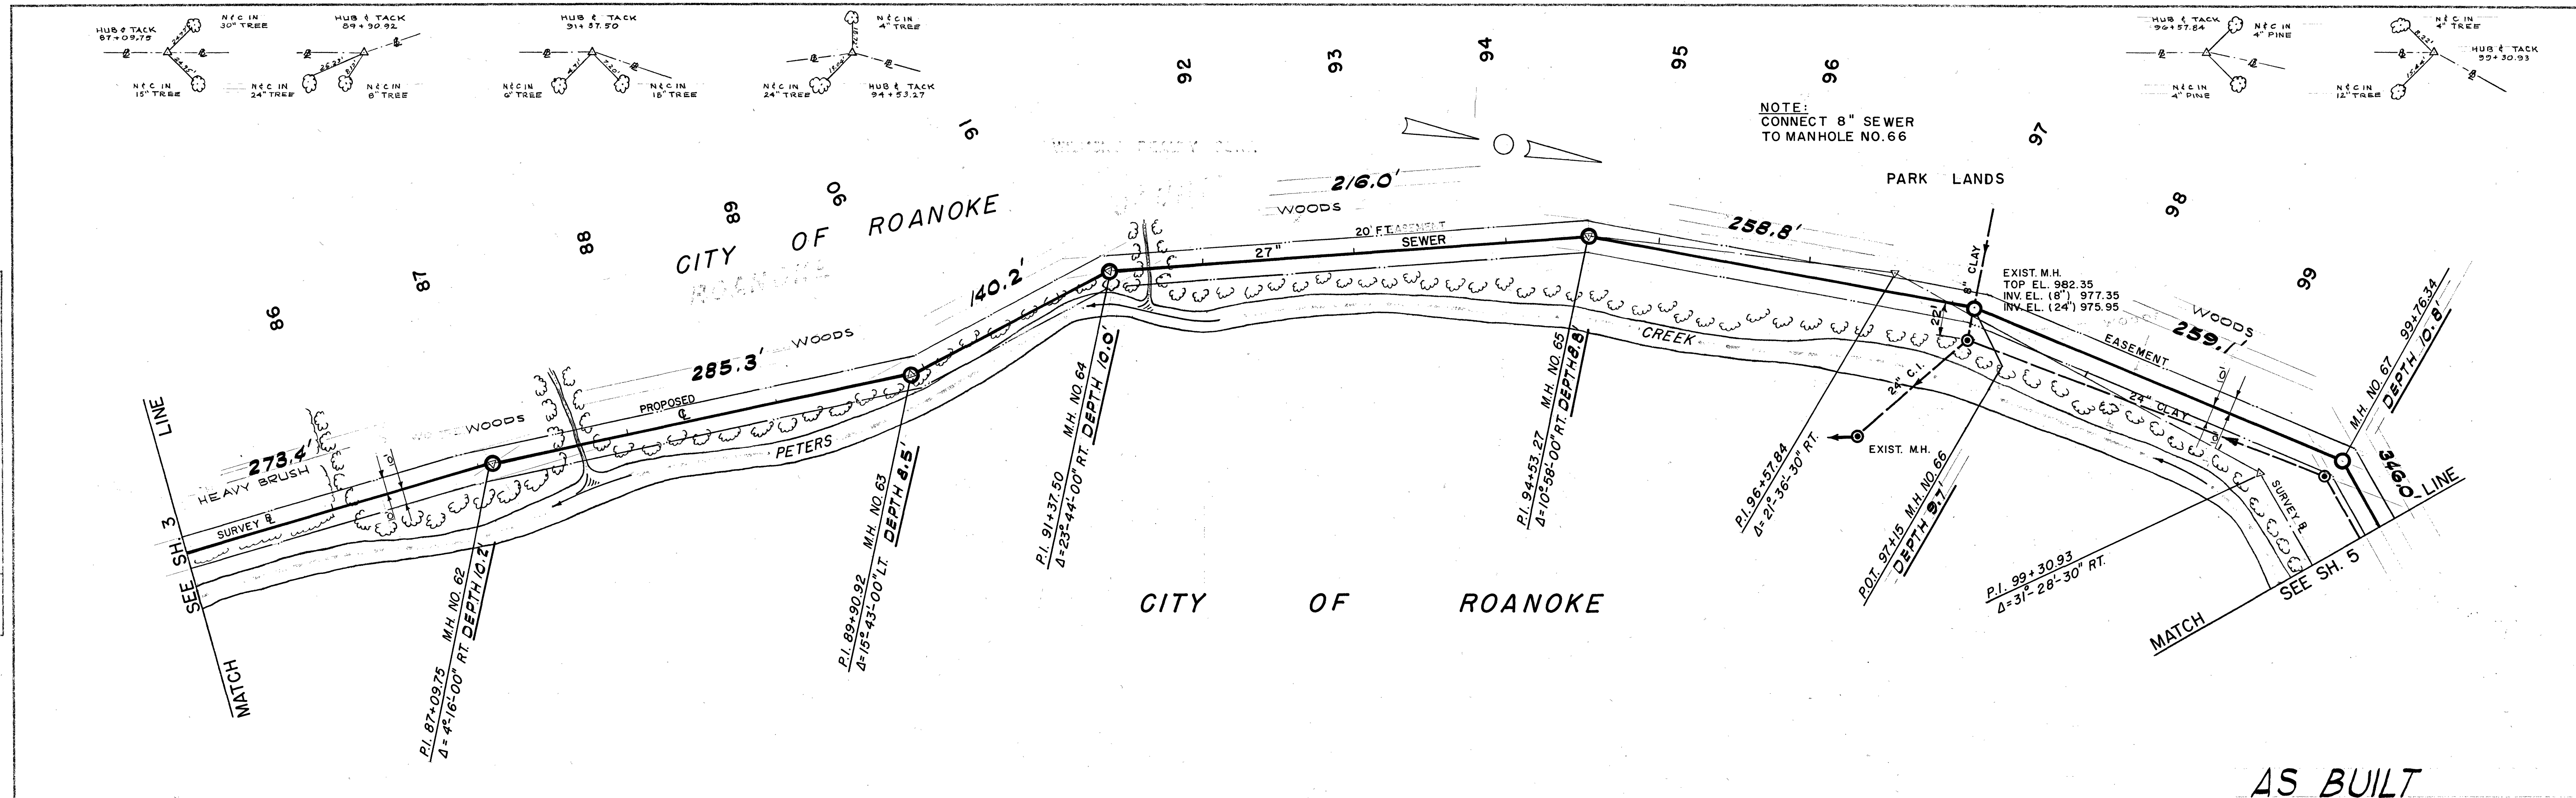

ROANOKE COUNTY PUBLIC SERVICE AUTHORITY ROANOKE COUNTY, VIRGINIA		
SANITARY	SEWERAGE	SYSTEM
PROJECT NO. 70-2-S		
PETERS CREEK INTERCEPTOR		
STA. 85+00 TO 100+00		
DESIGNED: W.E.C.	LANGLEY & McDONALD	SCALE: AS SHOWN
PLOTTED: A.N.E.	OVERMAN	DATE: OCT. 1, 1970
DRAWN: A.N.E.	CONSULTING ENGINEERS	SHEET: 4 OF 6
CHECKED: W.E.C.	NORFOLK, VA.	DWG. NO.: