



PLAN	SURVEYED	BY	DATE
NOTE BOOK	PLOTTED		
	GRADES CHECKED		
	STRUCTURE NOTATION CHECKED		

PROFILE	SURVEYED	BY	DATE
NOTE BOOK	PLOTTED		
	GRADES CHECKED		
	STRUCTURE NOTATION CHECKED		

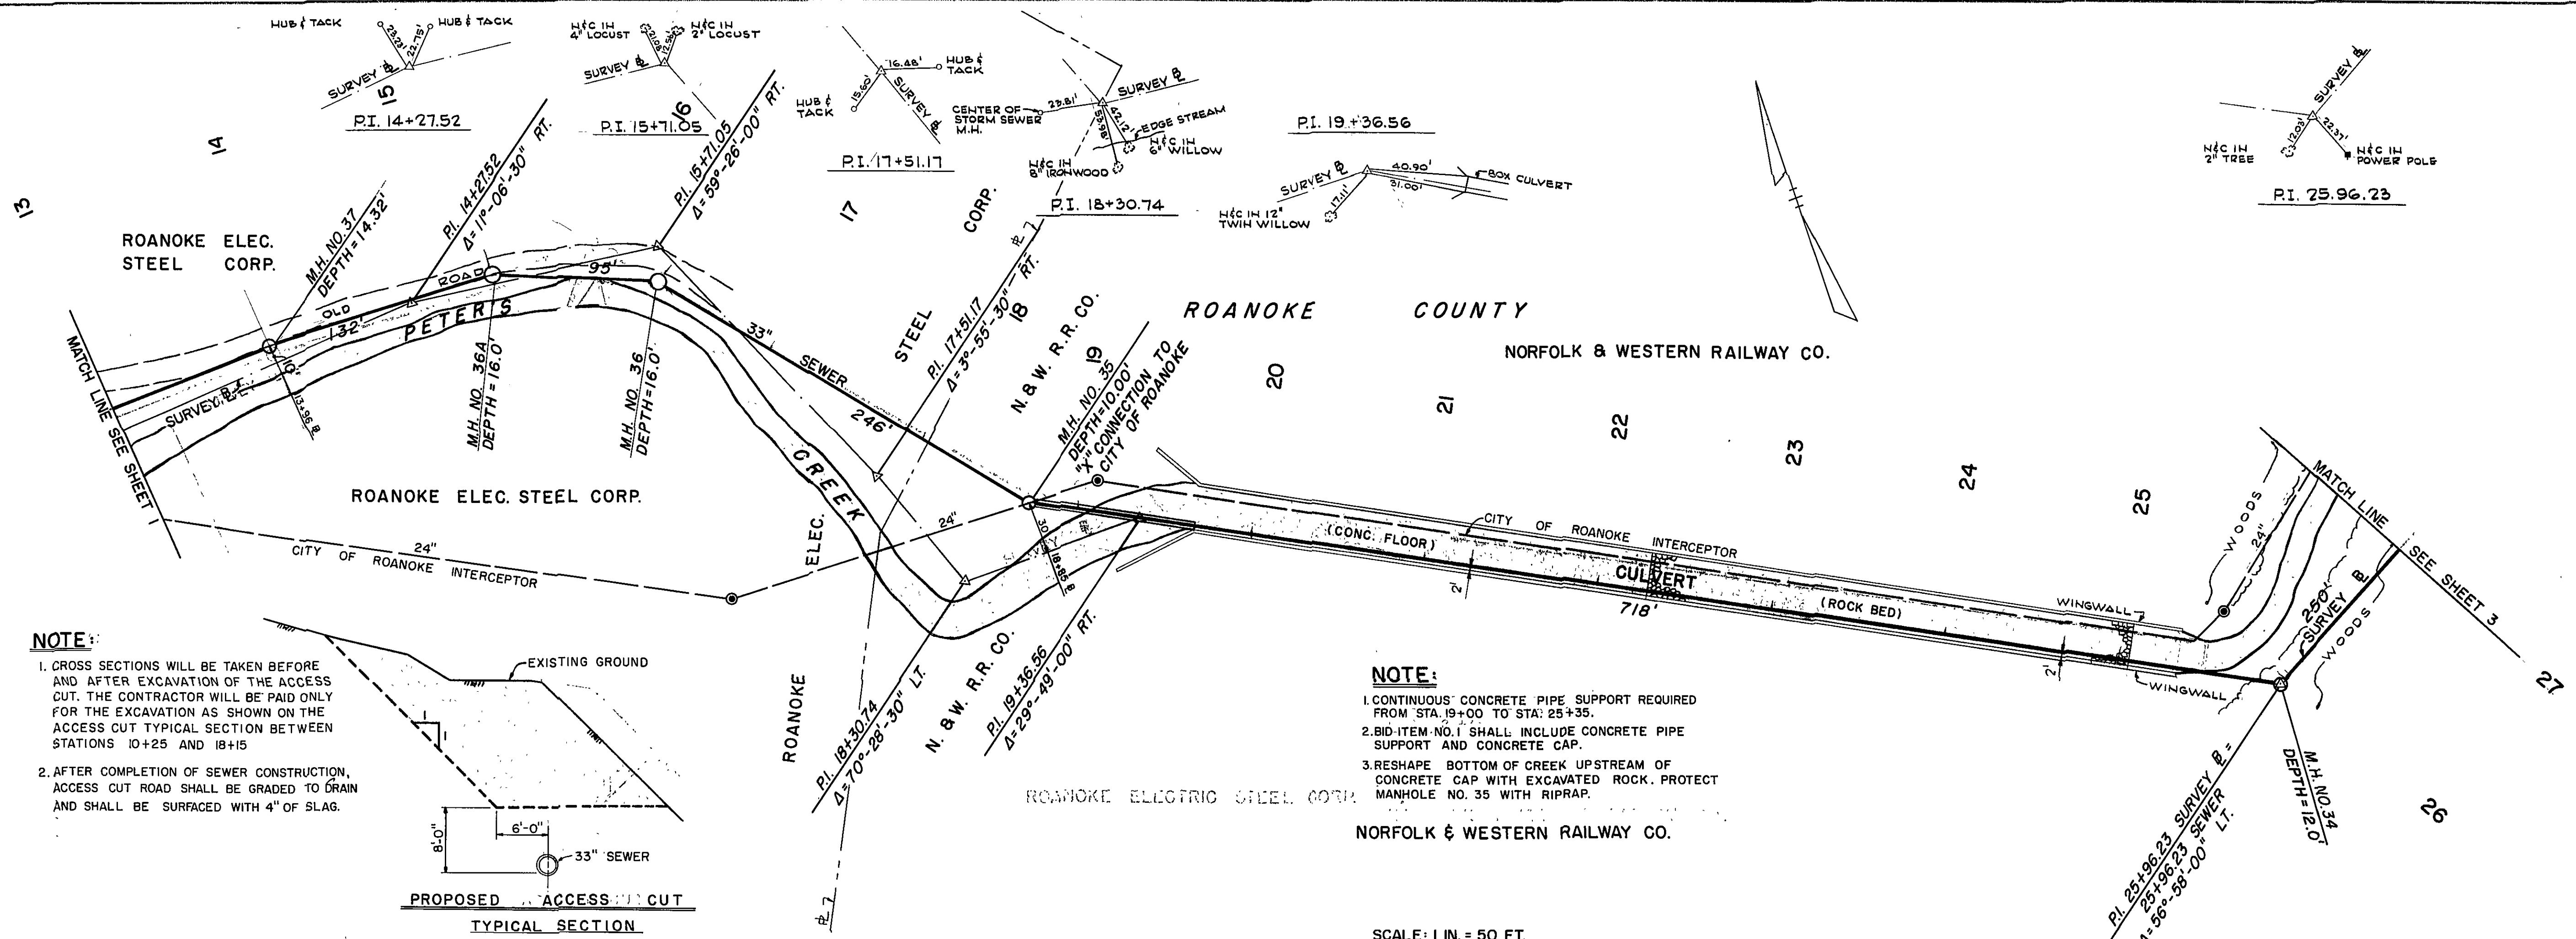

NOTE:


- CROSS SECTIONS WILL BE TAKEN BEFORE AND AFTER EXCAVATION OF THE ACCESS CUT. THE CONTRACTOR WILL BE PAID ONLY FOR THE EXCAVATION AS SHOWN ON THE ACCESS CUT TYPICAL SECTION BETWEEN STATIONS 10+25 AND 18+15
- AFTER COMPLETION OF SEWER CONSTRUCTION, ACCESS CUT ROAD SHALL BE GRADED TO DRAIN AND SHALL BE SURFACED WITH 4" OF SLAG.

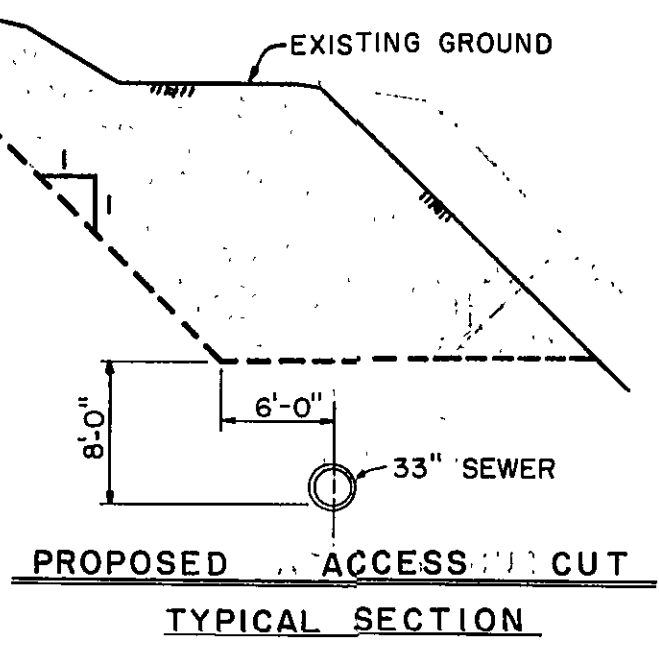


NOTE:

- CONTINUOUS CONCRETE PIPE SUPPORT REQUIRED FROM STA. 19+00 TO STA. 25+35.
- BID-ITEM NO. 1 SHALL INCLUDE CONCRETE PIPE SUPPORT AND CONCRETE CAP.
- RESHAPE BOTTOM OF CREEK UPSTREAM OF CONCRETE CAP WITH EXCAVATED ROCK. PROTECT MANHOLE NO. 35 WITH RIPRAP.

SCALE: 1 IN. = 50 FT.

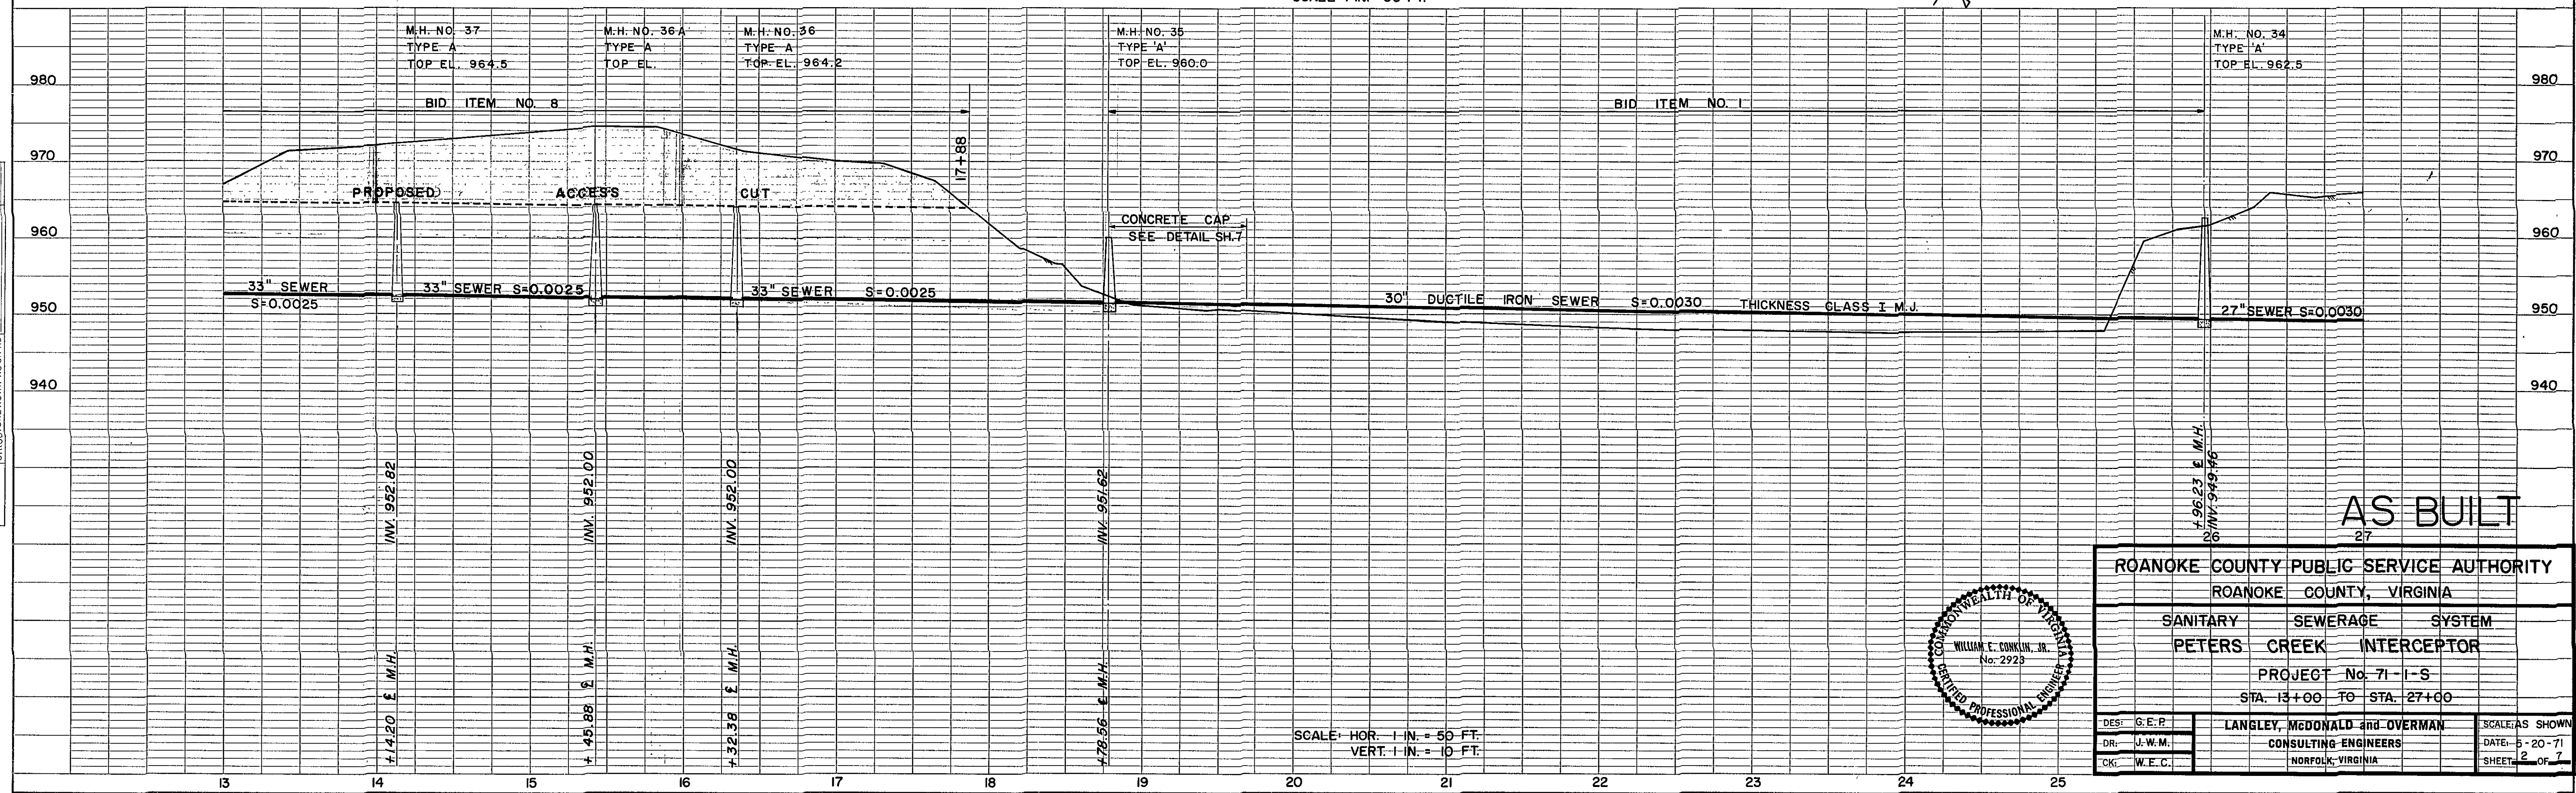

SCALE: HOR. 1 IN. = 50 FT.
VERT. 1 IN. = 10 FT.

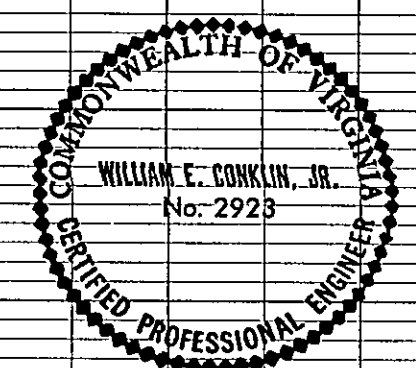

ROANOKE COUNTY PUBLIC SERVICE AUTHORITY		
ROANOKE COUNTY, VIRGINIA		
SANITARY	SEWERAGE	SYSTEM
PETERS	CREEK	INTERCEPTOR
PROJECT No. 71-1-S		
STA. 13+00 TO STA. 27+00		
DES: G.E.P.	LANGLEY, McDONALD and OVERMAN	
DR: J.W.M.	CONSULTING ENGINEERS	
CK: W.E.C.	NORFOLK, VIRGINIA	
SCALE: AS SHOWN	DATE: 5-20-71	SHEET 2 OF 7