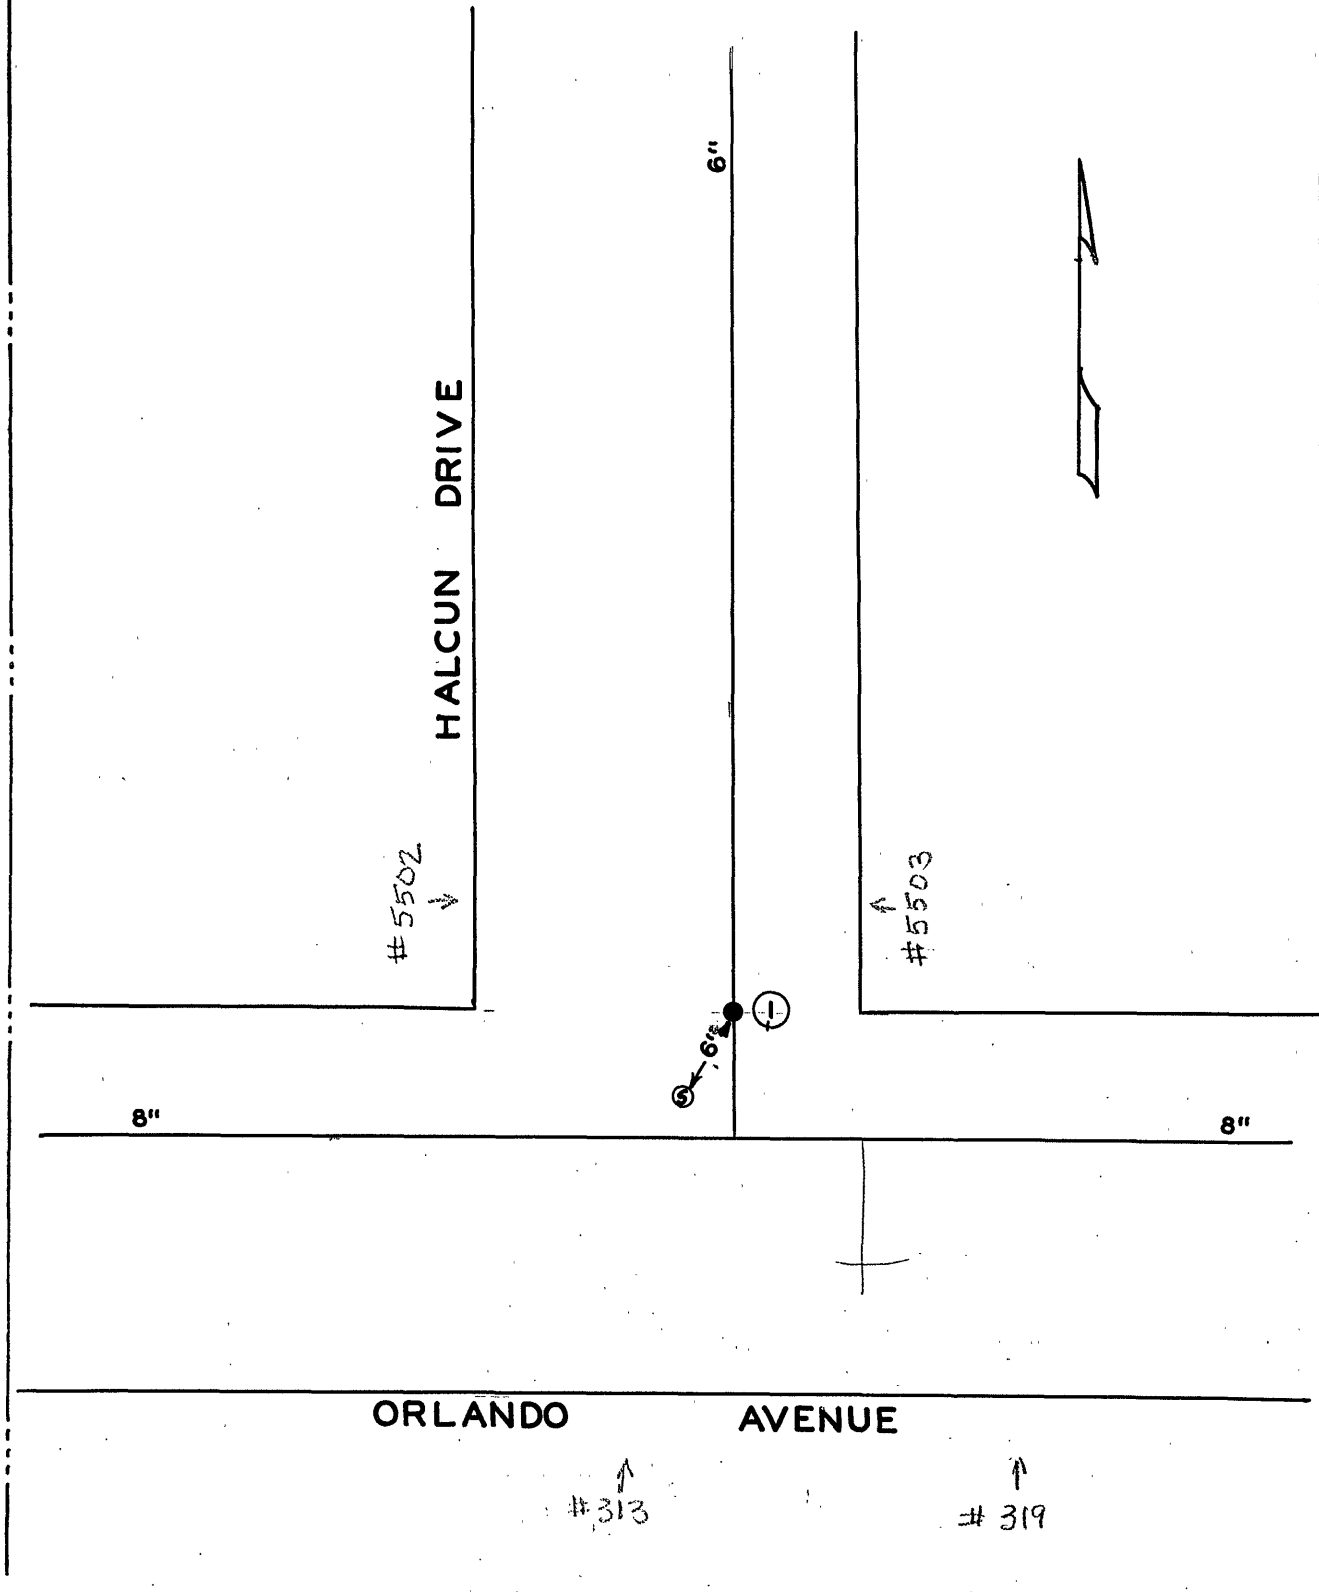

DATE	NO.	SIZE	MAKE	OPEN	TURNS
7-65	1	6	MUELLER	R	20

CITY OF ROANOKE—WATER DEPT.

VALVE DIAGRAM

HALCUN DRIVE &
ORLANDO AVENUE N.E.

SEC. MAP 30 Roanoke County

DATE PAGE NO.