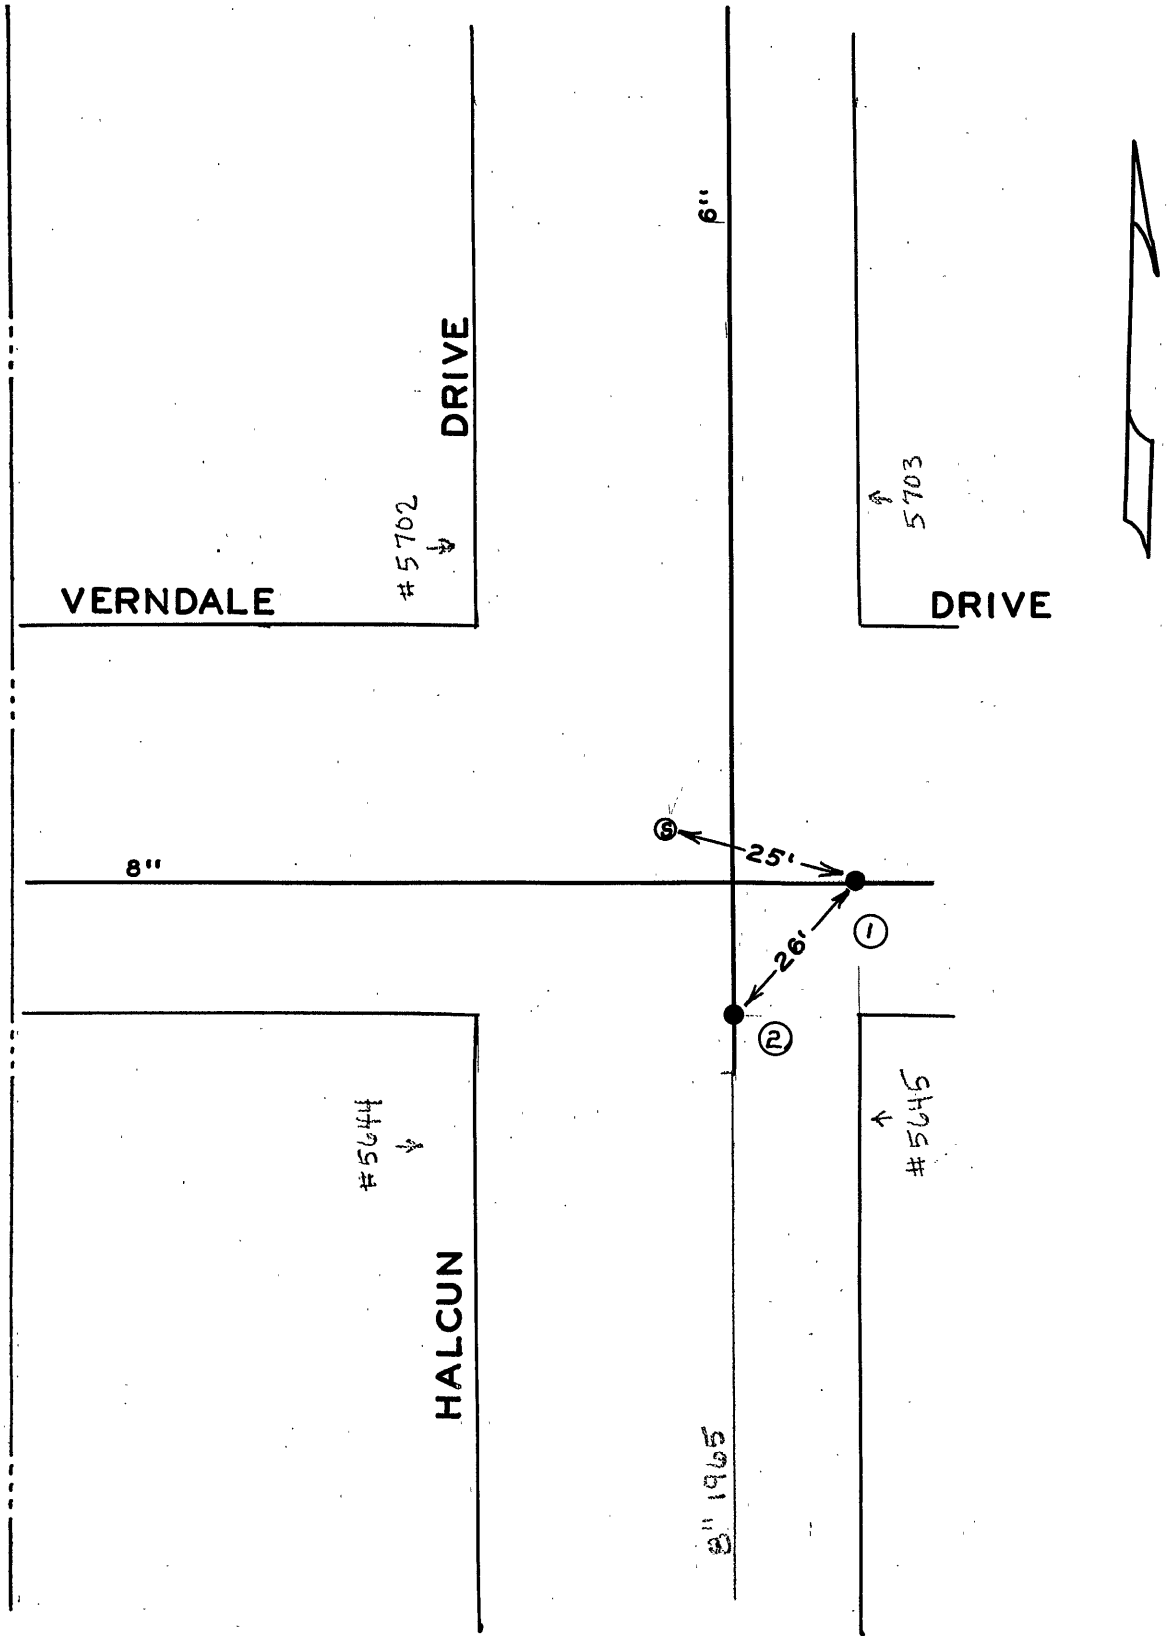

DATE	NO.	SIZE	MAKE	OPEN	TURNS
5-64	1	8	MUELLER	R	
5-64	2	6	MUELLER	R	
	1	0	E.P.L.		
	2	0	S.P.L.		

CITY OF ROANOKE—WATER DEPT.

VALVE DIAGRAM

HALCUN DRIVE &

VERNDALE DRIVE N.E.

SEC. MAP 30 - 46. Roanoke County

DATE PAGE NO.