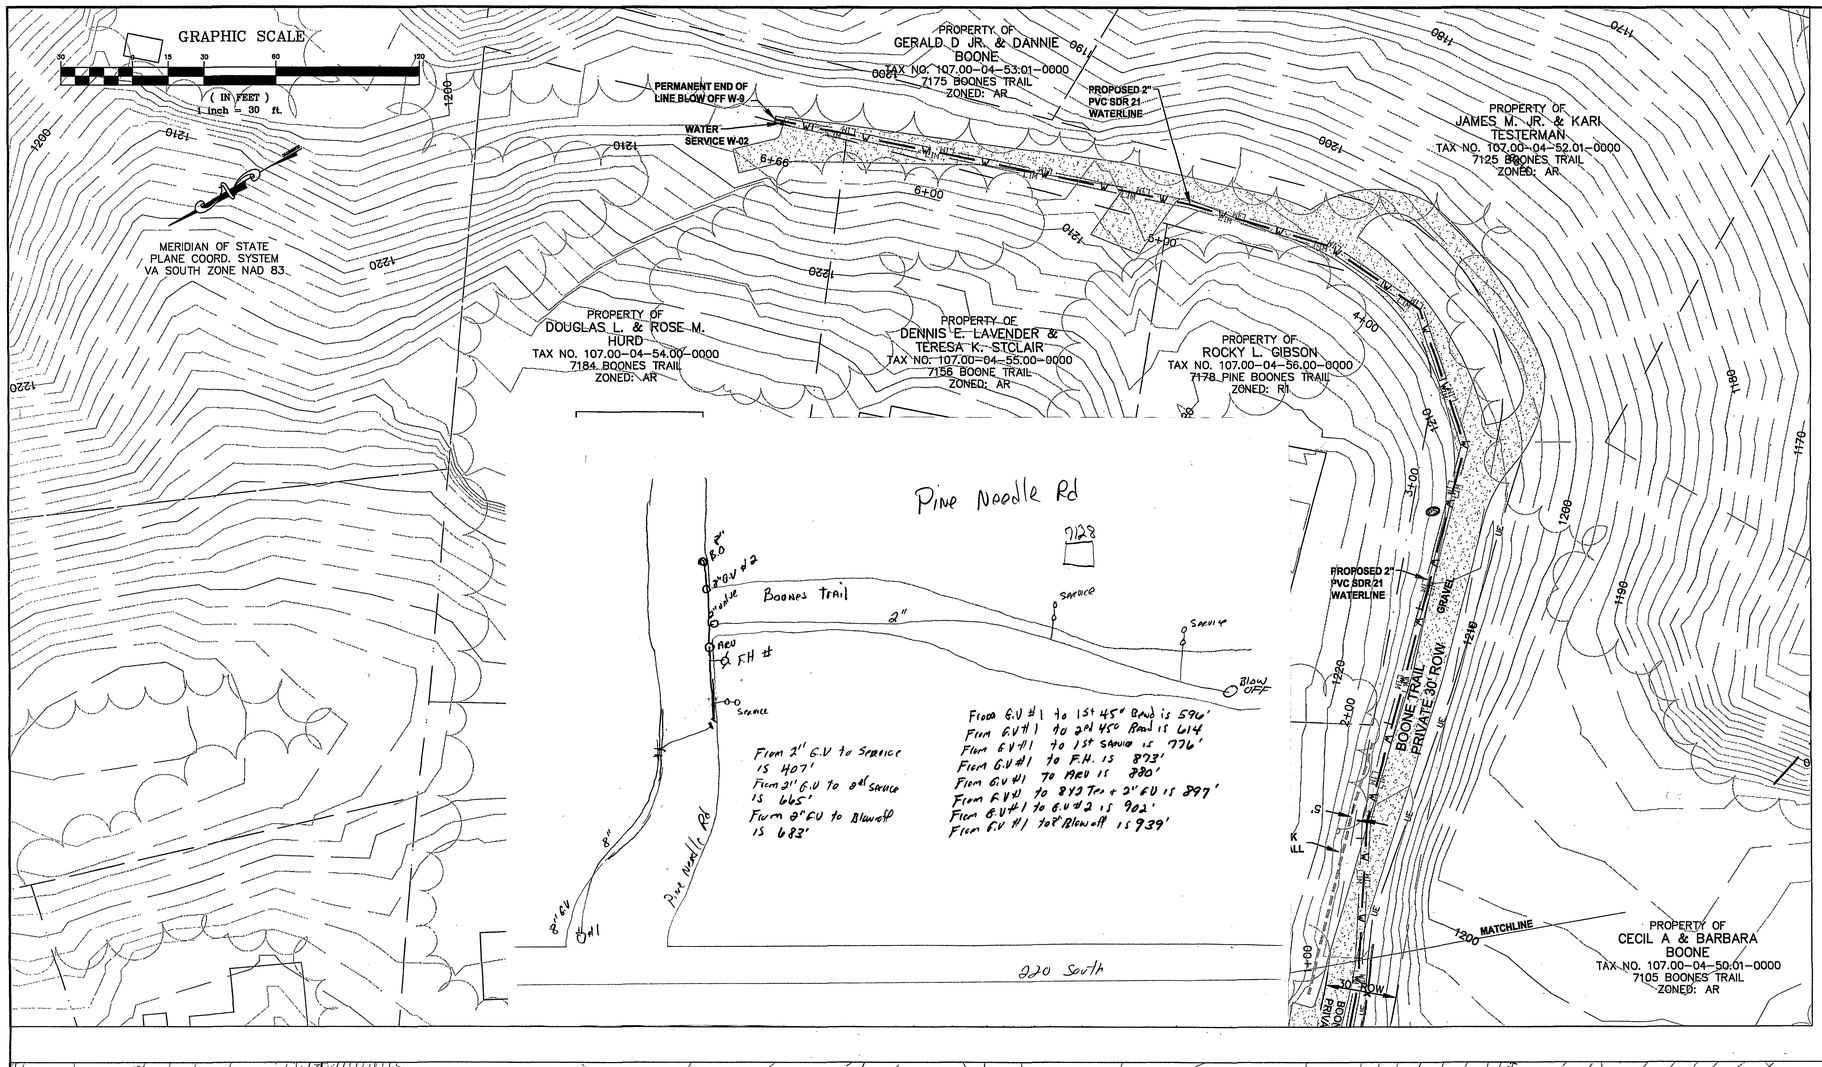

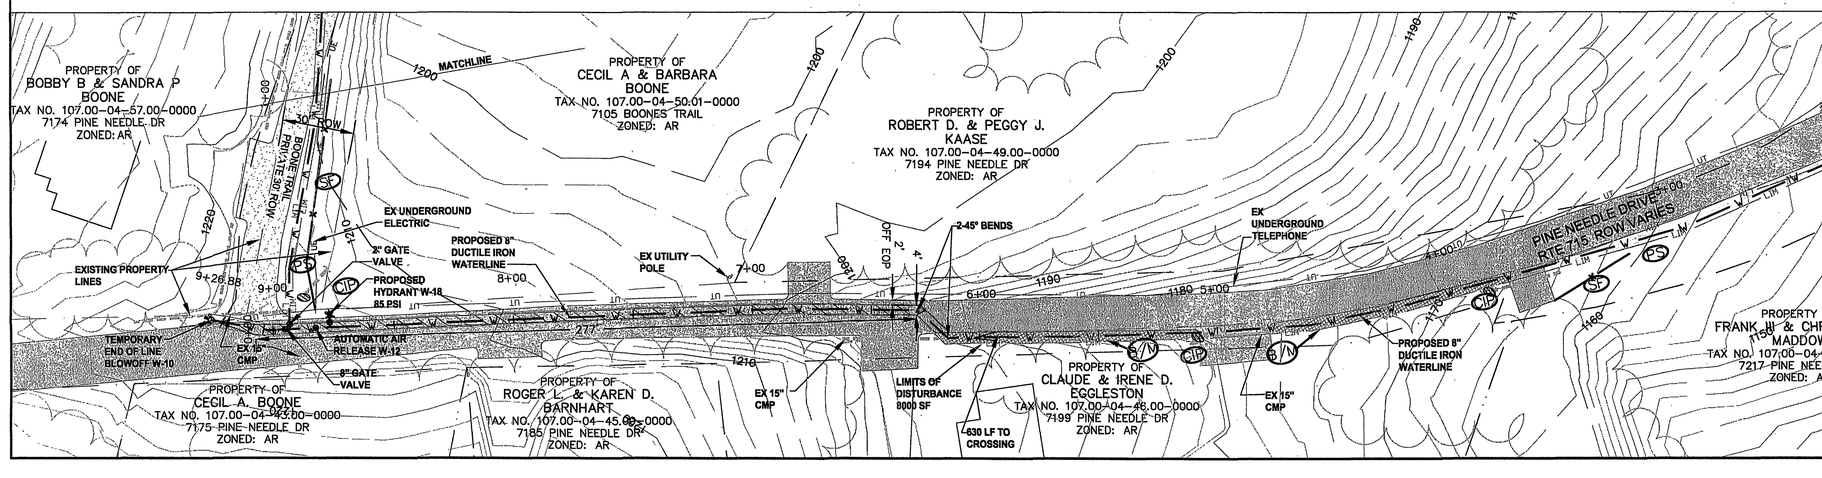

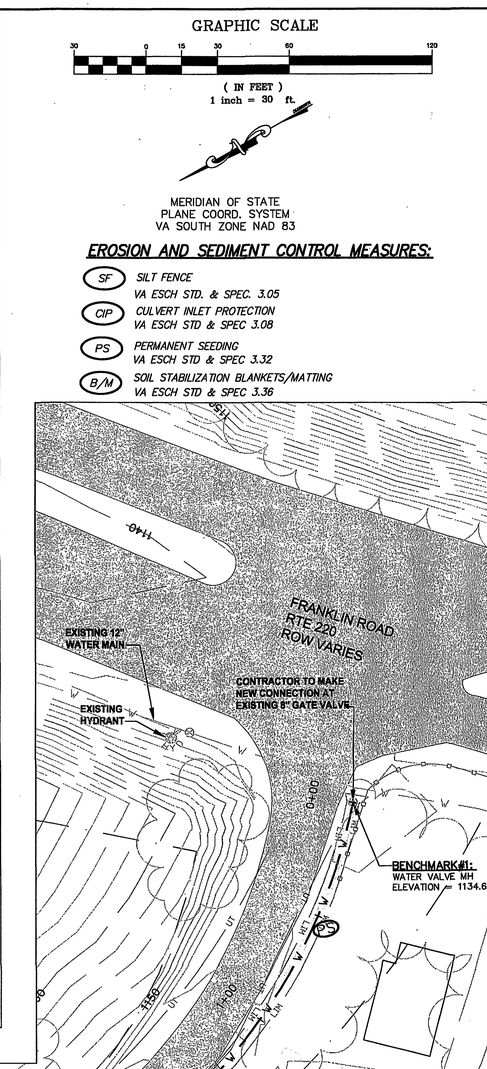

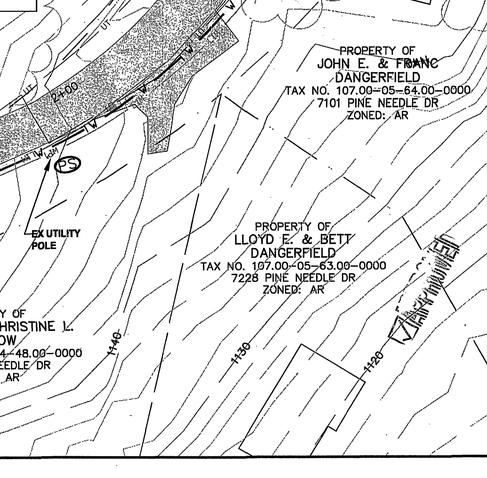

ENGINEERING SERVICES
601 S JEFFERSON ST, SUITE 300
ROANOKE, VA 24011
540-853-5700

COMMONWEALTH OF VIRGINIA
12-28-09
Roger Blankenship
ROGER R. BLANKENSHIP
Lic. No.040615
PROFESSIONAL ENGINEER

PINE NEEDLE PROPOSED WATER LINE

PROPOSED WATERLINE & E&S CONTROL

Rev	Description
1	Revisions per Roanoke County and VDOT comments 12/23/09

Designed: AAS
Drawn: AAS
Checked: RRB
Approved:
Date: 23 NOV 2009
Project:

C2
Sheet 2 of 6