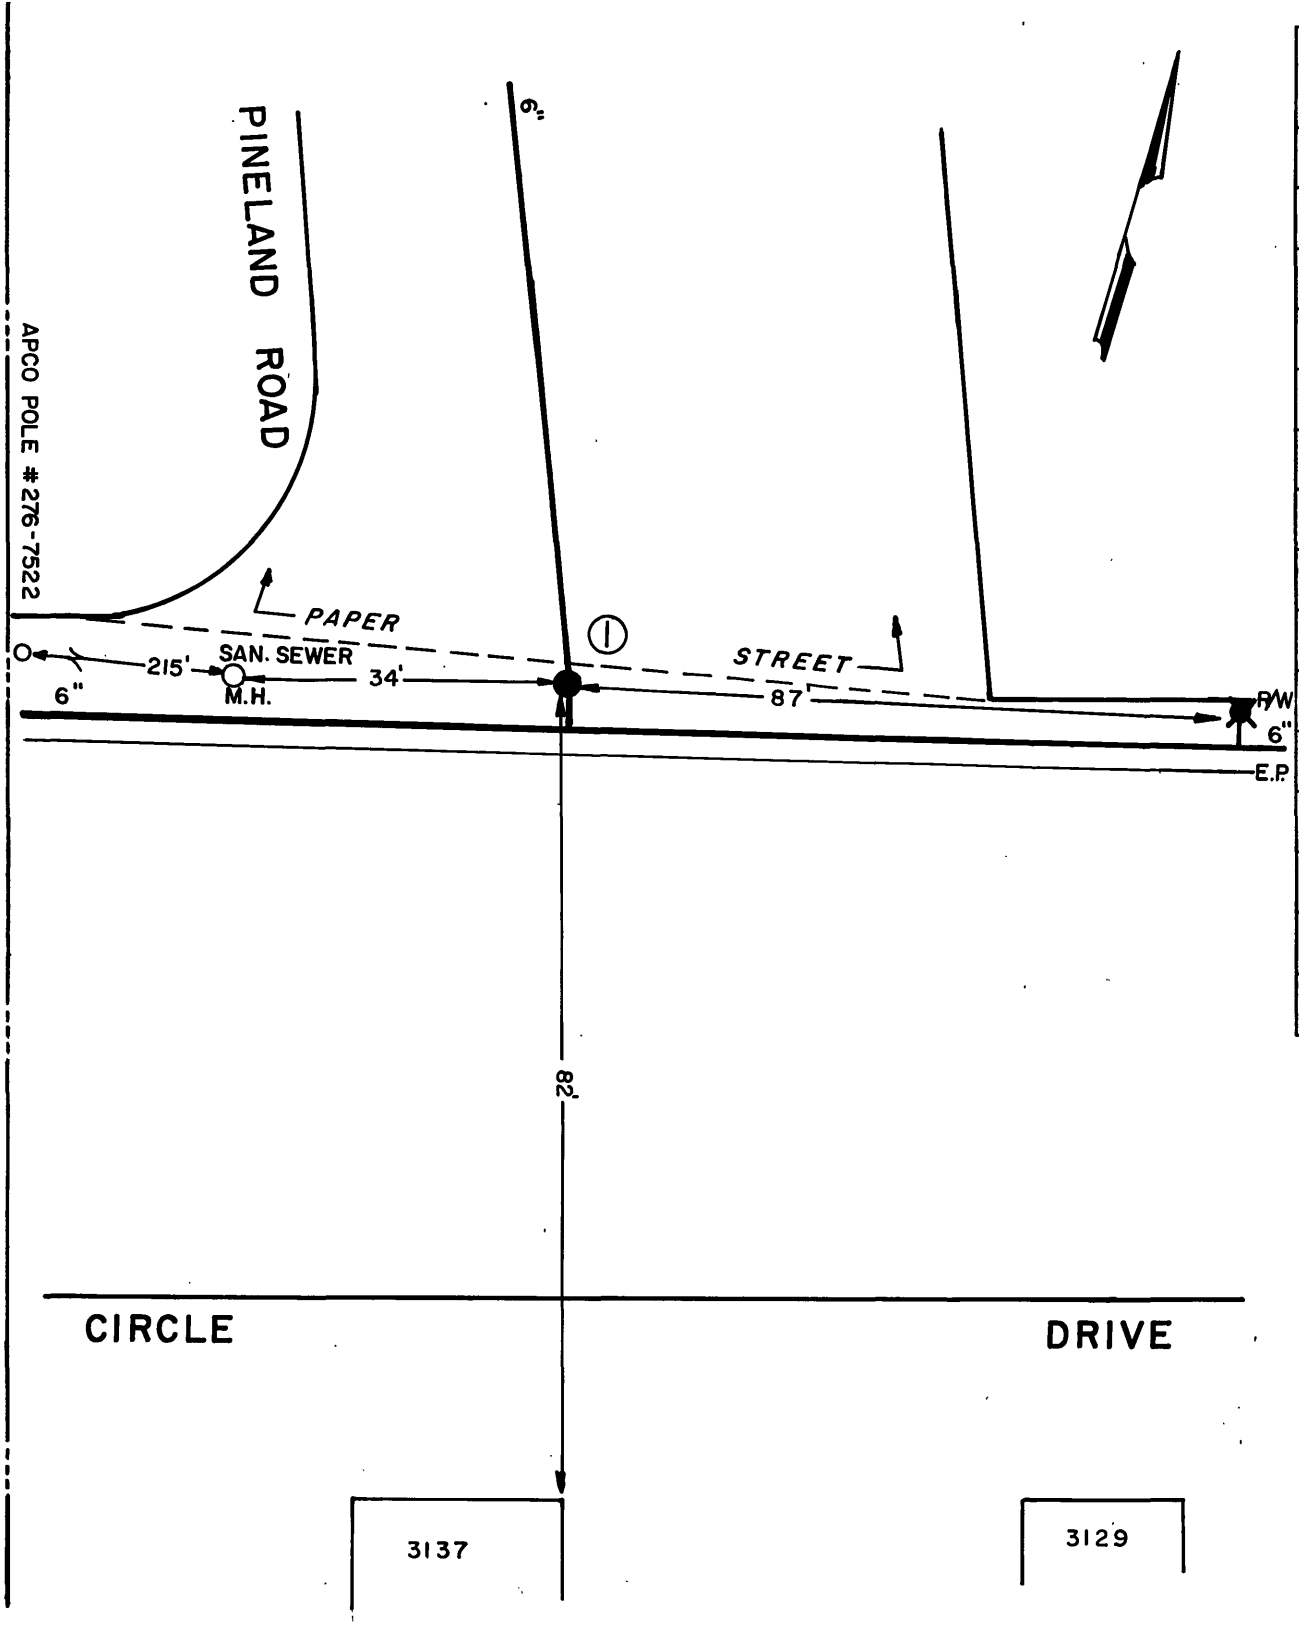

DATE	NO.	SIZE	MAKE	OPEN	TURNS
2-91	1	6"	MUELLER	R	21

CITY OF ROANOKE—WATER DEP'T

VALVE DIAGRAM

CIRCLE DRIVE &

PINELAND ROAD

SEC. MAP 501 S.W.

DATE PAGE NO.