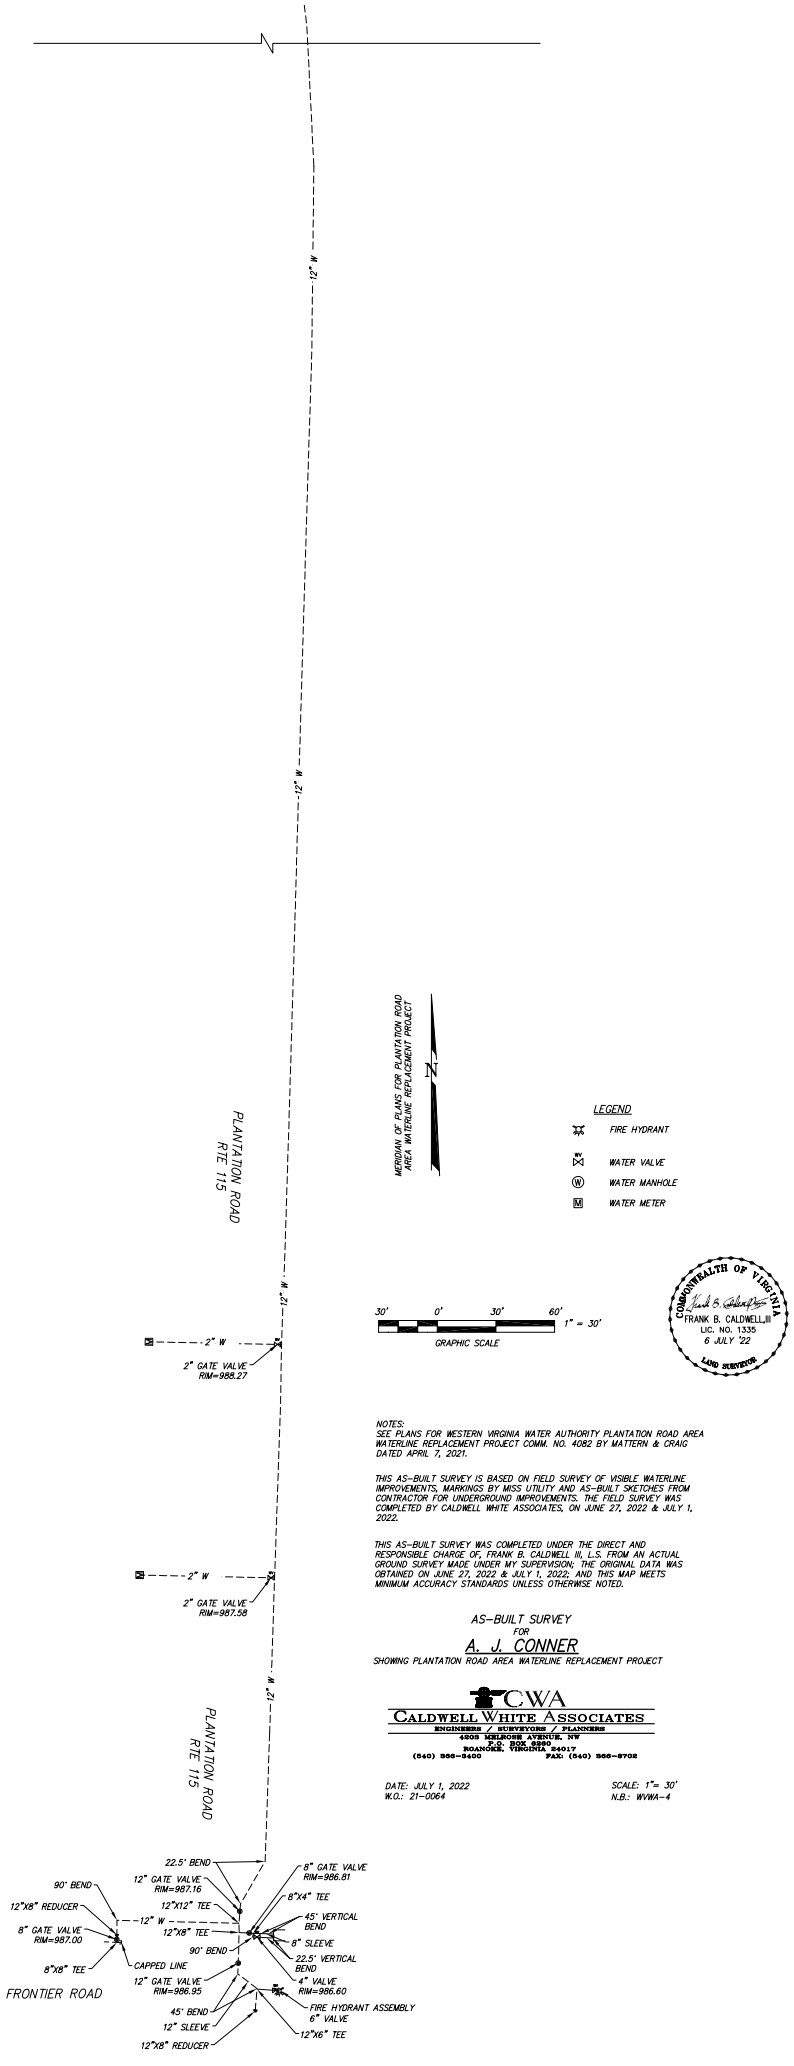

NOTES:
SEE PLANS FOR WESTERN VIRGINIA WATER AUTHORITY PLANTATION ROAD AREA WATERLINE REPLACEMENT PROJECT COMM. NO. 4082 BY MATTERN & CRAIG DATED APRIL 7, 2021.

THIS AS-BUILT SURVEY IS BASED ON FIELD SURVEY OF VISIBLE WATERLINE IMPROVEMENTS, MARKINGS BY MISS UTILITY AND AS-BUILT SKETCHES FROM CONTRACTOR FOR UNDERGROUND IMPROVEMENTS. THE FIELD SURVEY WAS COMPLETED BY CALDWELL WHITE ASSOCIATES, ON JUNE 27, 2022 & JULY 1, 2022.

THIS AS-BUILT SURVEY WAS COMPLETED UNDER THE DIRECT AND RESPONSIBLE CHARGE OF, FRANK B. CALDWELL III, L.S. FROM AN ACTUAL GROUND SURVEY MADE UNDER MY SUPERVISION; THE ORIGINAL DATA WAS OBTAINED ON JUNE 27, 2022 & JULY 1, 2022; AND THIS MAP MEETS MINIMUM ACCURACY STANDARDS UNLESS OTHERWISE NOTED.

AS-BUILT SURVEY
FOR
A. J. CONNER
SHOWING PLANTATION ROAD AREA WATERLINE REPLACEMENT PROJECT

CWA
CALDWELL WHITE ASSOCIATES
ENGINEERS / SURVEYORS / PLANNERS
4808 MELROSE AVENUE, NW
P.O. BOX 6880
ROANOKE, VIRGINIA 24017
(540) 366-3400 FAX: (540) 366-8702

DATE: JULY 1, 2022
W.O.: 21-0064

SCALE: 1"= 30'
N.B.: WVWA-4