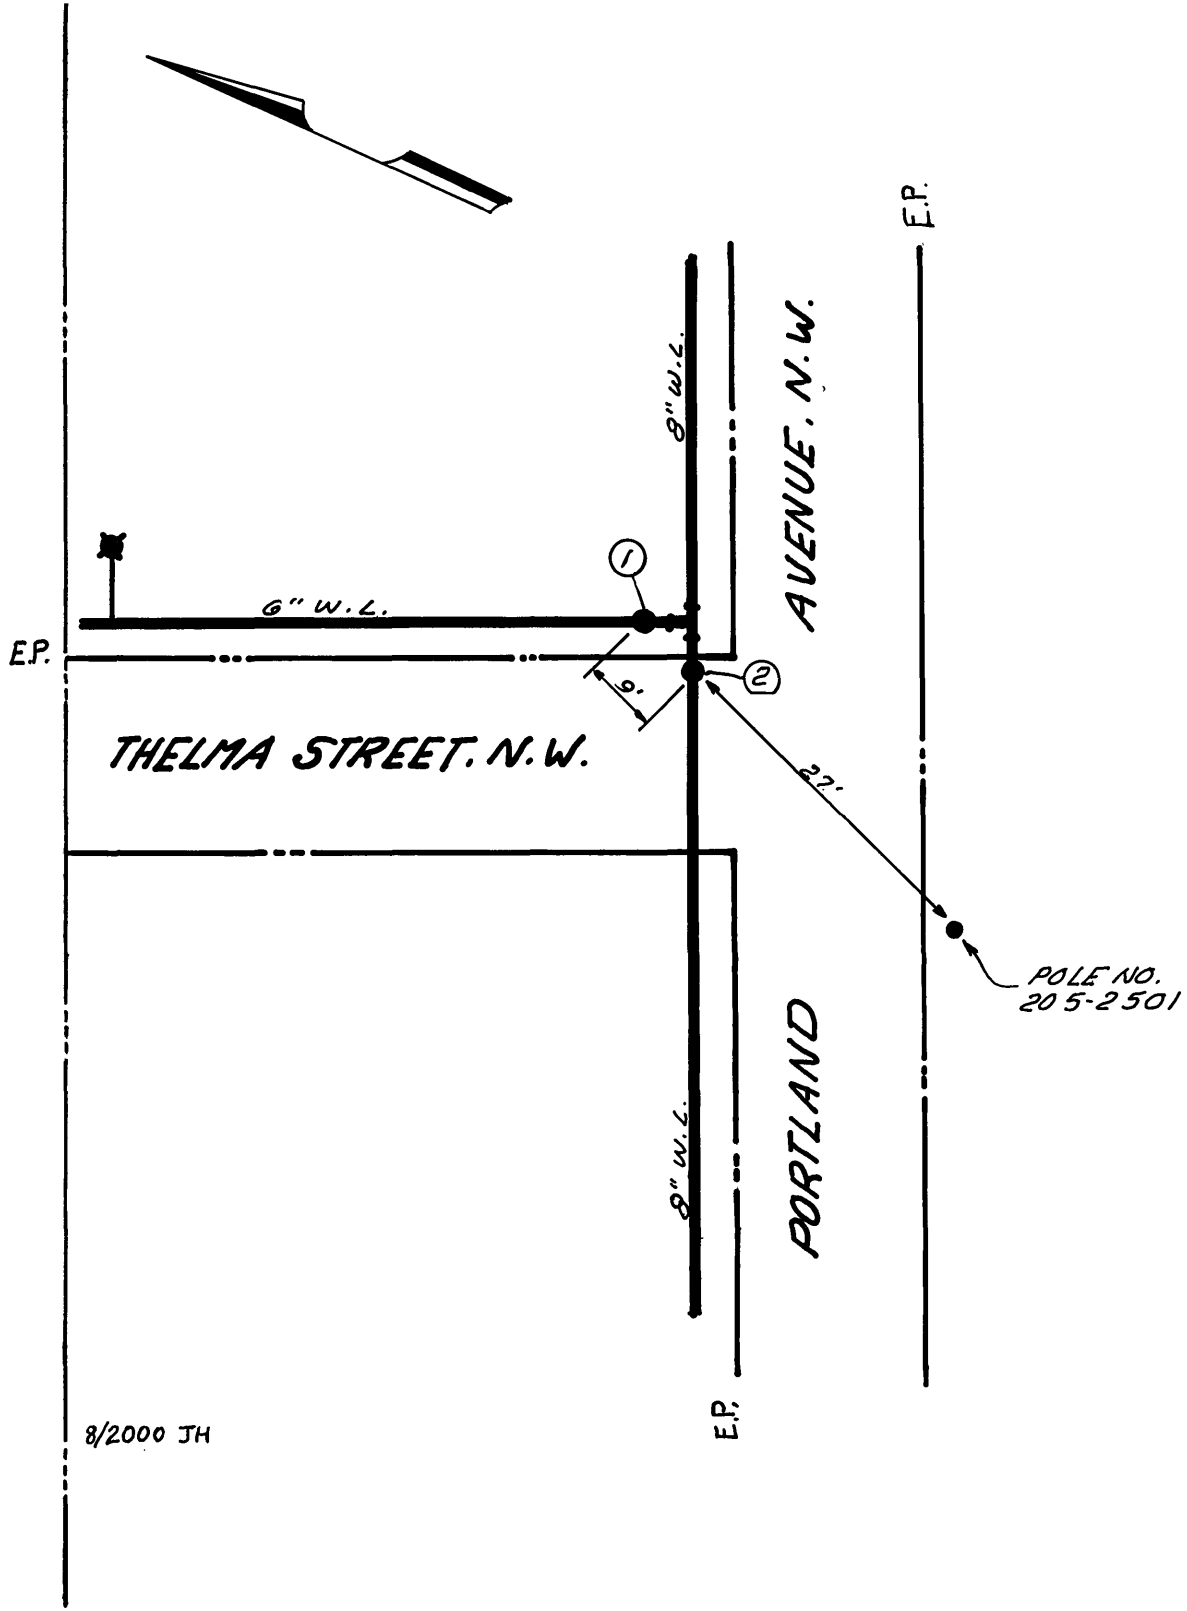

DATE	NO.	SIZE	MAKE	OPEN	TURNS
12/84	1	6"		R	20
12/84	2	8"		R	26

CITY OF ROANOKE—WATER DEP'T

VALVE DIAGRAM

PORTLAND AVENUE &

THELMA STREET

SEC. MAP 641, 642 N.W.

DATE 4-9-85 PAGE NO.