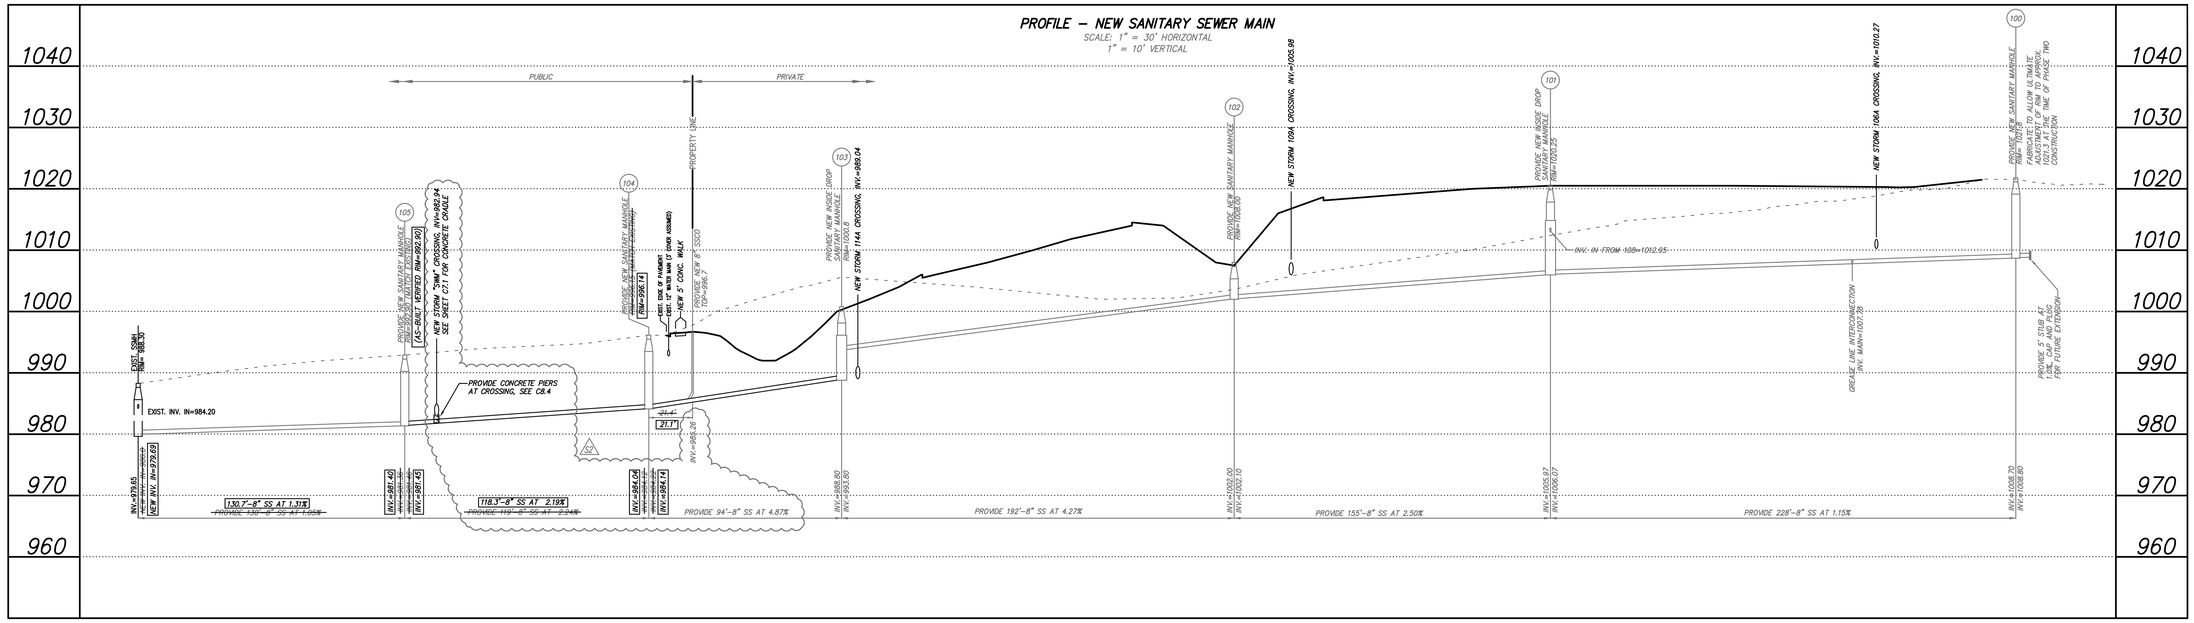


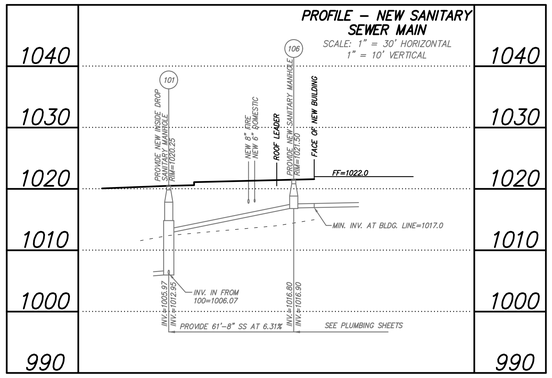


**AS-BUILT PLANS**

INFORMATION SHOWN HEREON "BOXED" REFLECTS AN AS-BUILT FIELD SURVEY OF THE PUBLIC PORTIONS OF NEW WATERLINE AND SANITARY SEWER CONSTRUCTION. FIELD SURVEY PERFORMED FEBRUARY 16, 2021 BY CALDWELL WHITE ASSOCIATES.

COMMONWEALTH OF VIRGINIA
CORBIN L. WHITE
License No. 23843
02-22-21
PROFESSIONAL ENGINEER

POPE ARCHITECTS

POPE ARCHITECTS, INC.
1295 BANDANA BLVD N, SUITE 200
ST. PAUL, MN 55108-2735

(651) 642-9200 | FAX (651) 642-1101
www.popearch.com

RICHFIELD LIVING
AT THE ROANOKE CAMPUS
Roanoke, Virginia

RICHFIELD

CWA
CALDWELL WHITE ASSOCIATES
ENGINEERS / SURVEYORS / PLANNERS
4809 MELROSE AVENUE
P.O. BOX 6860
ROANOKE, VIRGINIA 24017-0860
(540) 366-8400
FAX: (540) 366-8708

Scale: As Shown
W.O. 19-0034
Designed: C.L. White
Drawn: C.L. White

Key Plan

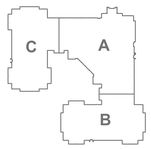


PROFILES - NEW SANITARY SEWER

Issues and Revisions:

| | |
|---|---|
| 04 / 19 / 2019 | DESIGN DEVELOPMENT ISSUE |
| 06 / 06 / 2019 | PERMIT SET |
| 2 08 / 13 / 2019 | PER 2ND CITY SITE REVIEW |

Commission No: 63132-18180
Drawn by:
Checked by:

SHEET

C7.2

30' 0' 30' 60'
1" = 30' GRAPHIC SCALE