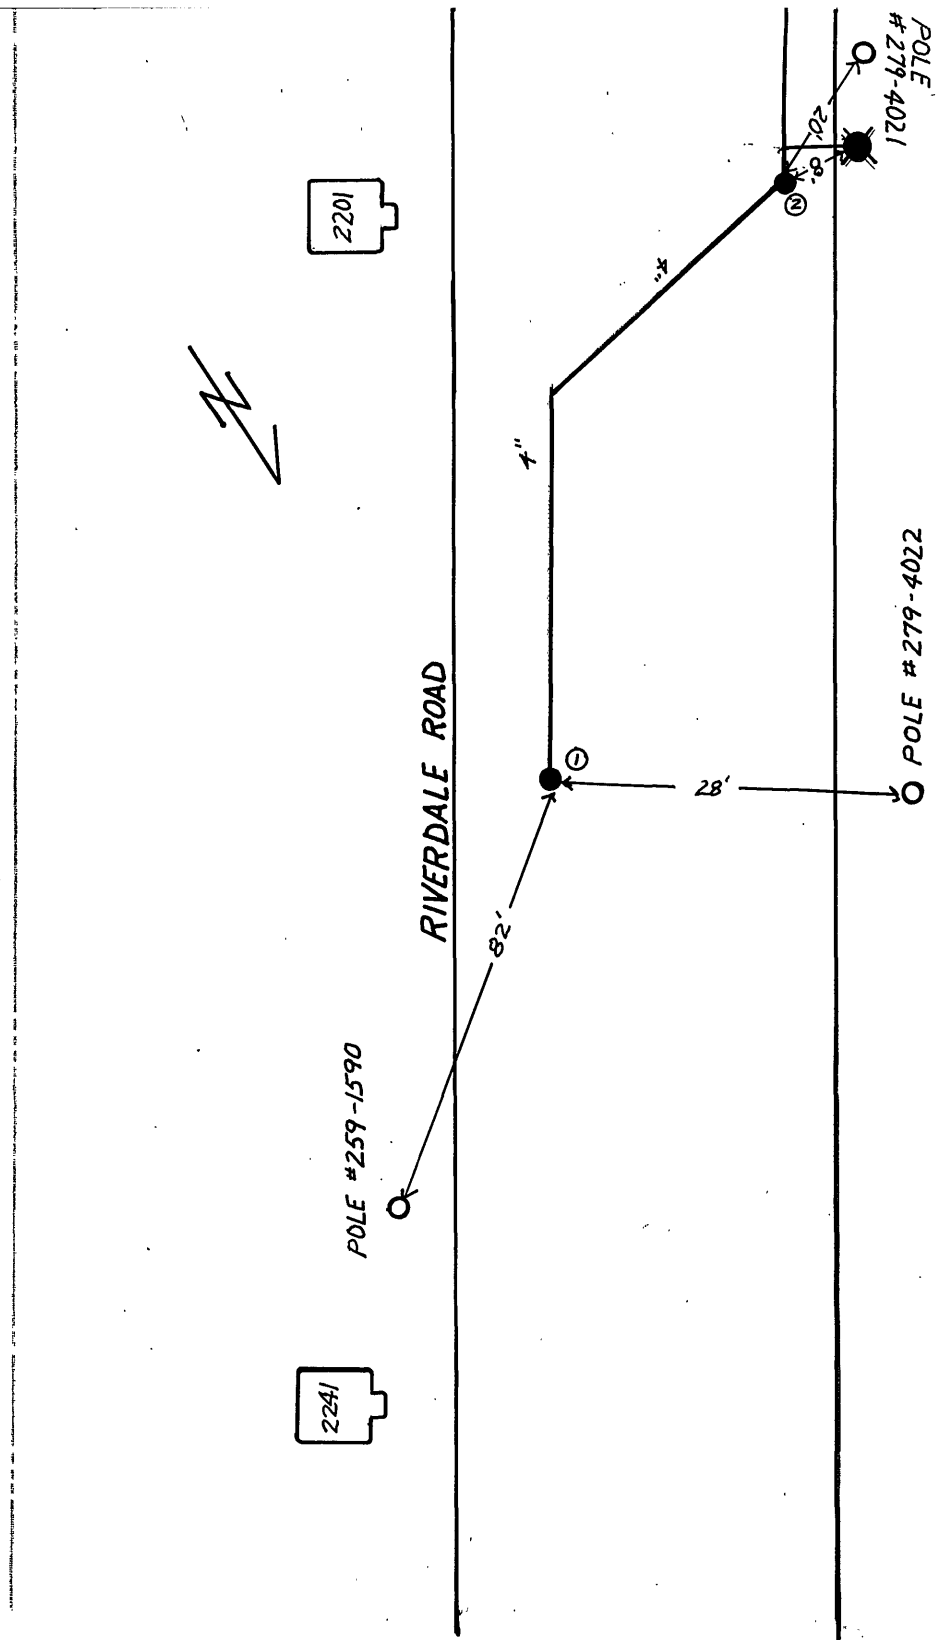

DATE	NO.	SIZE	MAKE	OPEN	TURNS
3-80	1	2"	MISC.	L	BLOW OFF
3-80	2	4"	MUELLER	R	

CITY OF ROANOKE—WATER DEPT.

VALVE DIAGRAM

2241 RIVERDALE RD. AND

2201 RIVERDALE RD.

S.E.

SEC. MAP 443

DATE PAGE NO.