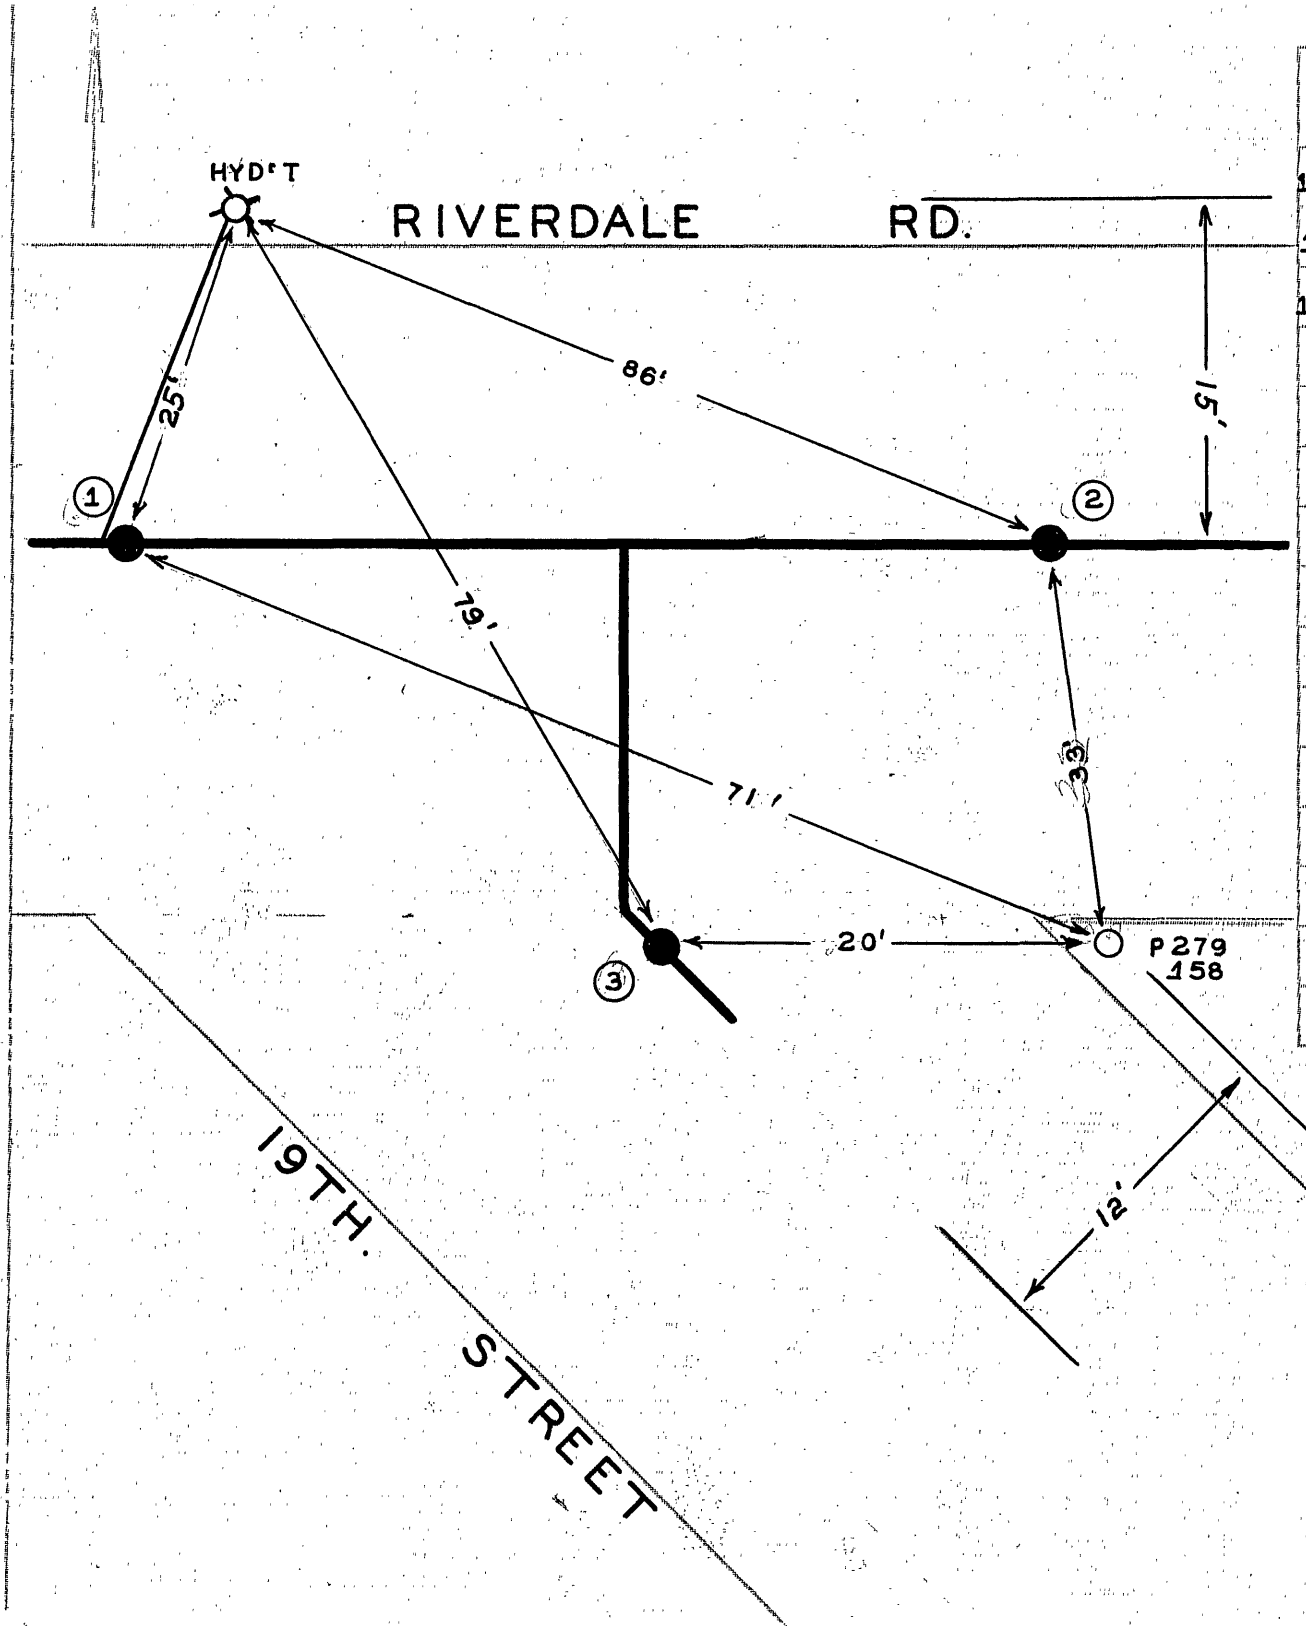

DATE	NO.	SIZE	MAKE	OPEN	TURNS
1949	1	8"	DARLING	R	27
1949	2	8"	DARLING	R	27
1949	3	8"	DARLING	R	27
	1	35'-E	WPL		
	2	50'-E	EPL		
	3	0	SPL		

CITY OF ROANOKE — WATER DEPT

VALVE DIAGRAM

RIVERDALE ROAD &
19TH. STREET S.E.

SEC. MAP 443

DATE 10/24/49 PAGE NO. S.E.95