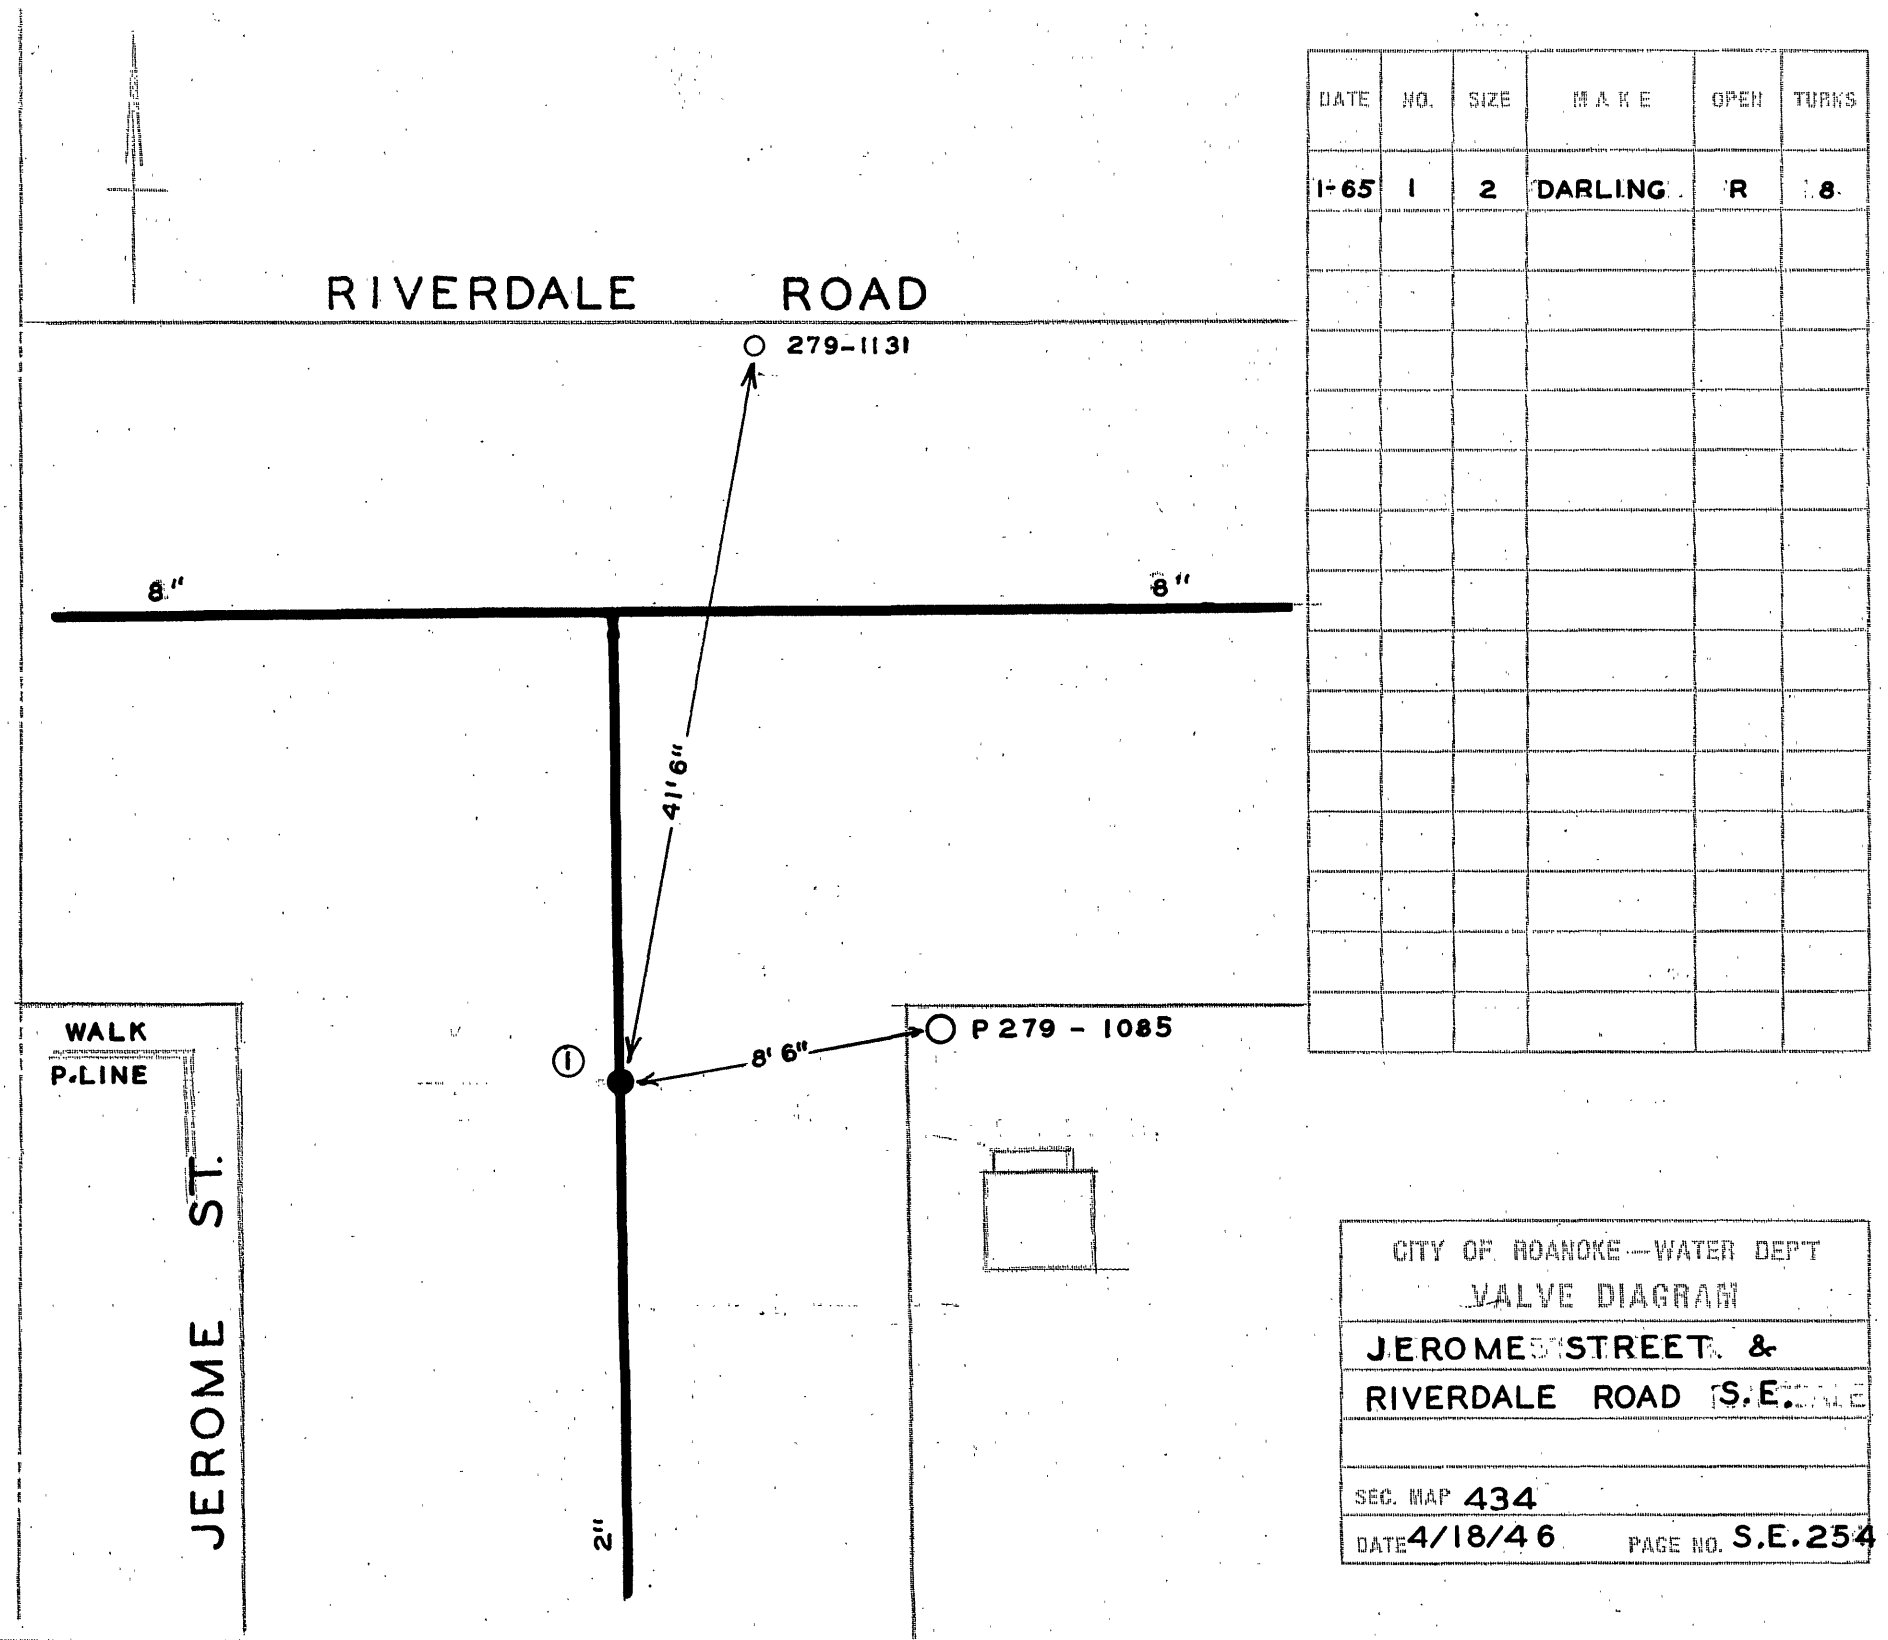

DATE	NO.	SIZE	MAKE	OPEN	TURNS
1-65	1	2	DARLING	R	8

CITY OF ROANOKE — WATER DEP'T

VALVE DIAGRAM

JEROME STREET & RIVERDALE ROAD S.E.

SEC. MAP 434

DATE 4/18/46 PAGE NO. S.E. 254