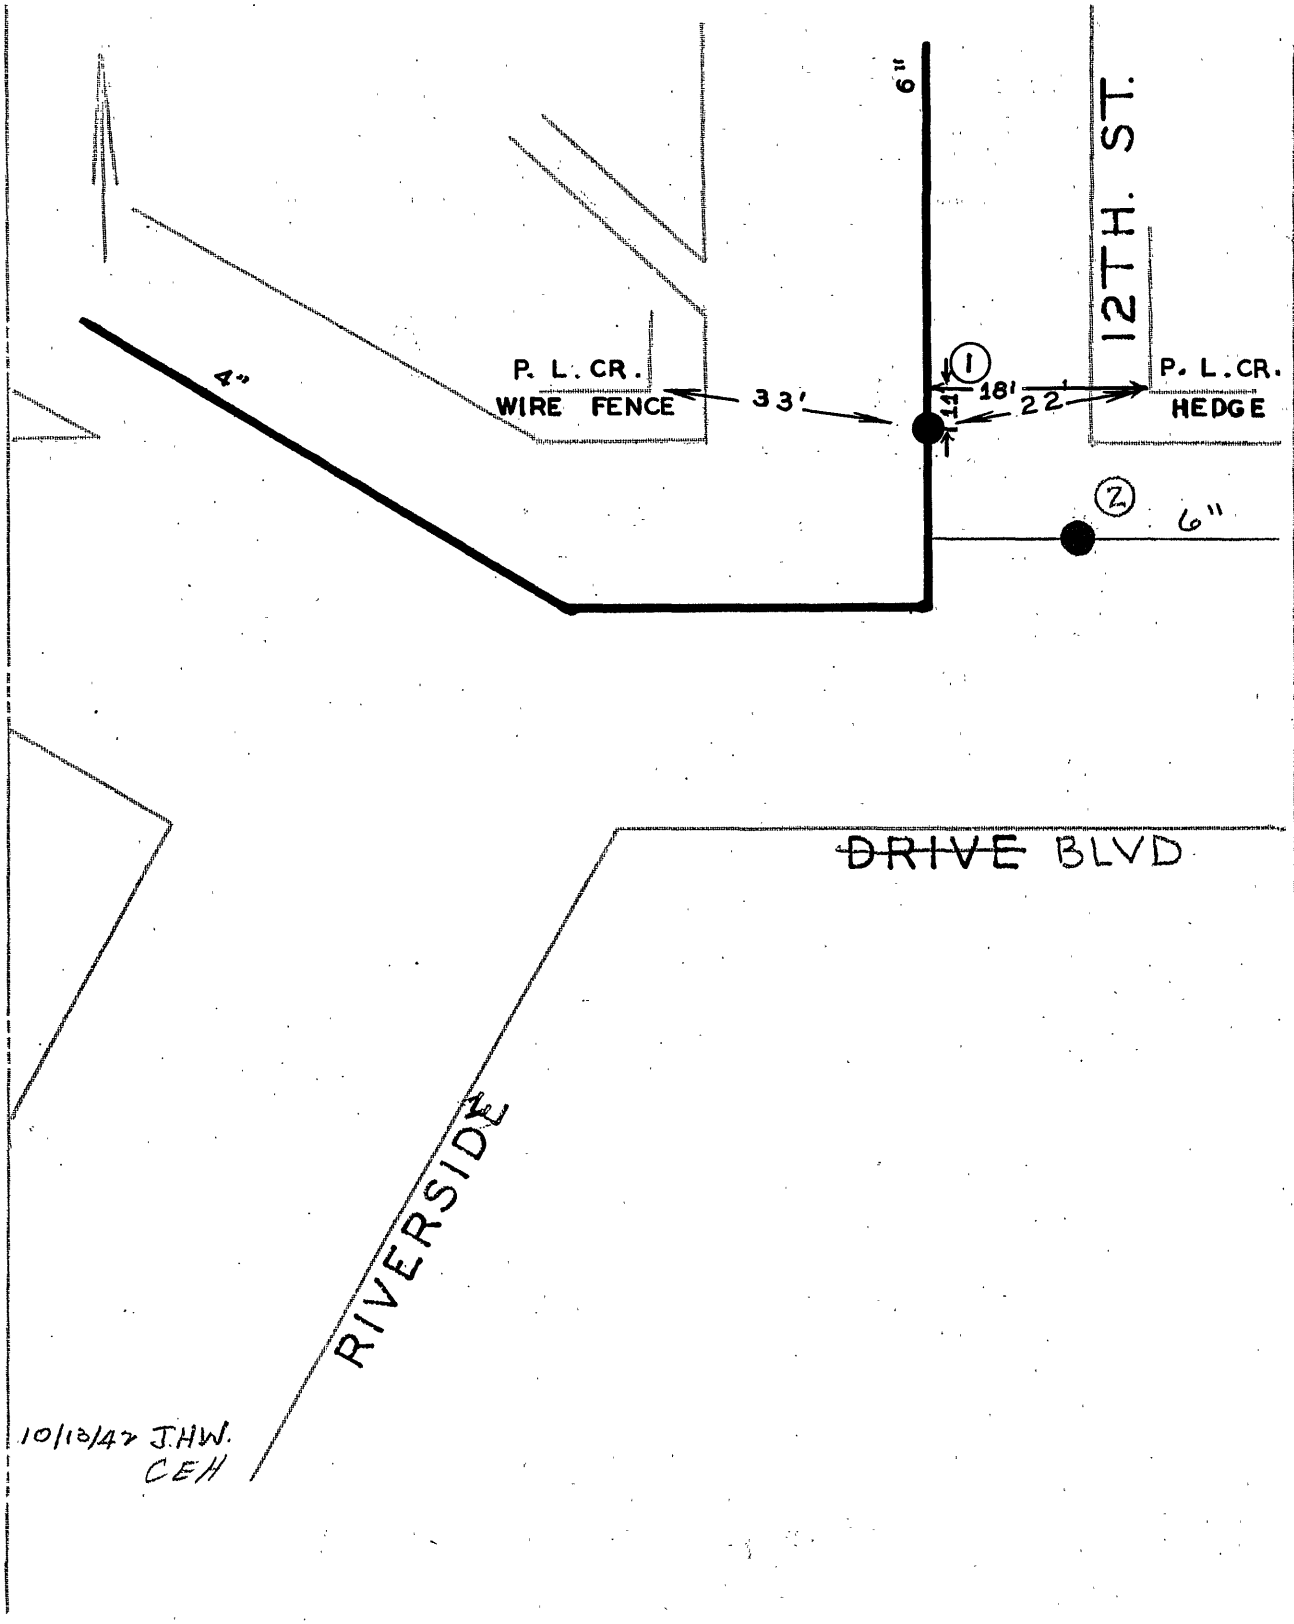


| DATE | NO. | SIZE | MAKE | OPEN | TURNS |
|---|---|---|---|---|---|
| 1910 | 1 | 6" | | R | 13 1/2 |
| 1994 | 2 | 6" | | | |
| | | | | | |
| | | | | | |
| | 1 | 11'-S | NPL | | |
| | | | | | |

CITY OF ROANOKE—WATER DEP'T

VALVE DIAGRAM

RIVERSIDE ~~DRIVE~~ BLVD & 12TH ST. S. W.

SEC. MAP 122

DATE

PAGE NO. S.W.197