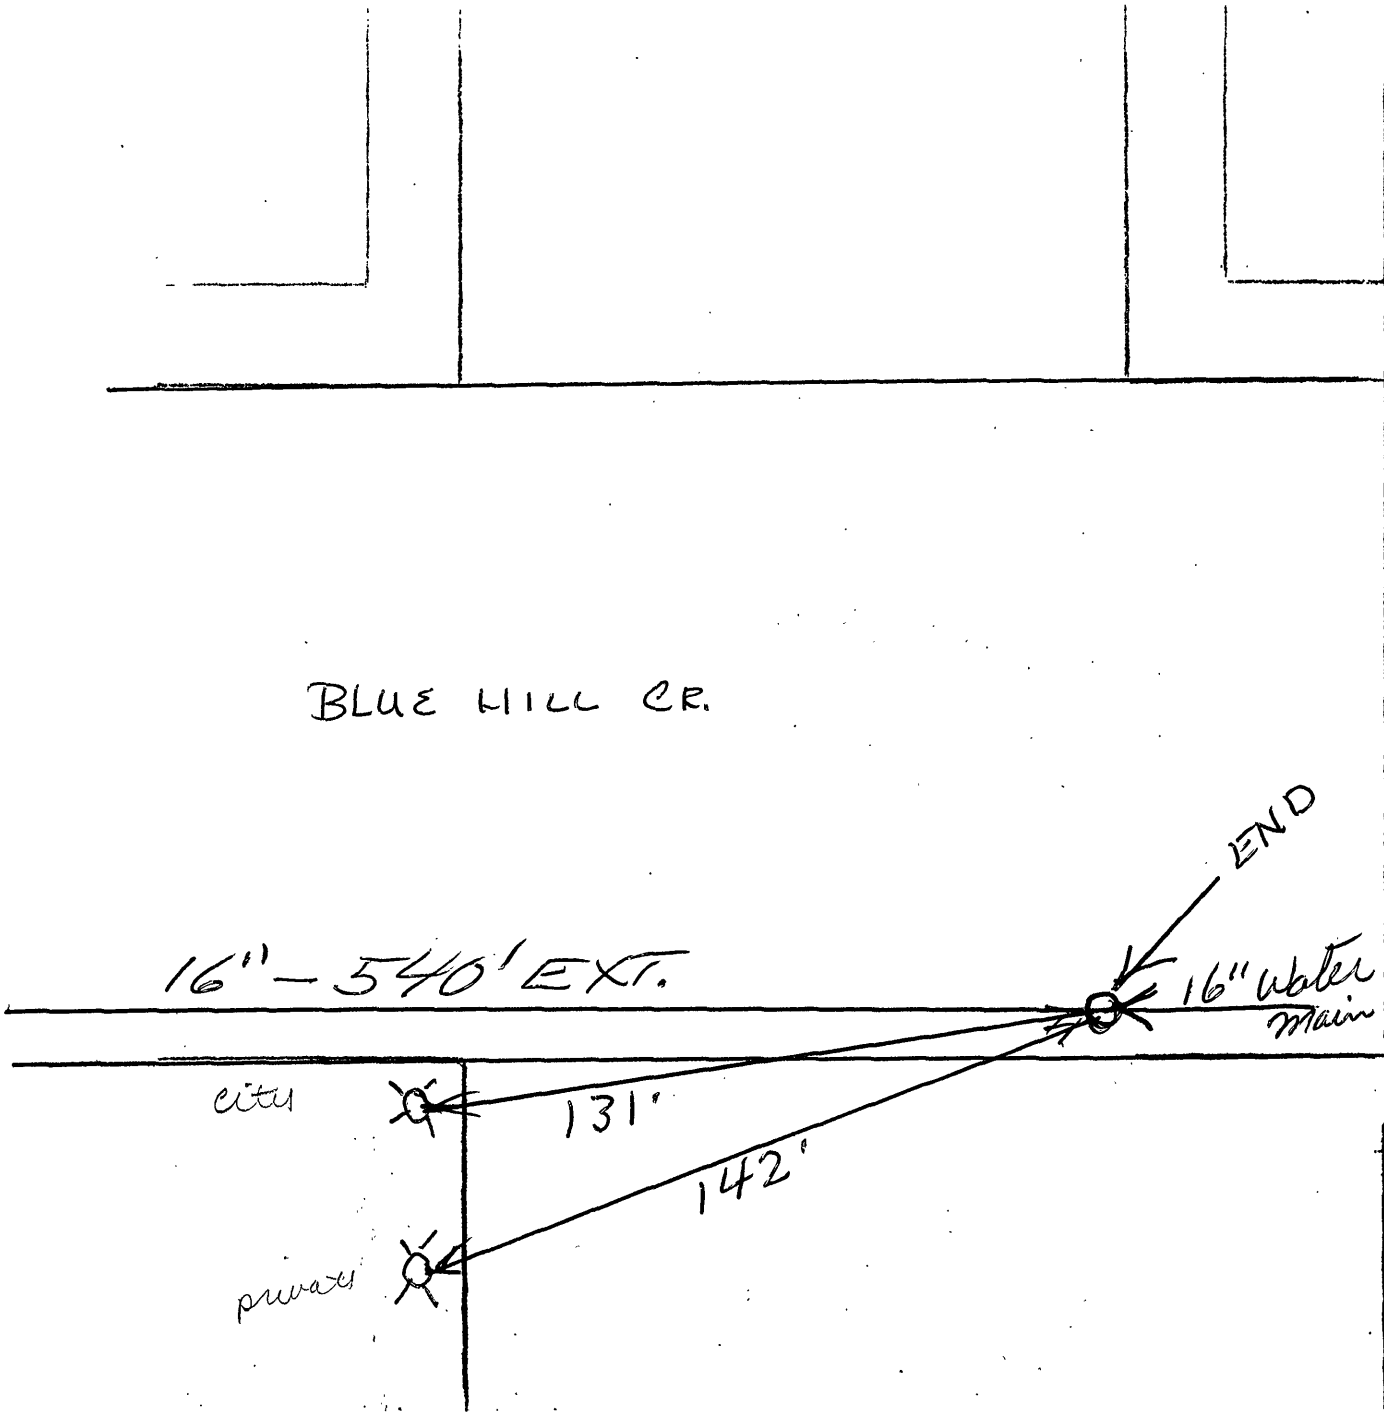

DATE	NO.	SIZE	MAKE	OPEN	TURNS
3-91	1	2"	Misc	L	—

P. L. Measurements		
No.	Distance	Direction

CITY OF ROANOKE - WATER DEPT.

VALVE DIAGRAM

BLUE HILLS CIRCLE

End of 16" Main

Sec. Map

Date 3-91 Page No.

plan #91-01

Done