




Roanoke / Richmond
New River Valley / Staunton
Harrisonburg / Lynchburg
www.balzer.cc

1208 Corporate Circle
Roanoke, VA 24018
540.772.9580

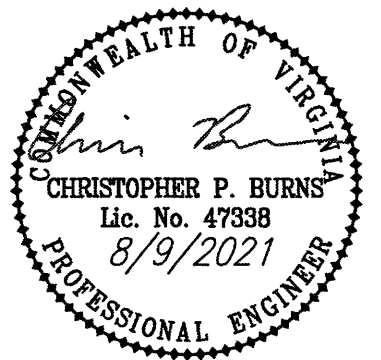

ROANOKE HILLS


UTILITY PLAN

3641 & 3661 BLUE HILLS VILLAGE DR NE
CITY OF ROANOKE, VIRGINIA


DRAWN BY	SMD
DESIGNED BY	BTC
CHECKED BY	BTC
DATE	2/25/2021
SCALE	1" = 20'
REVISIONS	
3/31/2021	
4/15/2021	
P.R. #1 7/14/2021	
P.R. #2 8/9/2021	

C6

PROJECT NO. 04190070.00

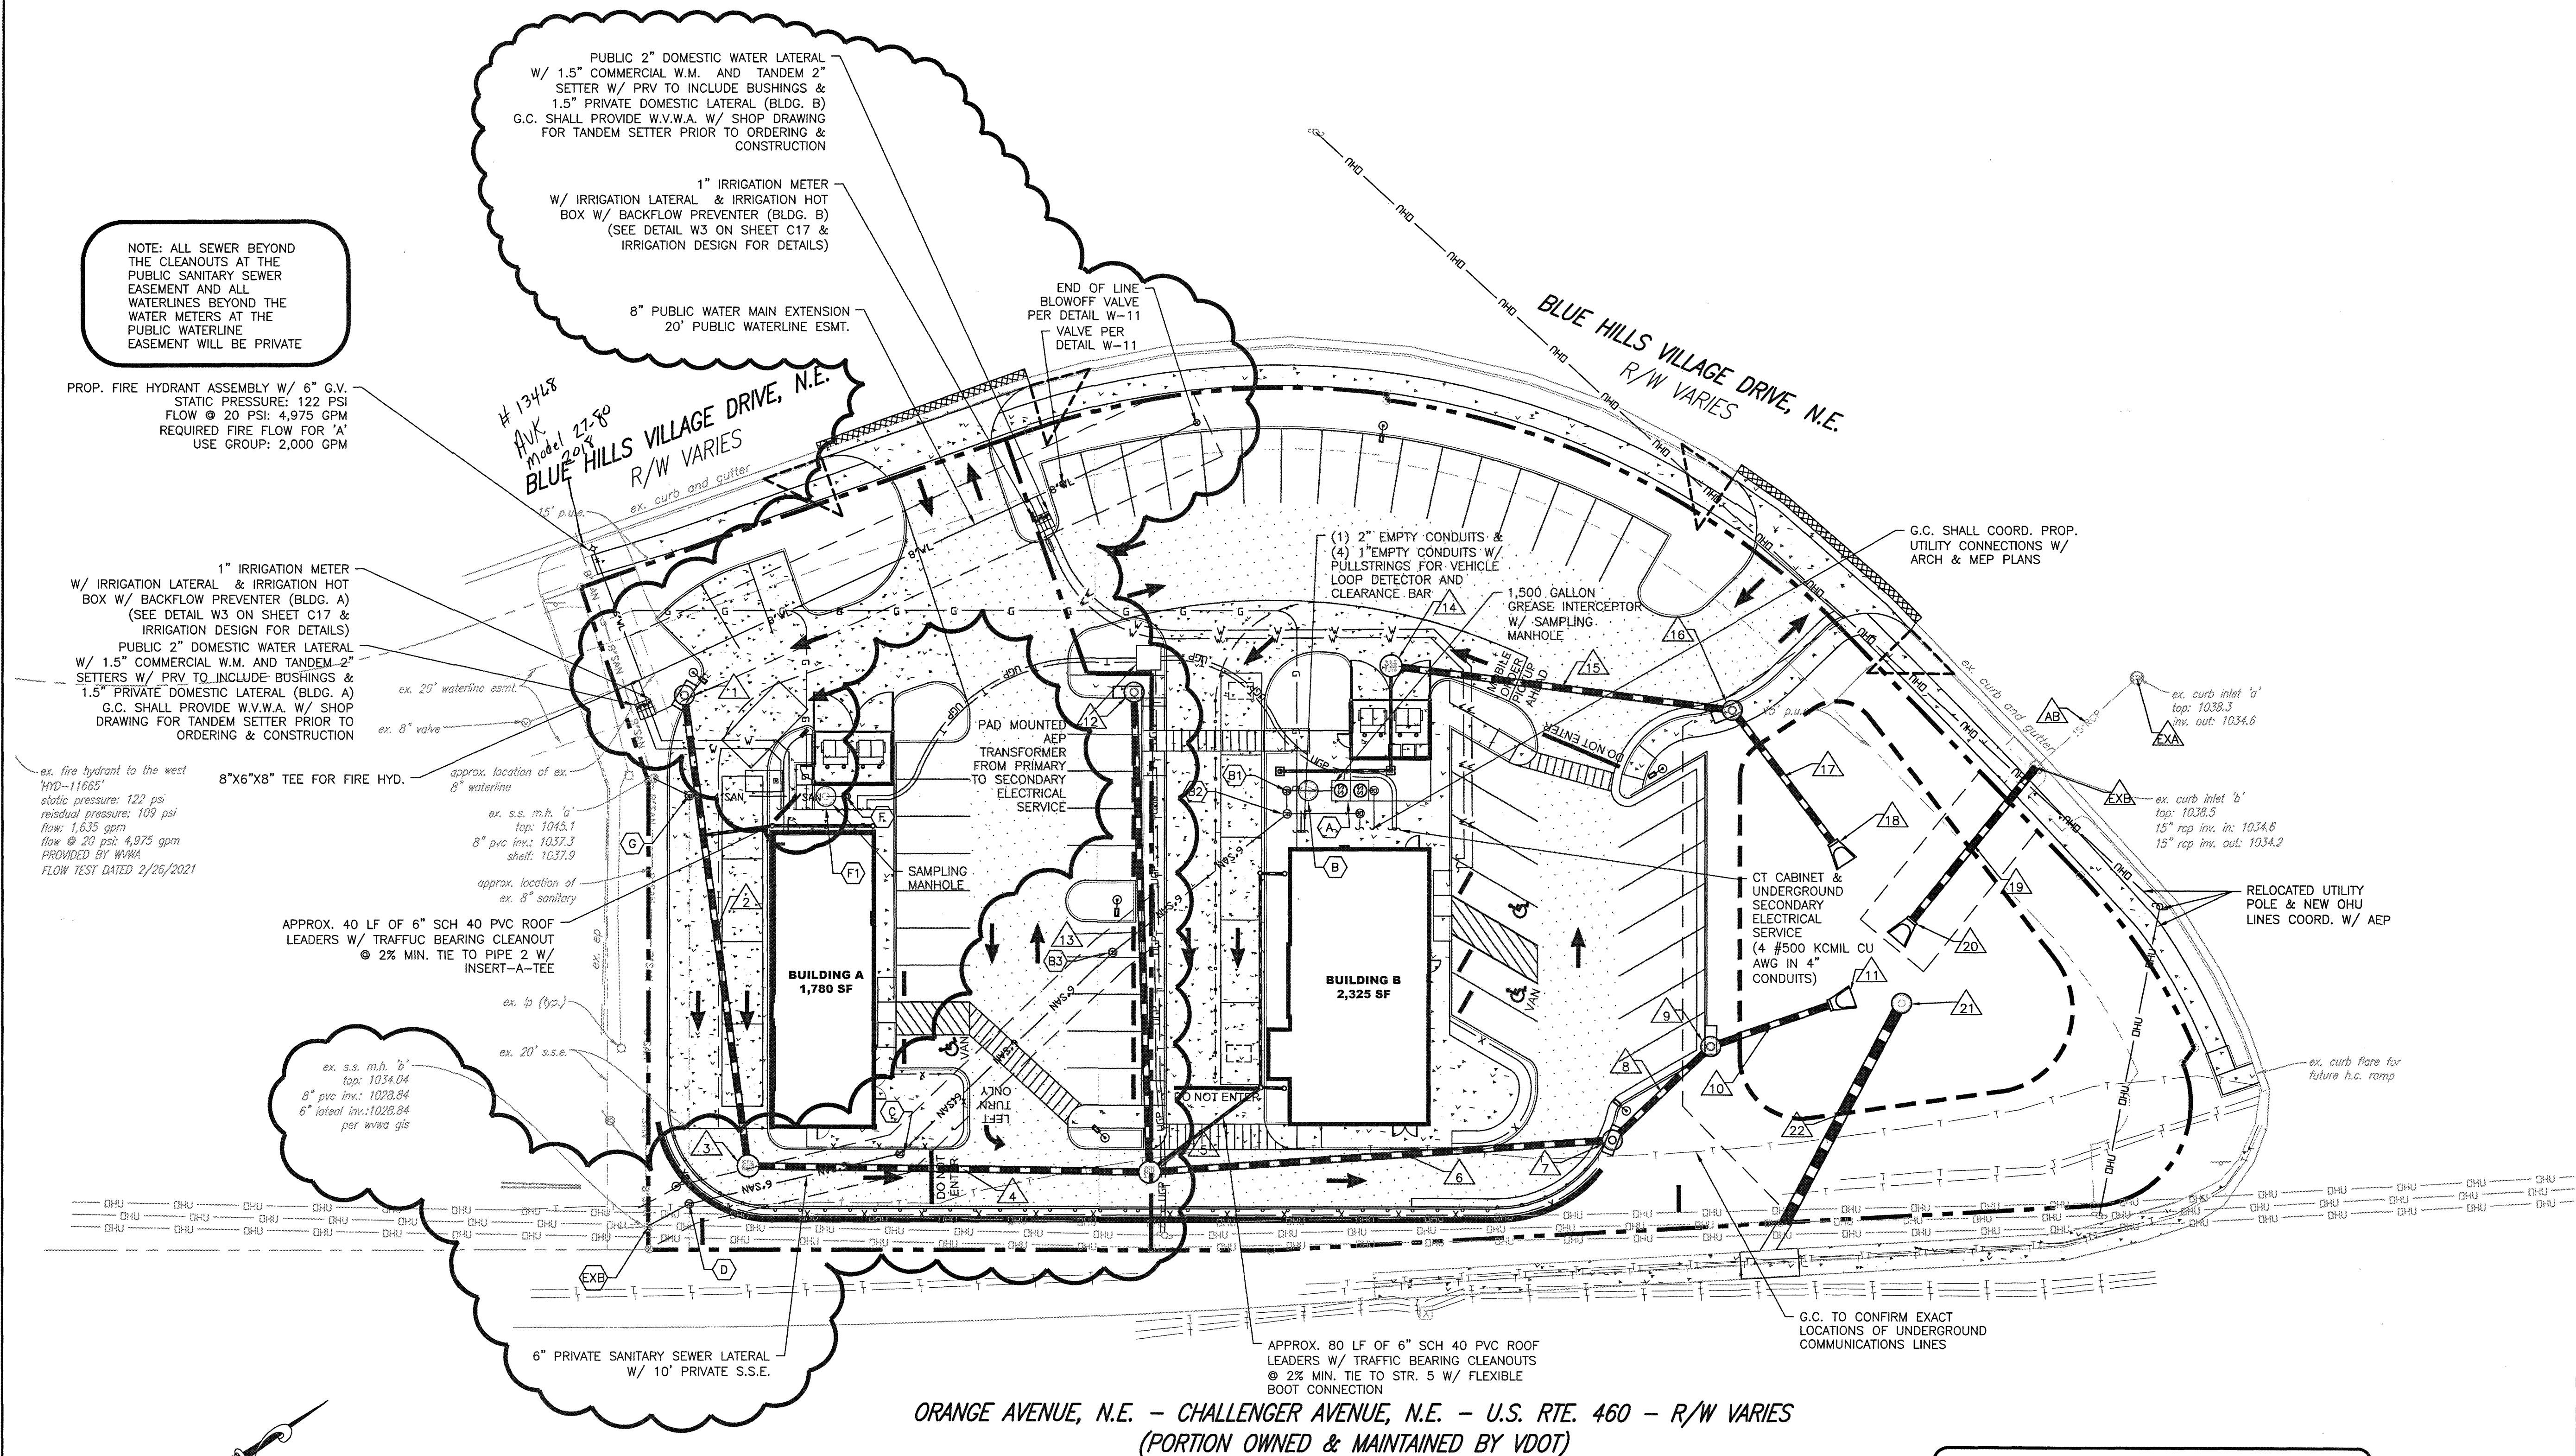

* WORK IN THE PUBLIC RIGHT OF * WAY AREA SHALL BE PERFORMED PER THE CITY OF ROANOKE RIGHT OF WAY EXCAVATION & RESTORATION STANDARDS REVISED JULY 1, 2020. G.C. SHALL OBTAIN A R.O.W. EXCAVATION PERMIT PRIOR TO ANY WORK WITHIN THE PUBLIC RIGHT OF WAY

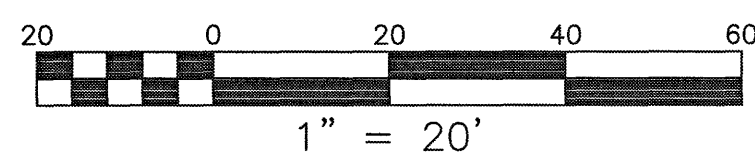

U:\19\0706\04\19070 00 LITTLE CAESARS CONCEPT - BLUE HILLS\CIVIL\dwg\04\19070 00 Subdivision Exhibit 7.15.2021.dwg PLOTTED: 8/10/2021 8:08:55 AM