XREF DRAWING 26444-330-305-UT1
05/29/97 18:06:16 RCD-12

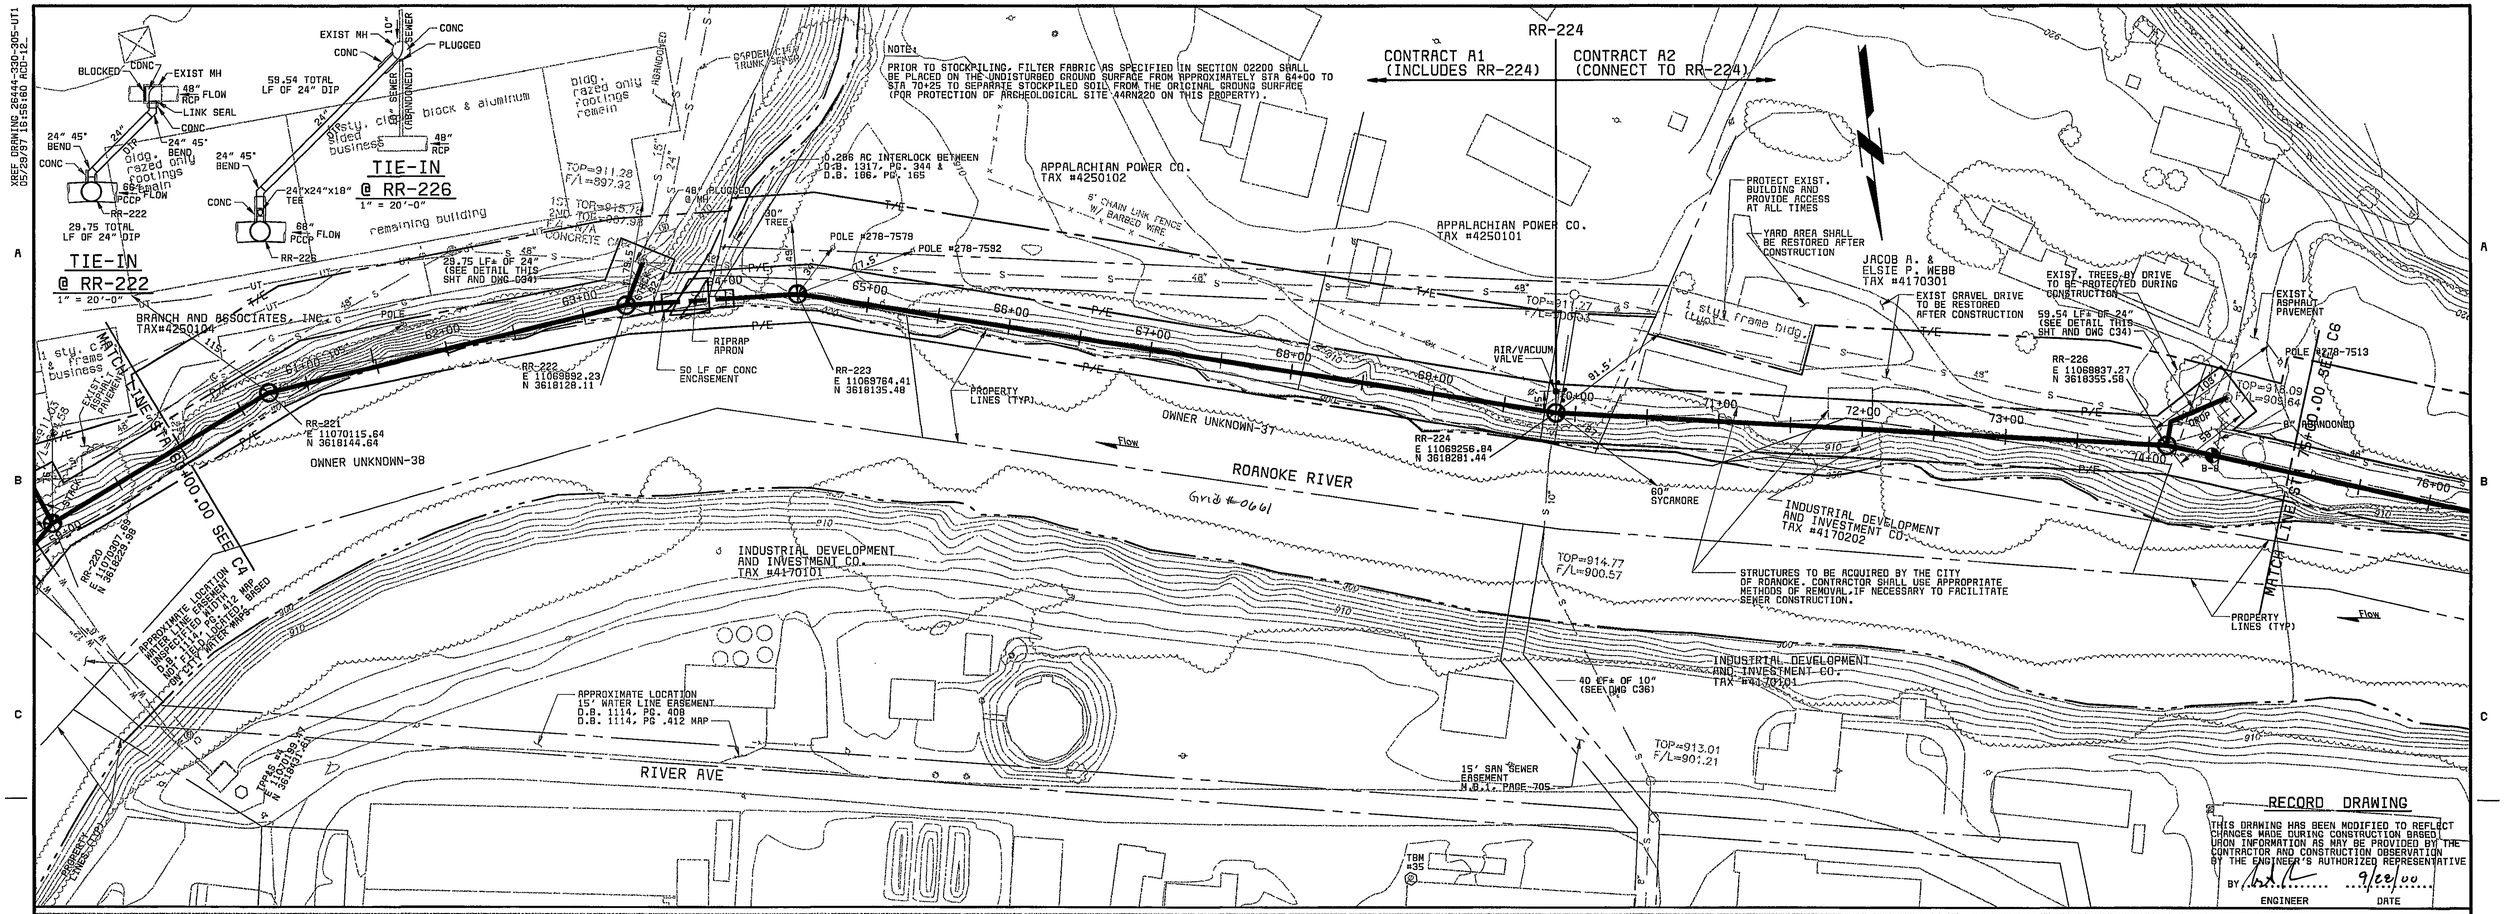

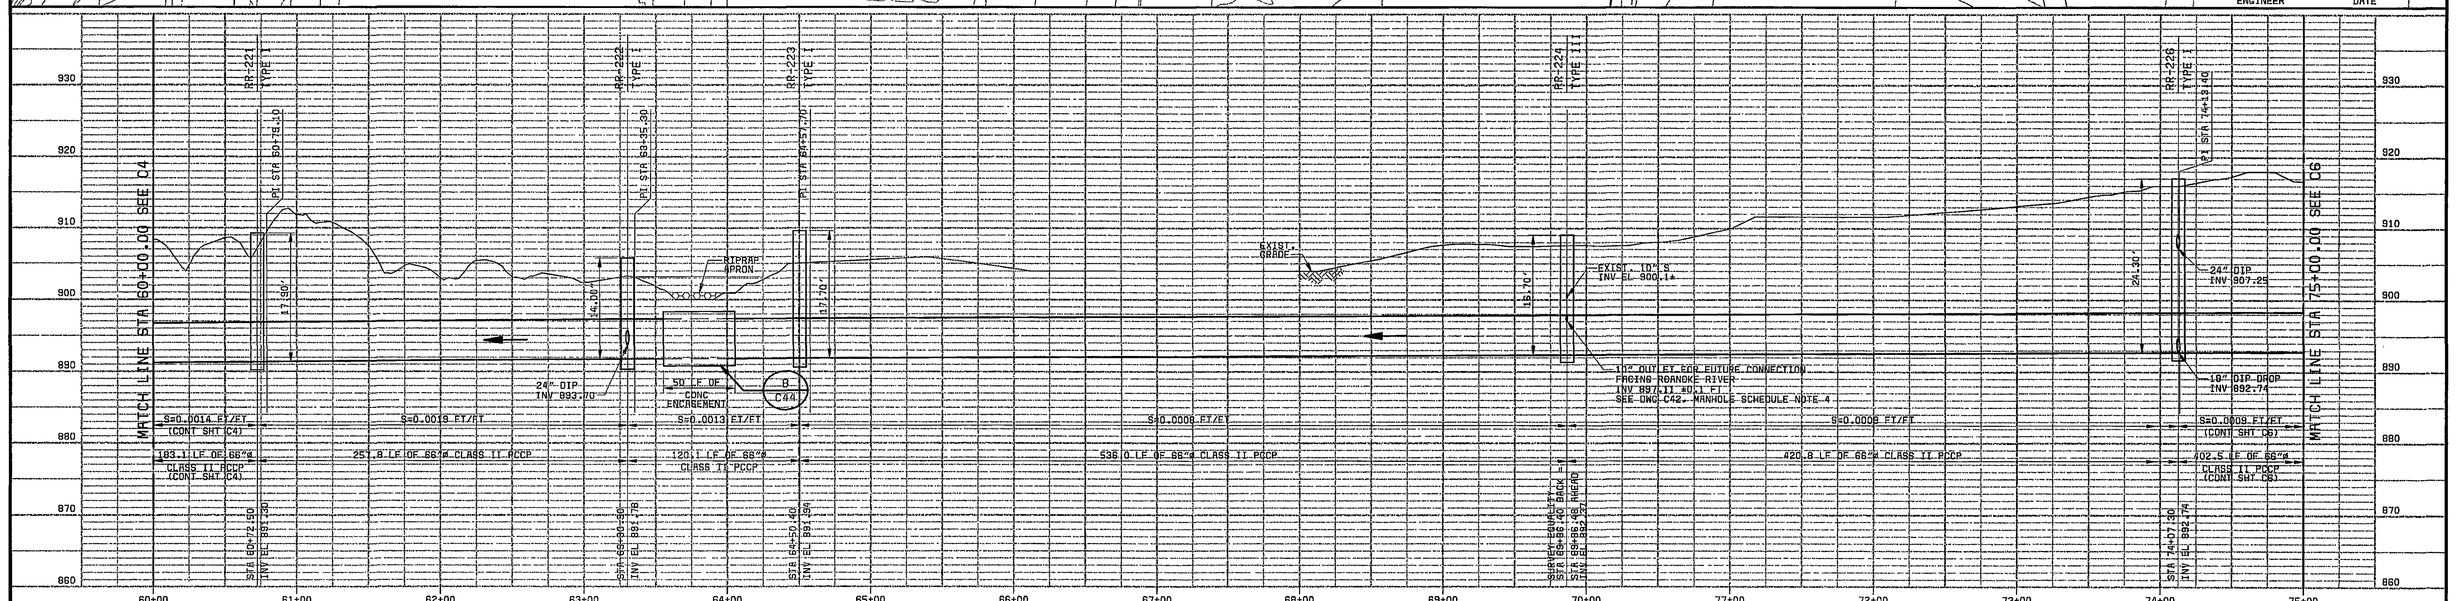

MANHOLE STATIONING AND PIPE LENGTHS: SEE GENERAL NOTE 16

PCCP PIPE CLASS INFORMATION: SEE DRAWING C43

SCALE: 1" = 50' HORIZ
1" = 10' VERT

RECORD DRAWING

THIS DRAWING HAS BEEN MODIFIED TO REFLECT CHANGES MADE DURING CONSTRUCTION BASED UPON INFORMATION AS MAY BE PROVIDED BY THE CONTRACTOR AND CONSTRUCTION OBSERVATION BY THE ENGINEER'S AUTHORIZED REPRESENTATIVE

BY 9/22/00
ENGINEER DATE

DATE	REVISIONS AND RECORD OF ISSUE	NO.	BY	CK	APP

DESIGNED JBB, SLF
DETAILED RLC, ABW
CHECKED RAF
APPROVED
DATE

Black & Veatch
Charlotte, North Carolina

PROJECT NO. 26444

CITY OF ROANOKE, VIRGINIA
ROANOKE RIVER INTERCEPTOR

PLAN AND PROFILE
STA 60+00 TO STA 75+00

THIS DOCUMENT ORIGINALLY ISSUED AND SEALED BY BRENT W. REUSS PROFESSIONAL ENGINEER, COMMONWEALTH OF VIRGINIA REGISTRATION NO. 026345 ON 5/30/97

CONTRACT A1,A2
C5

SHEET 8 OF 30

26444-300-WWCG-C-B0000011H
G1031
FG0000