XREF DRAWING 26444-300-WWTUP-C-B000003U3
12/12/2000 08:04:02 RCD

RECORD DRAWING

THIS DRAWING HAS BEEN MODIFIED TO REFLECT CHANGES MADE DURING CONSTRUCTION BASED UPON INFORMATION AS MAY BE PROVIDED BY THE CONTRACTOR AND CONSTRUCTION OBSERVATION BY THE ENGINEER'S AUTHORIZED REPRESENTATIVE

BY ..... ENGINEER ..... DATE

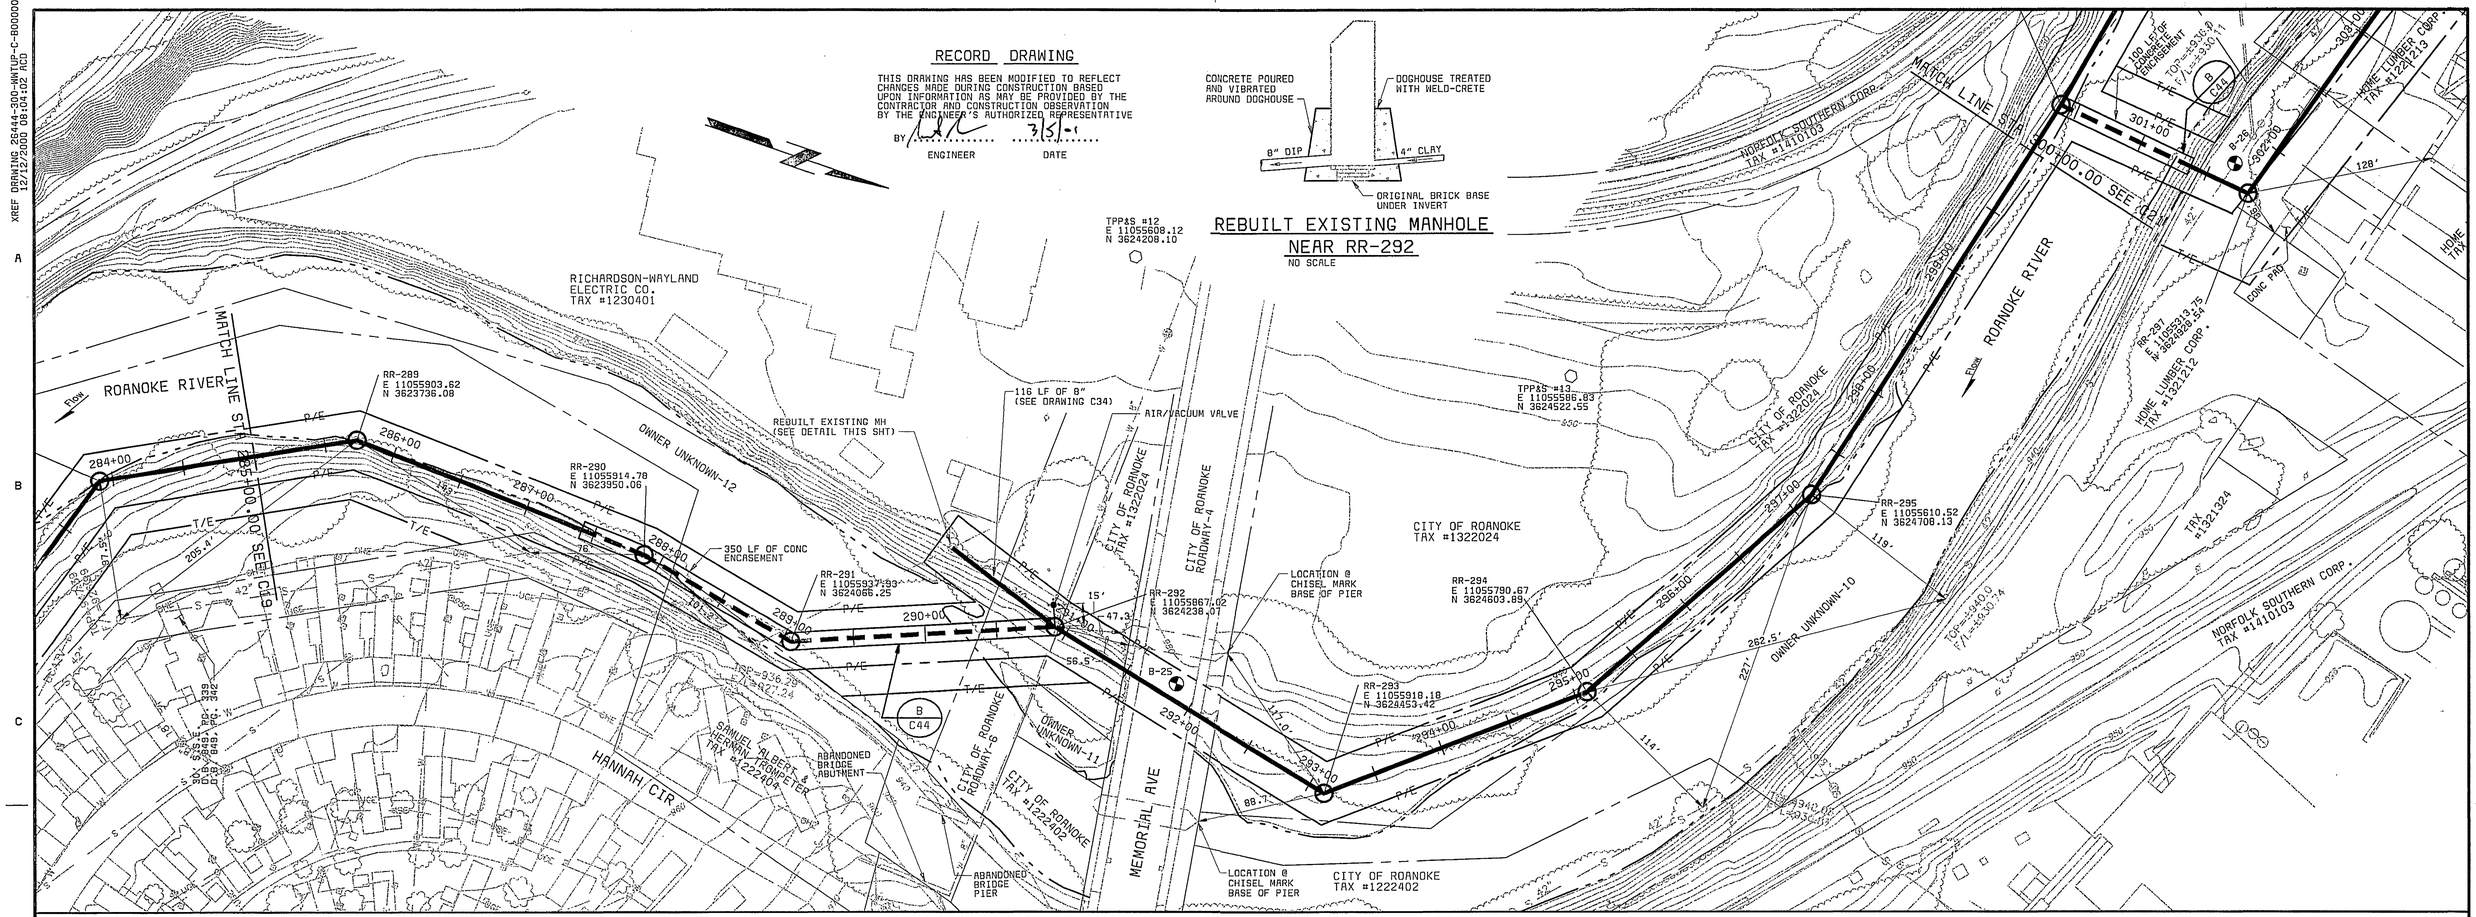

PCCP PIPE CLASS INFORMATION:
SEE DRAWING C43

SCALE: 1" = 50' HORIZ
1" = 10' VERT

DATE	REVISIONS AND RECORD OF ISSUE	NO.	BY	CK	APP

DESIGNED JBB, SLF
DETAILED RLC, ABW
CHECKED RAF
APPROVED
DATE

Black & Veatch
Charlotte, North Carolina

PROJECT NO. 26444

CITY OF ROANOKE, VIRGINIA
ROANOKE RIVER INTERCEPTOR

PLAN AND PROFILE
STA 285+00 TO STA 300+00

THIS DOCUMENT ORIGINALLY ISSUED AND SEALED BY BRENT M. REUSS PROFESSIONAL ENGINEER, COMMONWEALTH OF VIRGINIA REGISTRATION NO. 026345 ON 12/29/97

CONTRACT C

C20

SHEET 5 OF 23

26444-300-WWTUP-C-B000003U8
01031
FE000000