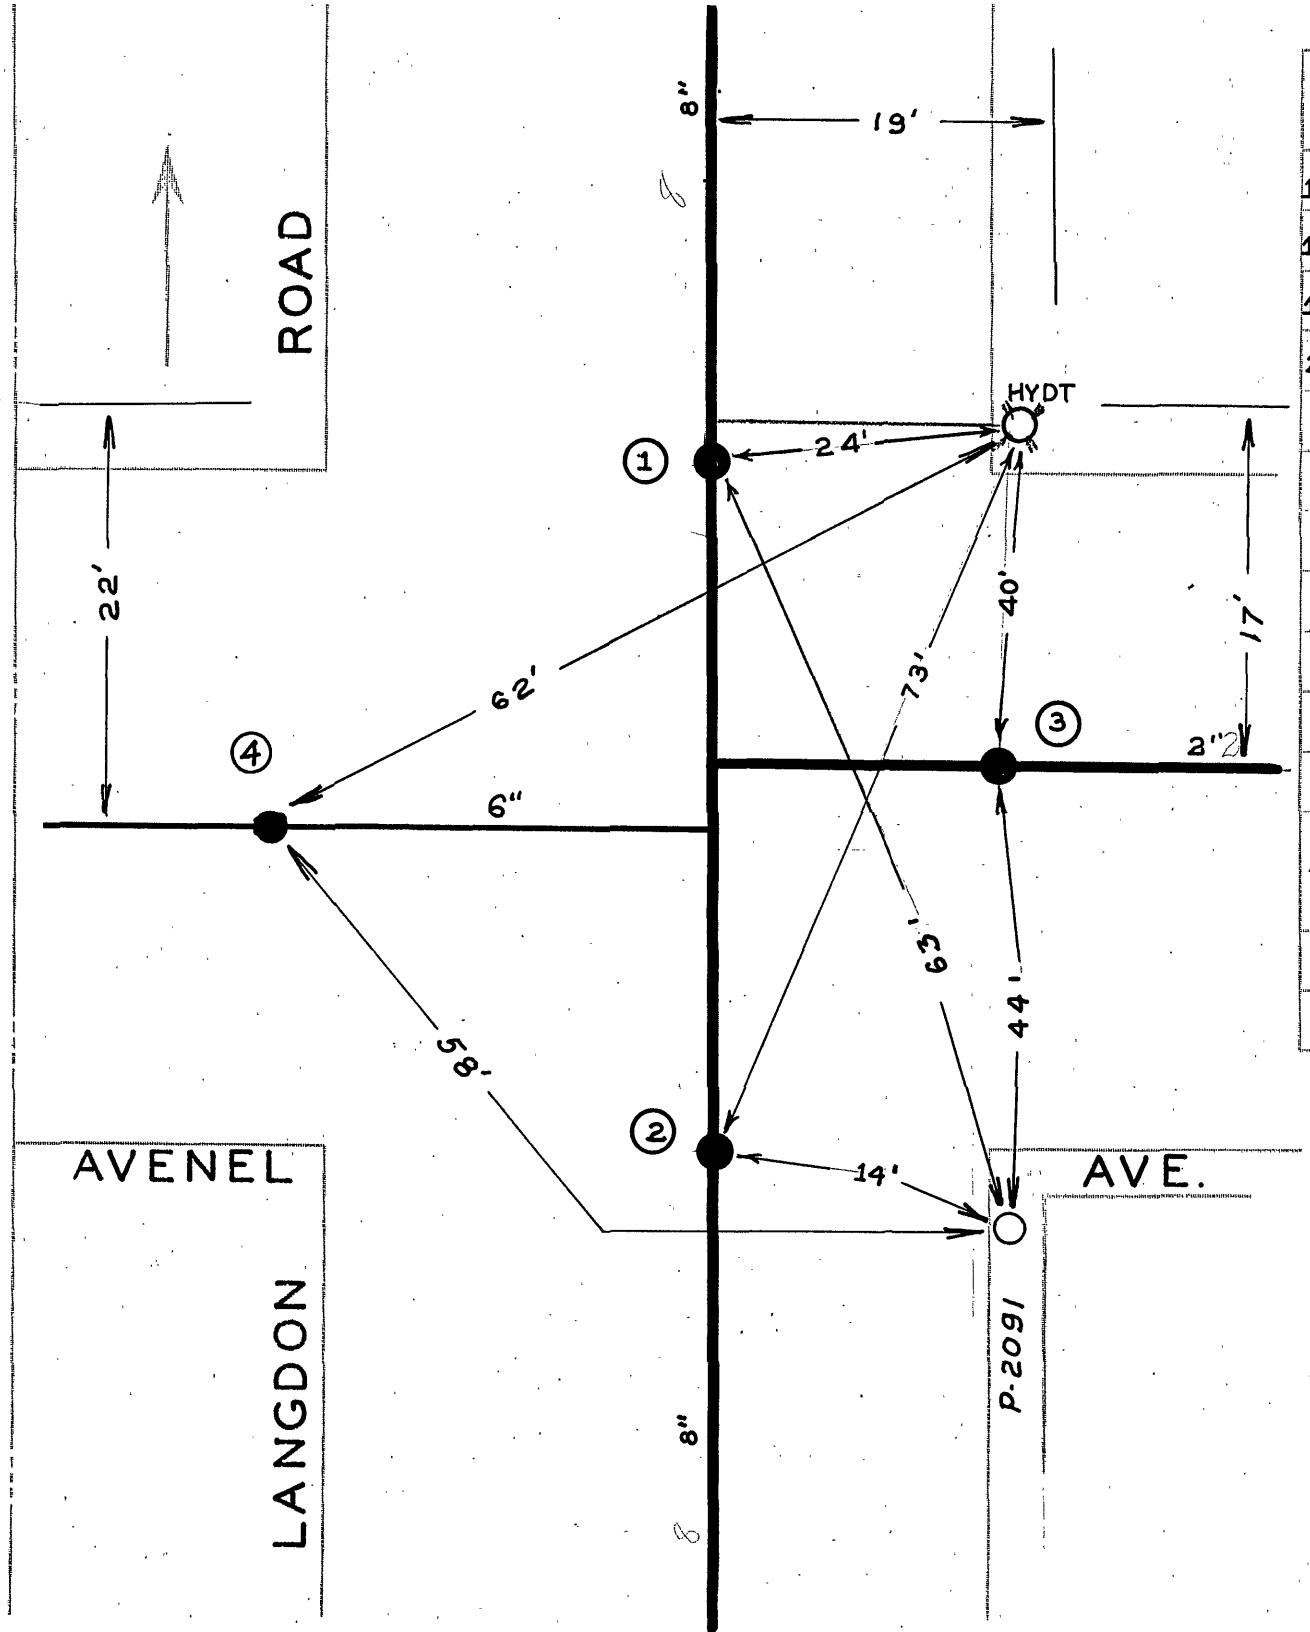


| DATE | NO. | SIZE | MAKE | OPEN | TURNS |
|---|---|---|---|---|---|
| 1948 | 1 | 8" | DARLING | R | 27 |
| 1948 | 2 | 8" | DARLING | R | 27 |
| 1948 | 3 | 2" | DARLING | R | 7 |
| 2-52 | 4 | 6" | | | |
| | | | | | |
| | | | | | |
| | | | | | |
| | | | | | |
| | | | | | |
| | | | | | |
| | 1 | 0 | NPL | | |
| | 2 | 0 | SPL | | |
| | 3 | 0 | EPL | | |
| | 4 | 0 | WPL | | |
| | | | | | |

CITY OF ROANOKE—WATER DEP'T

VALVE DIAGRAM

AVENEL AVENUE &

LANGDON ROAD S.W.

SEC. MAP 162

DATE PAGE NO. SW556