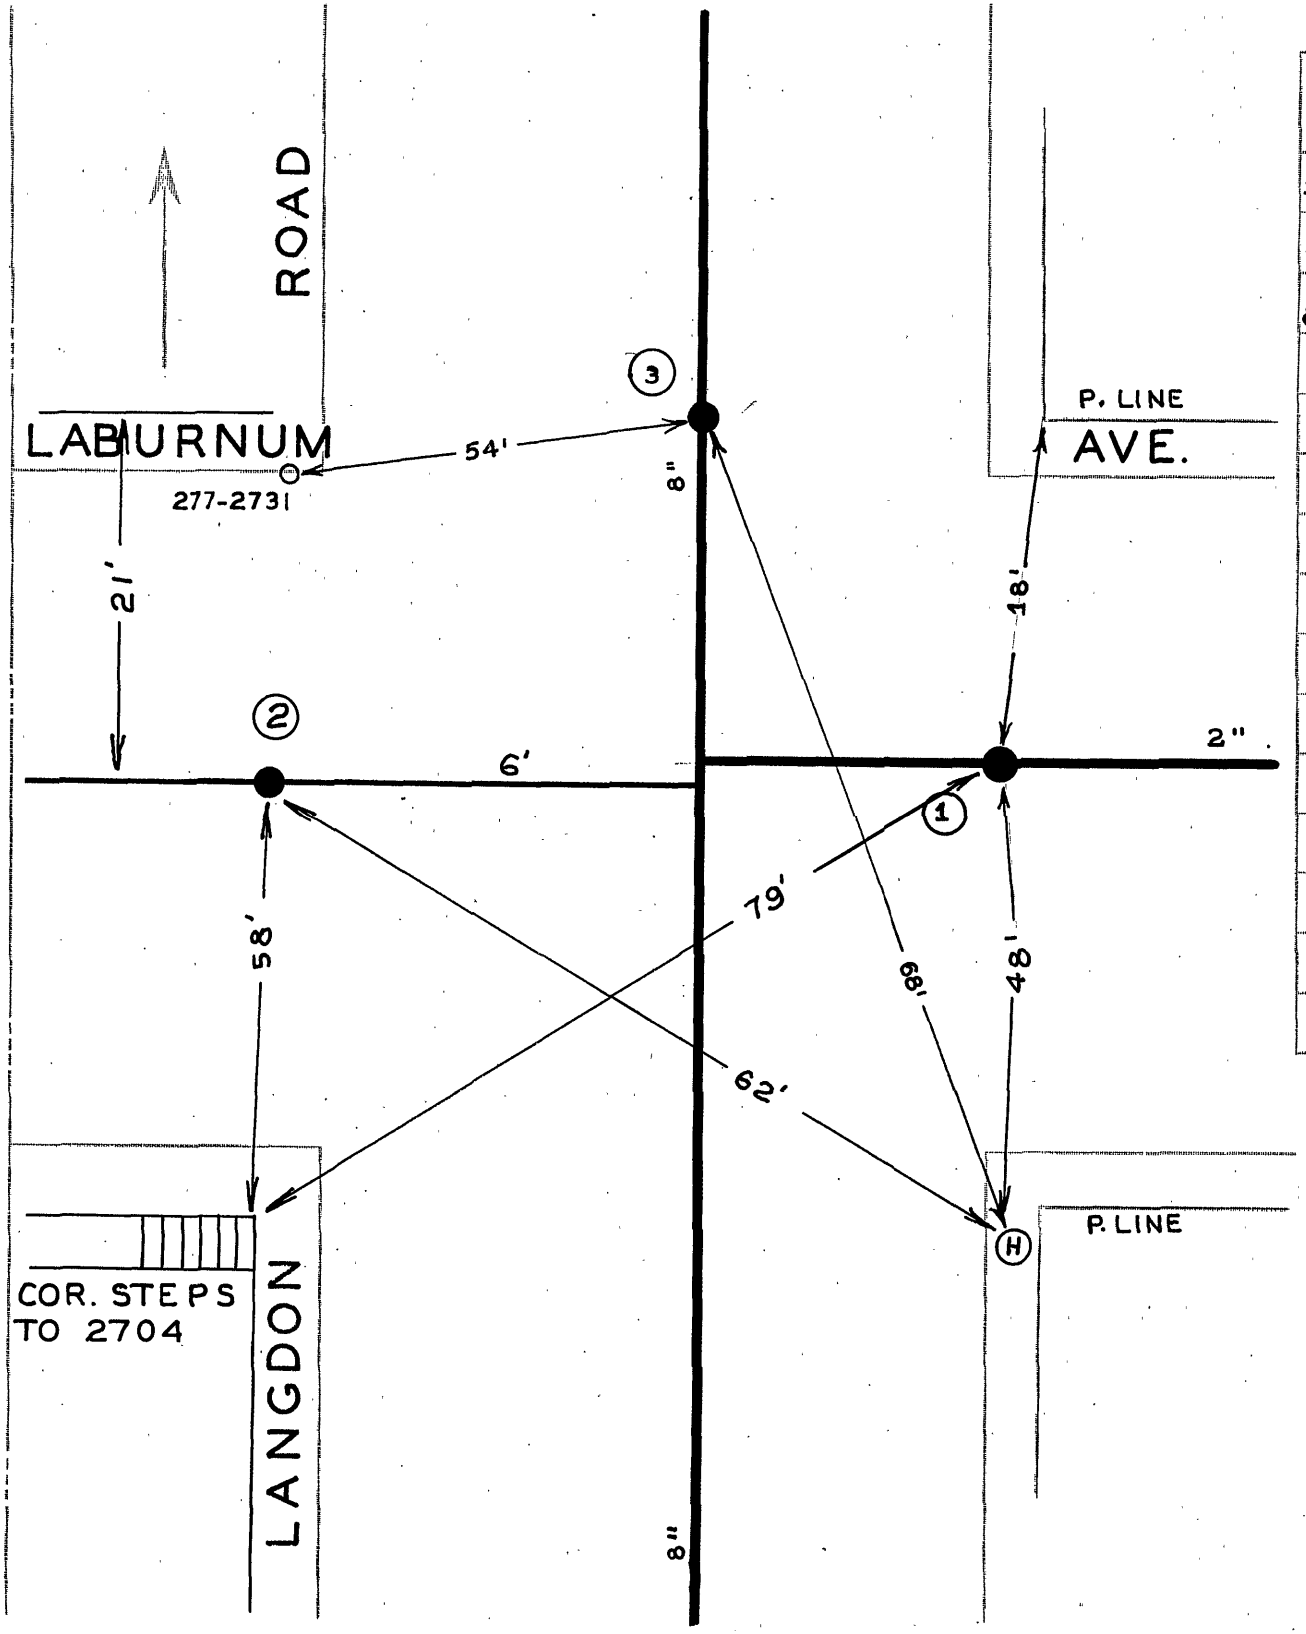

DATE	NO.	SIZE	MAKE	OPEN	TURNS
1948	1	2"	DARLING	R	7
2-52	2	6"	MUELLER	R	20
8-61	3	8"	DARLING	R	26
	1	0	EPL		
	2	0	WPL		
	3	0	NPL		

CITY OF ROANOKE—WATER DEP'T

VALVE DIAGRAM

LABURNUM AVENUE &

LANGDON ROAD S.W.

SEC. MAP 162

DATE PAGE NO. SW558