MATCHLINE: C19

295+00 296+00 297+00 298+00 299+00 300+00 301+00 302+00 303+00 304+00 305+00 306+00 307+00 308+00 309+00 310+00 311+00

STA: ~~298+66.00~~ Do not install
NEW BLOW OFF ASSEMBLY
Project To Abandon
727'
Elwood Wray Rd
TEST
GV 13

STA: 298+83.00
NEW FIRE HYDRANT ASSEMBLY
60192
moved
STA: 298+85.00
NEW 12" GATE VALVE
#19

It is 43' From
G.V 19 to F.H 60192

NEW 12" WATERLINE

moved in front of guardrail

CMP 1224.31'

It is 895' From
G.V 19 to G.V 20 and
it is 943' From G.V 20
To F.H. 60192

STA: ~~307+01.00~~ 68
NEW FIRE HYDRANT ASSEMBLY
moved
60193

STA: 307+~~03.00~~ 70
NEW 12" GATE VALVE
moved
#20
885'

U.S. ROUTE 220

18" RCP
INV IN: 1208.18
INV OUT: 1205.49

DI: TOP 1211.29

4'x6' BOX CULVERT
INV IN: 1183.59
INV OUT: 1180.00

18" RCP
INV IN: 1217.72
INV OUT: UNKNOWN

18" CMP
INV IN: 1224.99
INV OUT: 1217.87

15" CMP
INV IN: 1221.58
INV OUT: 1221.13

18" RCP
INV IN: UNKNOWN
INV OUT: 1222.94

DI: TOP 1225.68

18" CMP
INV IN: 1223.24
INV OUT: 1221.83

IF THIS DRAWING IS A REDUCTION
GRAPHIC SCALE MUST BE USED

VERT: 1" = 10'
10' 0 10'
50' 0 50'
HORZ: 1" = 50'

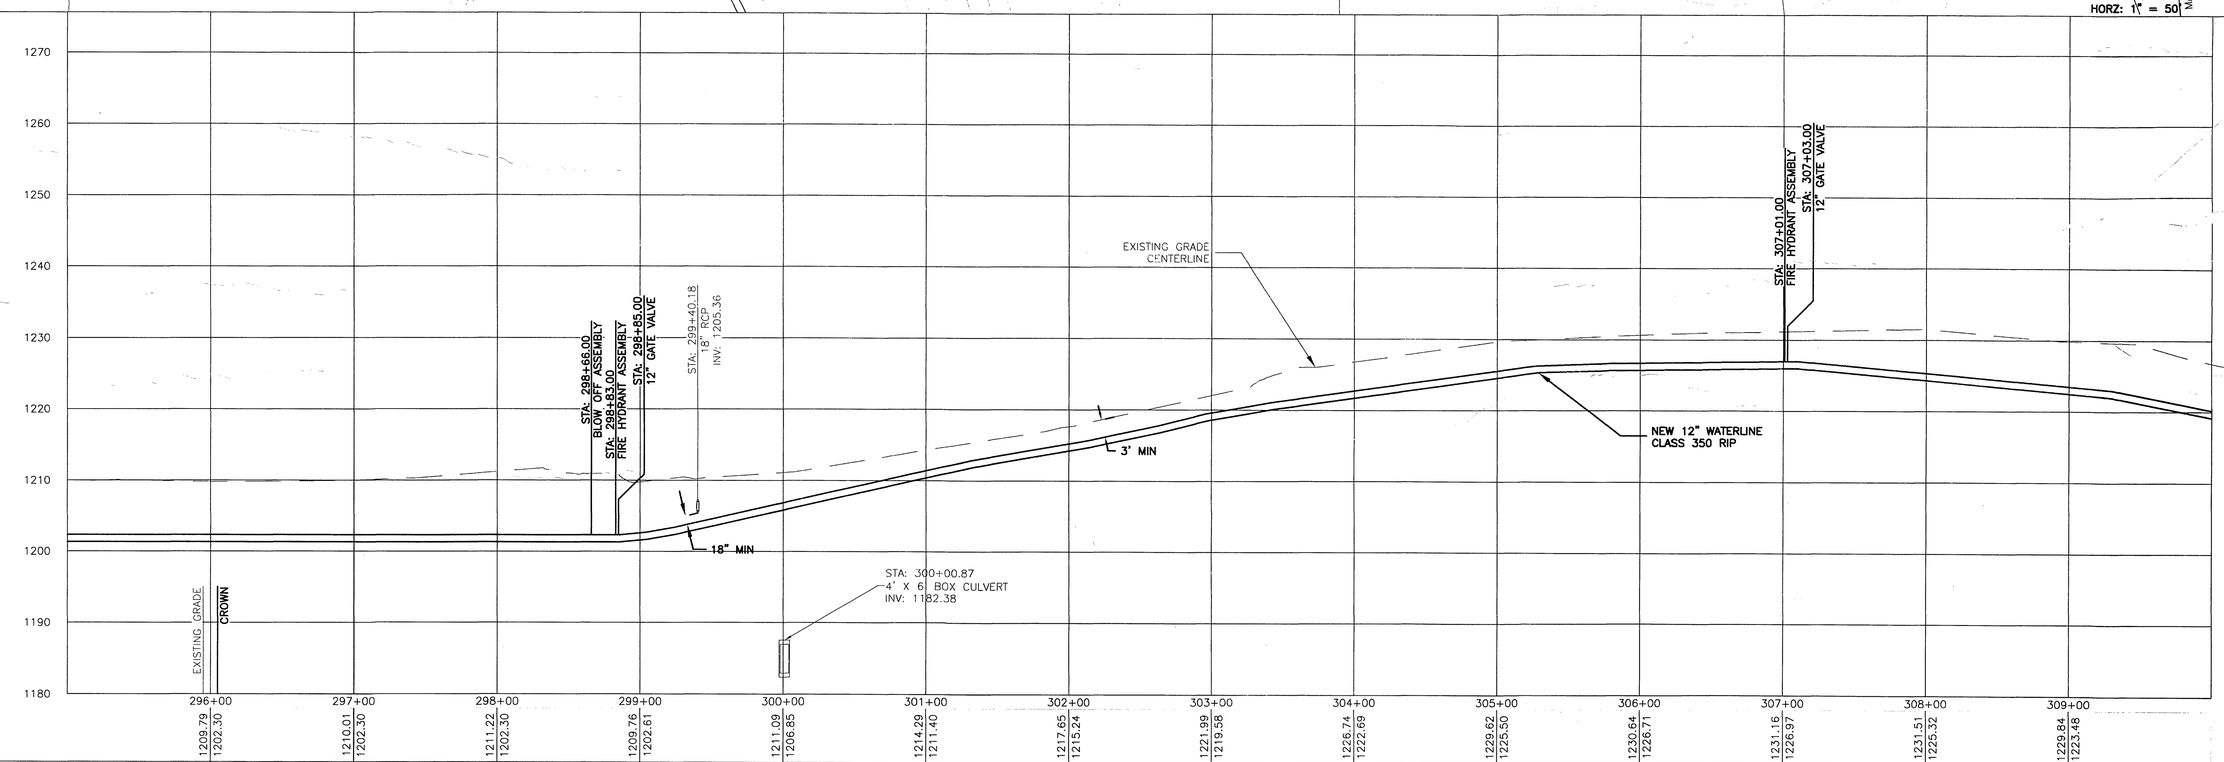

No:	Revisions:	Date:
1	FRANKLIN COUNTY COMMENTS	02/27/09

EARTH ENVIRONMENTAL CONSULTANTS, INC.
235 Claiborne Ave..
Rocky Mount, VA 24151
www.earthenv.com
Phone: (540) 483-5975
Fax: (540) 483-2221

COMMONWEALTH OF VIRGINIA
MARTY EUGENE PRILLAMAN
Lic. No. 043205
2/27/09
PROFESSIONAL ENGINEER

WATER AUTHORITY
Franklin County

DESIGN BY:	BKS/MEP
DRAWN BY:	BKS
REVIEWED BY:	MEP
PROECT NUMBER:	FCPP1004
PROJECT:	ROANOKE/FRANKLIN COUNTY WATERLINE EXTENSION PHASE II U.S. ROUTE 220 FRANKLIN COUNTY, VA
TITLE:	Plan and Profile STA – 295+00.00 to 310+00.00
DRAWING NAME:	STA – 295+00.00 to 310+00.00.dwg
SCALE:	H: 1" = 50' V: 1" = 10'
DATE:	01/14/09
DRAWING NUMBER:	C20
SHEET NUMBER:	22 of 28

P:\FC – Plateau Plaza\FCPP1004\EEC dwg\Sheets\Phase II\STA – 295+00.00 to 310+00.00.dwg