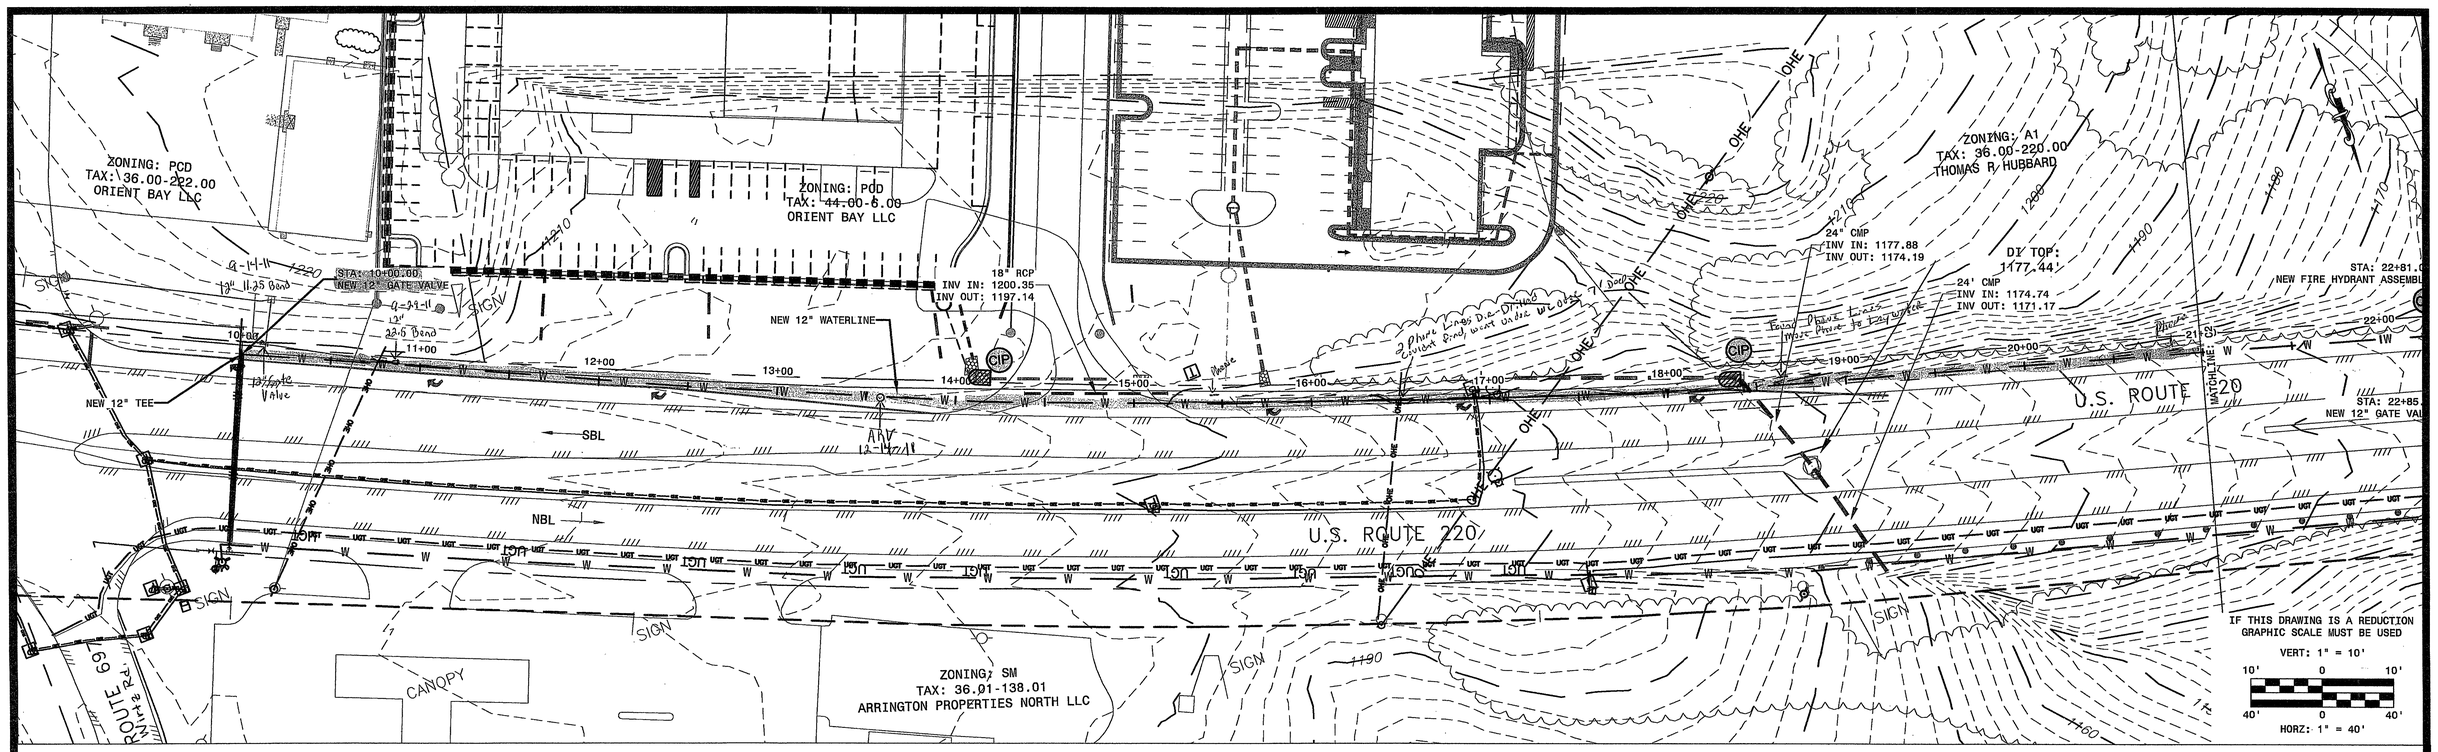

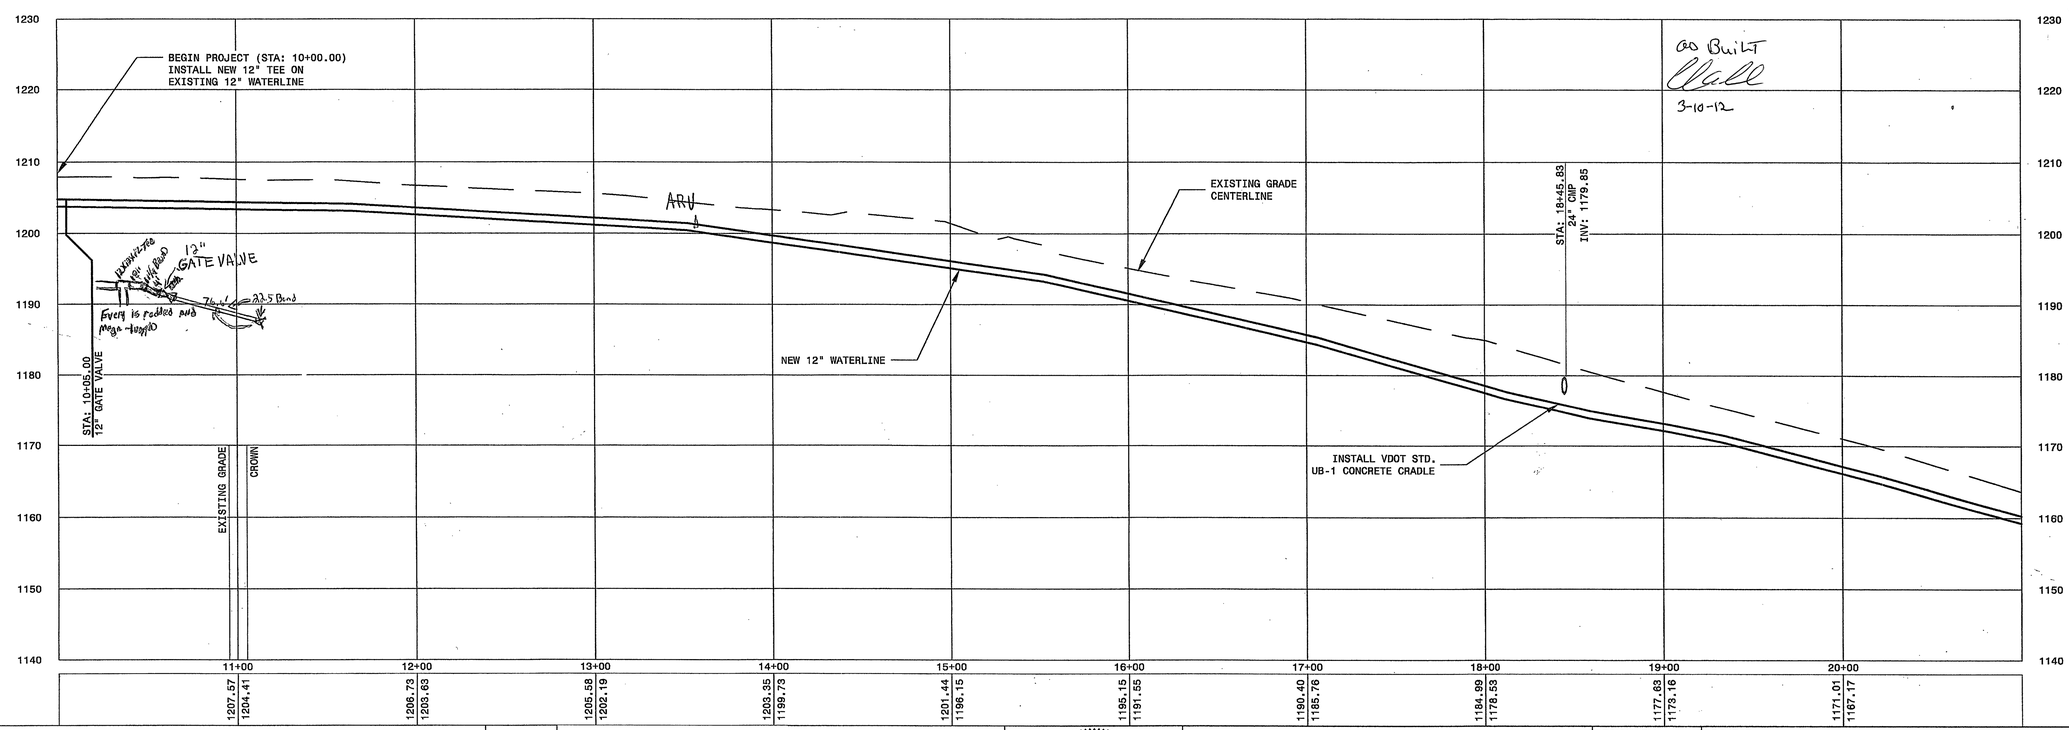

No:	Revisions:	Date:

earth
environmental and civil

ADDRESS:
235 CLAIBORNE AVE.
ROCKY MOUNT, VA 24151

PHONE NUMBERS:
PHONE: (540) 483-5975
FAX: (540) 483-2221

WEBSITE
WWW.EARTHENV.COM

COMMONWEALTH OF VIRGINIA
JAMES NELSON LOVELL, JR.
Lic. No. 025230
5/2/2011
PROFESSIONAL ENGINEER

DESIGN BY: BKS	PROJECT: ROUTE 220 WATERLINE EXTENSION (As Built)		DATE: 5/2/2011
DRAWN BY: BKS	TITLE: US 220 WATERLINE EXTENSION STA - 10+00.00 to 21+00.00		DRAWING NUMBER: C1
REVIEWED BY: BKS			SHEET NUMBER: 2 of 5
PROJECT NUMBER: 11-0013	DRAWING NAME: 11-0013.dwg	SCALE: H: 1" = 40' V: 1" = 10'	

C:\Users\bscott\Documents\Working Projects\Western VA Water Authority\11-0013 - RT 220 WL EXT\11-0013.dwg