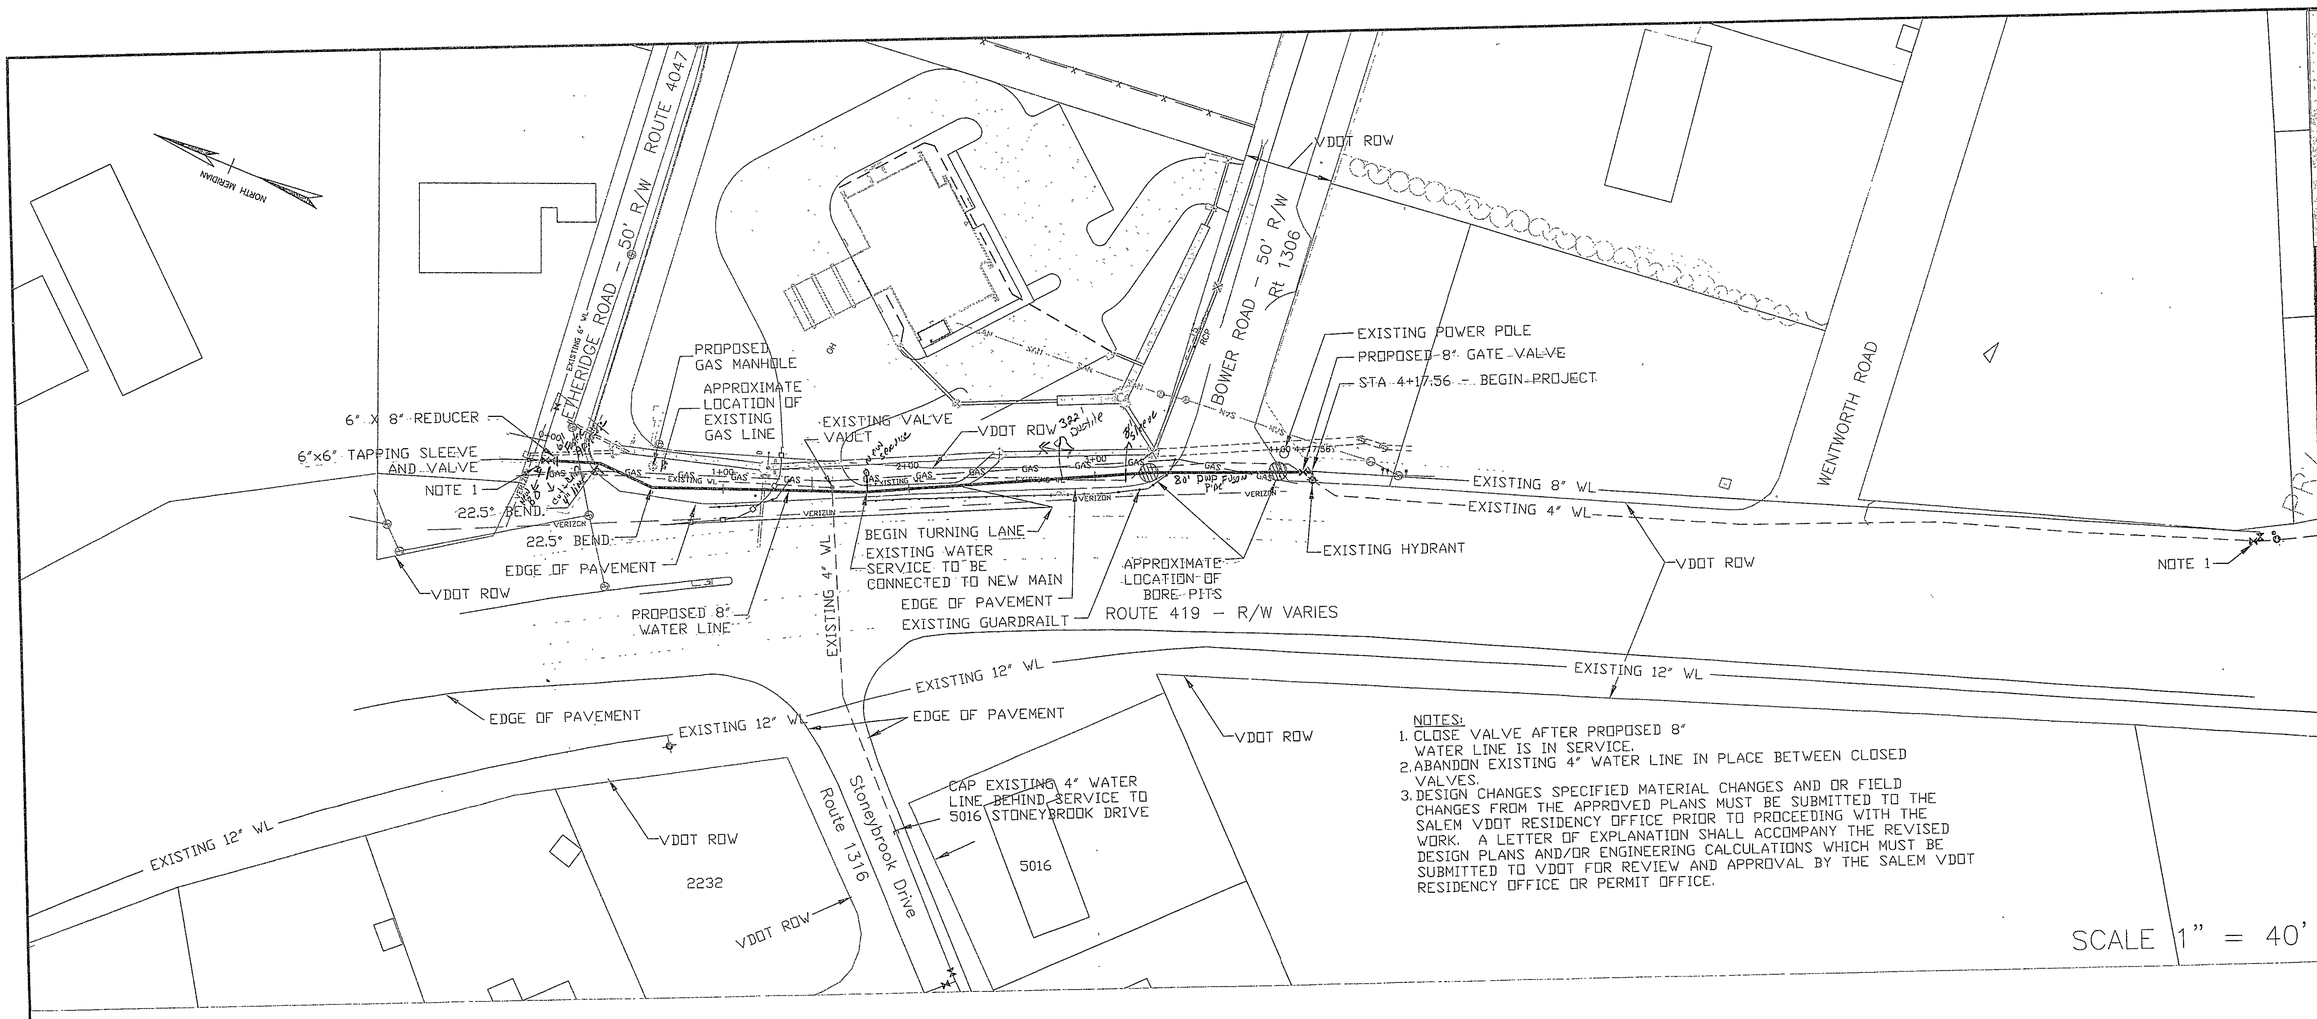

NOTES:

1. CLOSE VALVE AFTER PROPOSED 8" WATER LINE IS IN SERVICE.
2. ABANDON EXISTING 4" WATER LINE IN PLACE BETWEEN CLOSED VALVES.
3. DESIGN CHANGES SPECIFIED MATERIAL CHANGES AND OR FIELD CHANGES FROM THE APPROVED PLANS MUST BE SUBMITTED TO THE SALEM VDOT RESIDENCY OFFICE PRIOR TO PROCEEDING WITH THE WORK. A LETTER OF EXPLANATION SHALL ACCOMPANY THE REVISED DESIGN PLANS AND/OR ENGINEERING CALCULATIONS WHICH MUST BE SUBMITTED TO VDOT FOR REVIEW AND APPROVAL BY THE SALEM VDOT RESIDENCY OFFICE OR PERMIT OFFICE.

NOTE
Look in folder for as-builts that UES made.

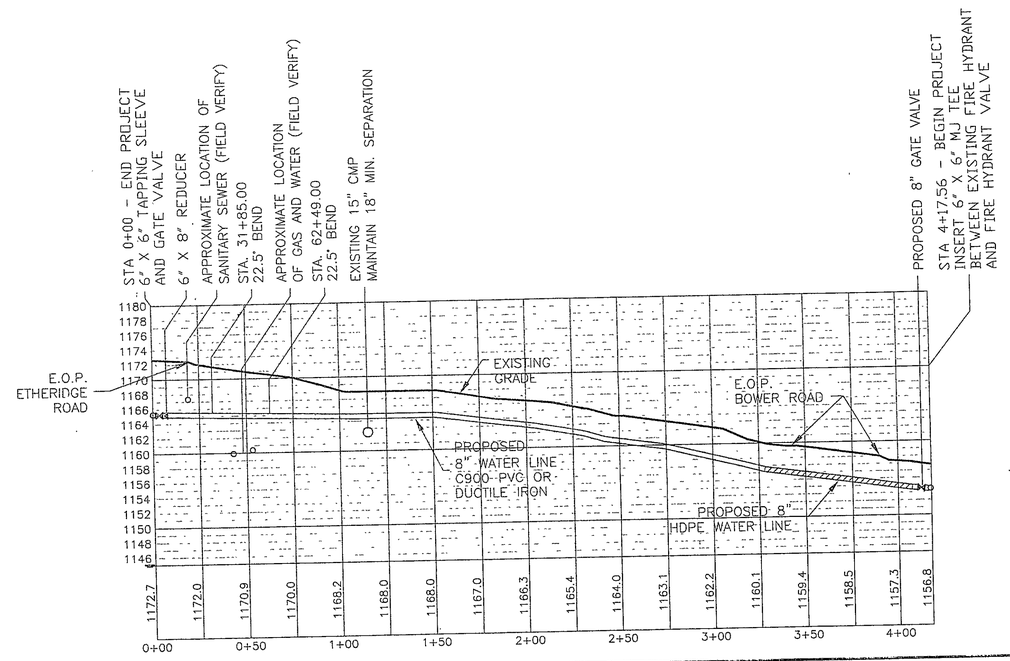

As-Built: 8/28/2006
Inspector - Mark Sink (WVWA)

HOR. SCALE 1" = 40'
VERT SCALE 1" = 10'

WVWA ID# 6PAQ8N

VIRGINIA WATER AUTHORITY

ENGINEERING SERVICES
2012 SOUTH JEFFERSON STREET
ROANOKE, VIRGINIA 24014
PHONE: (540) 853-5641

COMMONWEALTH OF VIRGINIA
Roger R. Blankenship
040615
PROFESSIONAL ENGINEER

419 WATER LINE REPLACEMENT BOWER TO ETEHRIDGE ROAD

Designed By:	RRB
Drawn By:	RRB
Checked By:	JGR
Date:	04/24/06
Scale:	AS SHOWN
Plan #:	00-00
Sheet:	2 OF 2