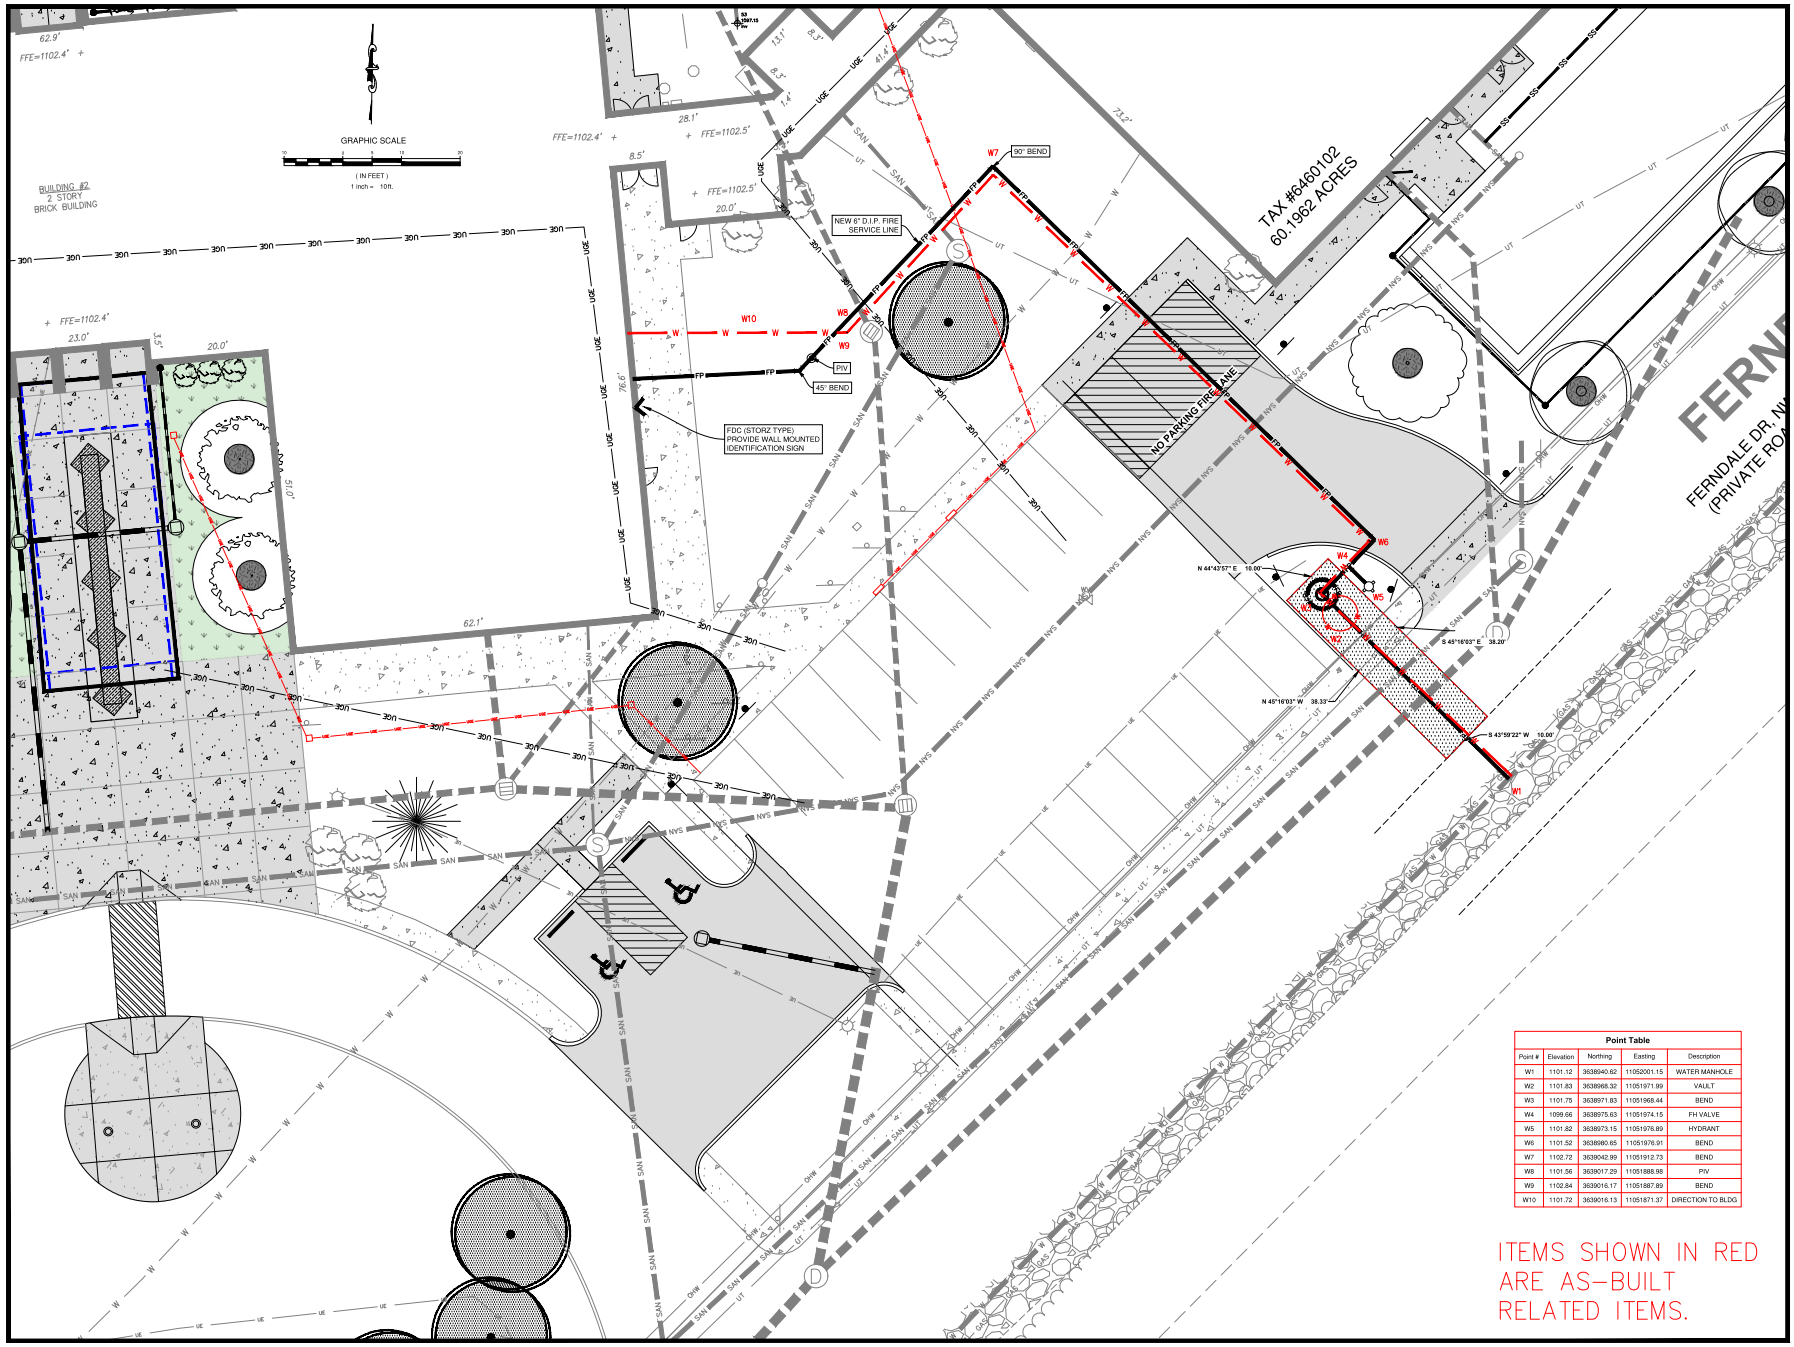

Point Table

Point #	Elevation	Northing	Easting	Description
W1	1101.12	3638940.62	11052001.15	WATER MANHOLE
W2	1101.83	3638968.32	11051971.99	VAULT
W3	1101.75	3638971.83	11051968.44	BEND
W4	1099.66	3638975.63	11051974.15	FH VALVE
W5	1101.82	3638973.15	11051976.89	HYDRANT
W6	1101.52	3638980.65	11051976.91	BEND
W7	1102.72	3639042.99	11051912.73	BEND
W8	1101.56	3639017.29	11051888.98	PIV
W9	1102.84	3639016.17	11051887.89	BEND
W10	1101.72	3639016.13	11051871.37	DIRECTION TO BLDG

ITEMS SHOWN IN RED ARE AS-BUILT RELATED ITEMS.

GA architecture
ARCHITECTURE INTERIORS PLANNING
parker DESIGN GROUP
ARCHITECTS PLANNERS & LANDSCAPE ARCHITECTS

COMMONWEALTH OF VIRGINIA
JACK D. ELLINWOOD
Lic. No. 001107
09/01/2023
LANDSCAPE ARCHITECT

AS-BUILTS | RUFFNER CAREER AND TECHNICAL EDUCATION CENTER

ROANOKE, VIRGINIA

ROANOKE CITY PUBLIC SCHOOLS
Strong Students. Strong Schools. Strong City.

REVISIONS

No.	DATE	DESCRIPTION

DRAWN BY:	JDE/JMD
REV'D BY:	JDE
DATE:	09/01/2023
SCALE:	AS SHOWN

WATERLINE AS-BUILTS

AB01

SHEET _____ of __X__