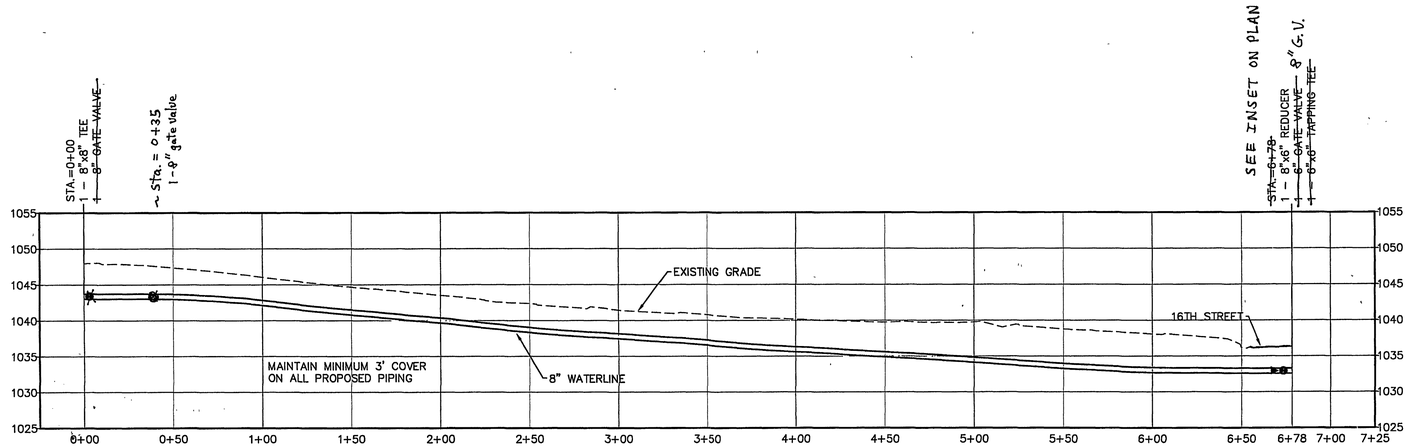

SYRACUSE AVENUE WATERLINE PROFILE

SCALE: H: 1"=40', V: 1"=10'

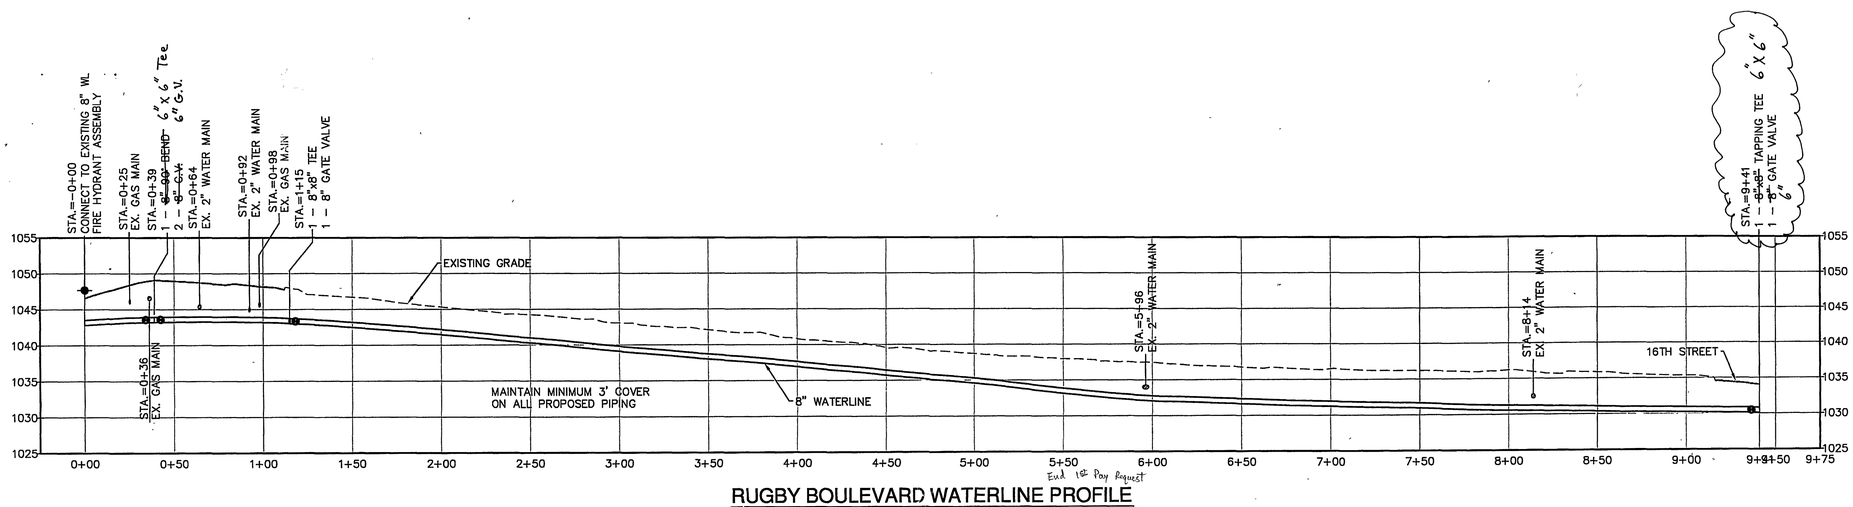

RUGBY BOULEVARD WATERLINE PROFILE

SCALE: H: 1"=40', V: 1"=10'

As-Built 5.10.10 K. Winslow

COMMONWEALTH OF VIRGINIA
RANDALL M. HANCOCK
Lic. No. 14541
7/29/09
PROFESSIONAL ENGINEER

Draper Aden Associates
Engineering • Surveying • Environmental Services
Blacksburg, VA
2905 South Main Street
Blacksburg, VA 24060
540-552-0444 Fax: 540-552-0281
www.dasi.com
Richmond, VA
Charlottesville, VA
Hampton Roads, VA

PROFILES
RUGBY BOULEVARD WATERLINE REPLACEMENTS
CITY OF ROANOKE, VIRGINIA

REVISIONS

APPROVED
OCT 15 2009

DESIGNED BY	RMH
DRAWN BY	SAK
CHECKED BY	TOM
SCALE	1" = 40'
DATE	JULY 29, 2009
PROJECT NUMBER	B09134B-02

U-2