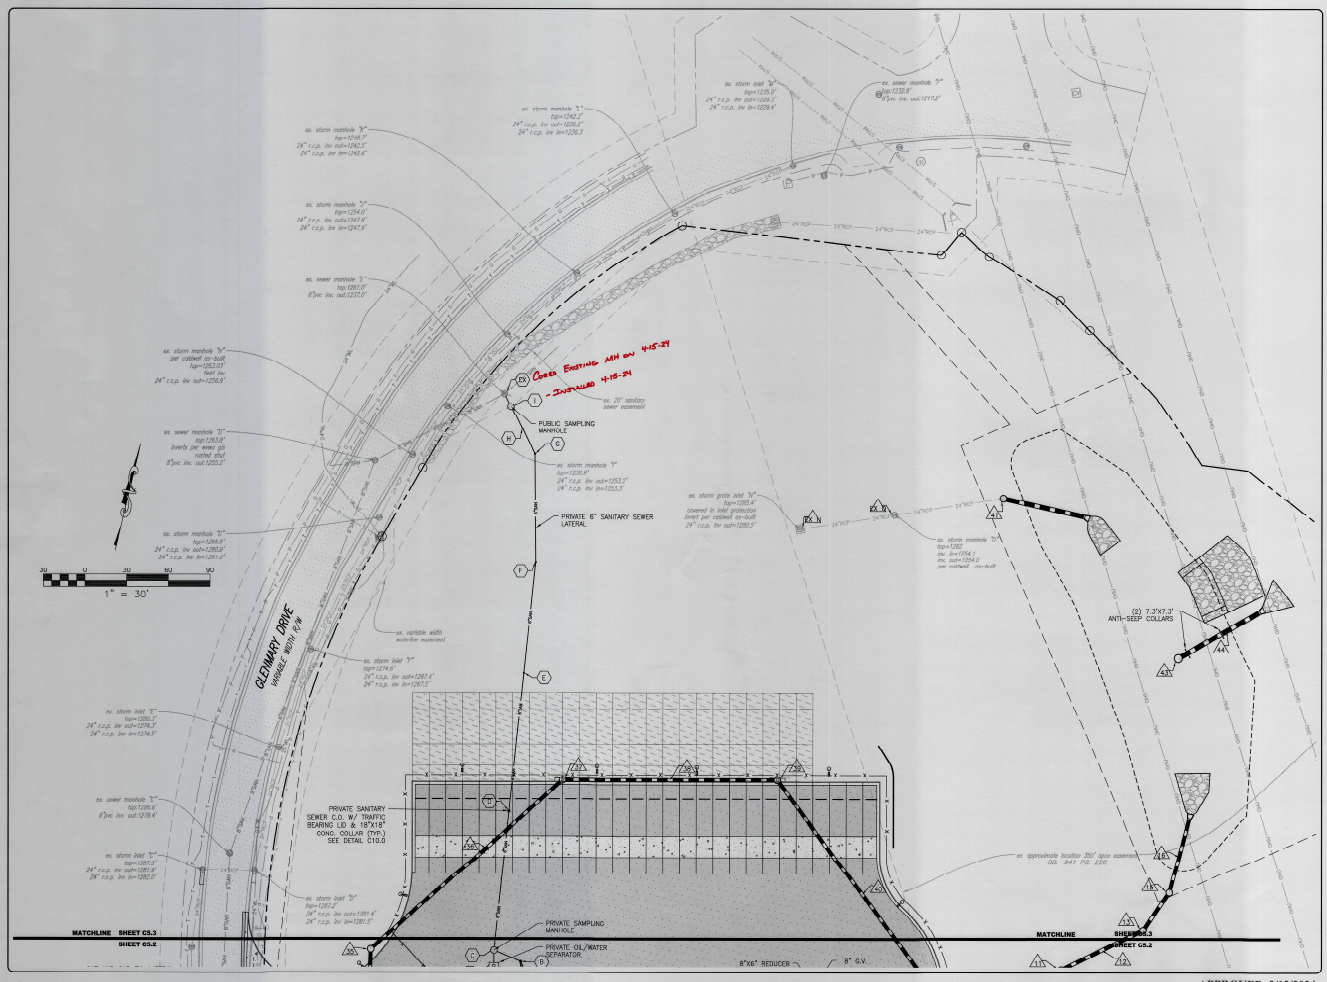

BALZER & ASSOCIATES
PLANNERS / ARCHITECTS
ENGINEERS / SURVEYORS
Roanoke / Richmond
New River Valley
Shenandoah Valley
www.balzer.us
1200 Corporate Circle
Roanoke, VA 24018
540.772.9980

COMMONWEALTH OF VIRGINIA
CHRISTOPHER P. BURGER
Lic. No. 47330
2/5/2024
PROFESSIONAL ENGINEER

GLENMARY DRIVE - SUNCAP

UTILITY PLAN II

GLENMARY DRIVE
ROANOKE COUNTY, VIRGINIA

DRAWN BY	AAB
DESIGNED BY	AAB
CHECKED BY	BTC
DATE	12/21/2023
SCALE	1" = 30
6FV/6FM/MR	
1/22/024	
1/29/2024	
1/30/2024	
3/5/2024	

C5.3

PROJECT NO. 0420018.01

APPROVED, 2/12/2024