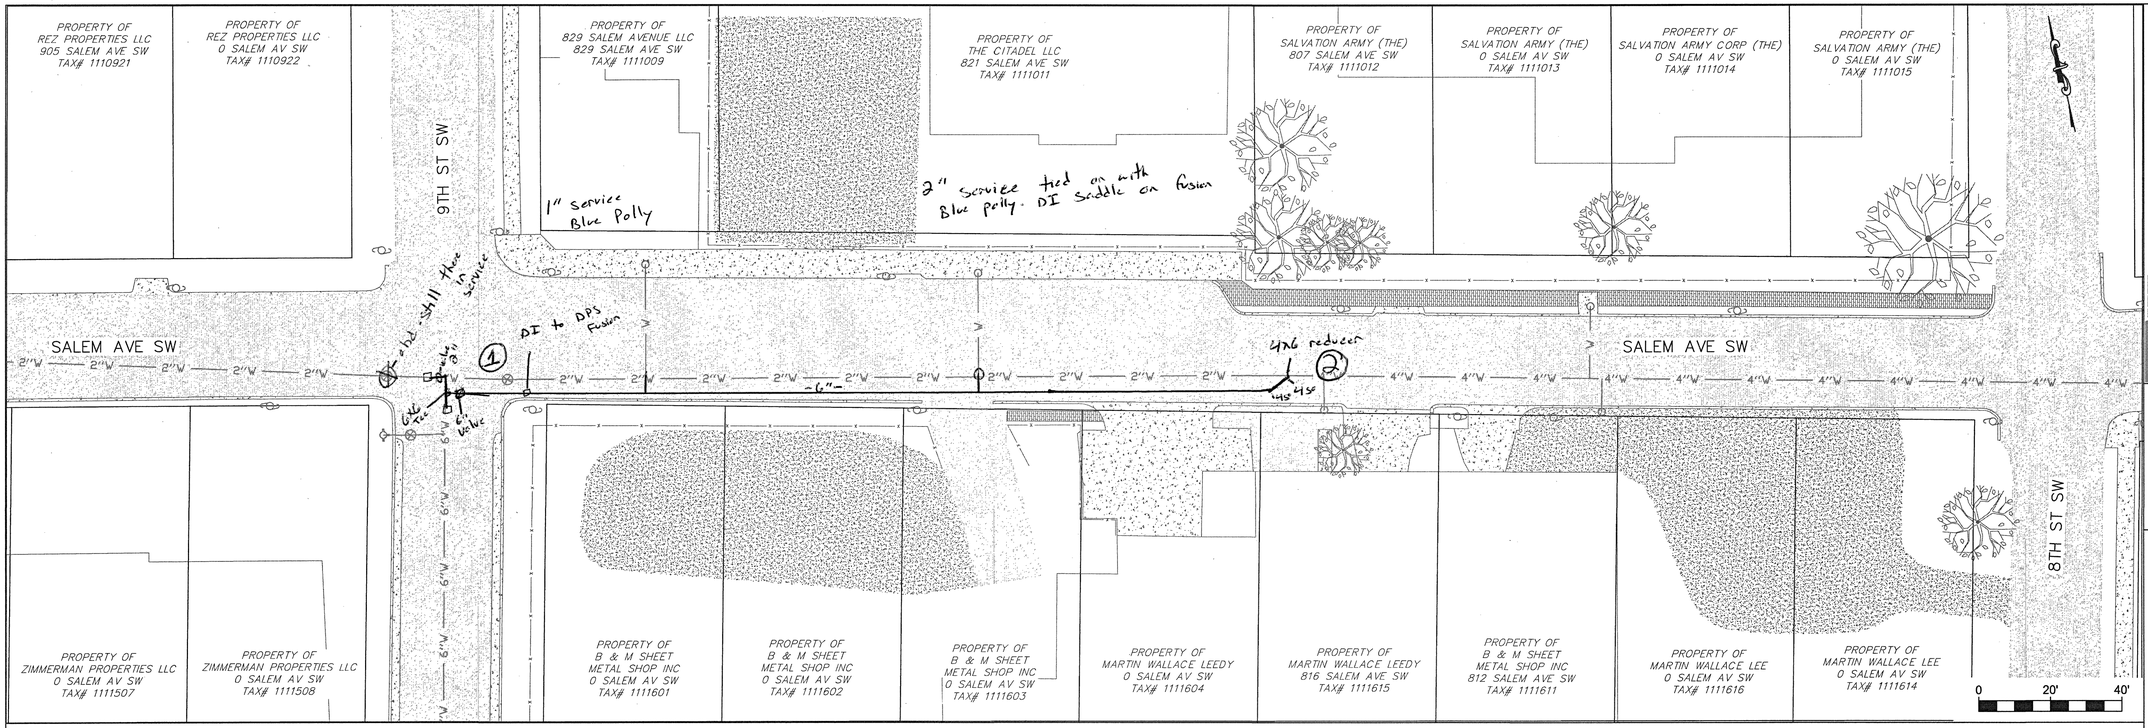

Install Contractor	
Construction Start Date	
Completion Date	
Water Main(s)	
Manufacturer	
Diameter	
Pipe Class	
Material	
Comments	
Water Service(s)	
Manufacturer	
Diameter	
Pipe Class	
Material	
Comments	

	Water Valve(s) 1	Water Valve(s) 2
Manufacturer		
Valve Type		
Diameter		
Direction to Open / Turns to Close		
Comments		
	Water Valve (s) 3	**Water Valve (s) 4**
Manufacturer		
Valve Type		
Diameter		
Direction to Close / Turns to Close		
Comments		

Hydrant(s)	
Authority ID #	
Manufacturer	
Model	
Cast Date	
Static Pressure	
Comments	

1 - 9th towards Salem Ave
- 6x6x6 Tee
- 6"x2" cap
- 6" valve
- 2" valve
- 2"x2" brass nipple
- MIPx CTS-2"
- FIPx CTS-2"
- 3' Blue polly - 2"

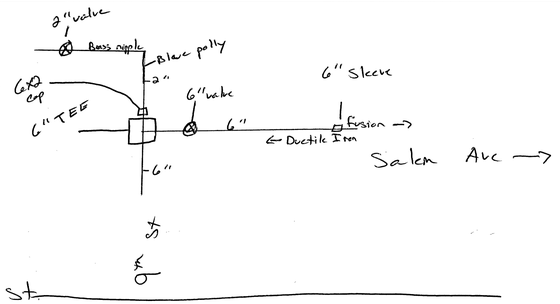

2 - Salem Ave towards 8th St
- 2 - 45° DI - 6"
- 4x6" Reducer
- 4' - 6" DI

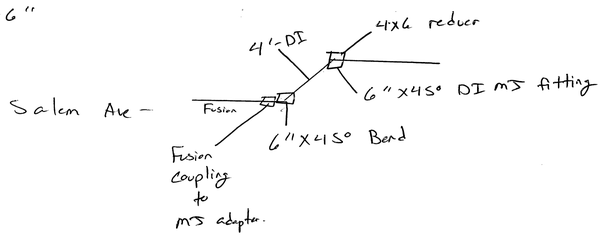

GENERAL NOTES:
1. PROPERTY LINES SHOWN ON THIS PAGE ARE BASED ON GIS DATA AND HAVE NOT BEEN FIELD SURVEYED.

LEGEND (EXISTING)

WATER/FORCEMAIN	STORM
VALVE	DROP INLET
AIR RELEASE	LARGE CURB INLET
BLOW-OFF/ FLUSHING ASSEMBLY	SMALL CURB INLET
SINGLE METER BOX	MANHOLE
DOUBLE METER BOX	
FIRE HYDRANT	
WELL	
SEWER	**OTHER**
MANHOLE	POWER POLE
CLEAN OUT	POWER POLE WITH GUY WIRE
GAS VALVE	LAMP POST
UTILITY PEDESTAL	TRAFFIC POLE
MAILBOX	SIGN

WESTERN VIRGINIA WATER AUTHORITY
ENGINEERING SERVICES
601 S JEFFERSON ST, SUITE 300
ROANOKE, VA 24011
540-853-5700

SALEM AVE WATERLINE REPLACEMENT

BASEMAP

Rev	Description	Date	By

Designed: N/A
Drawn: NSS
Checked: DRJ
Approved:
Date: OCT 2020
Project: MTNC