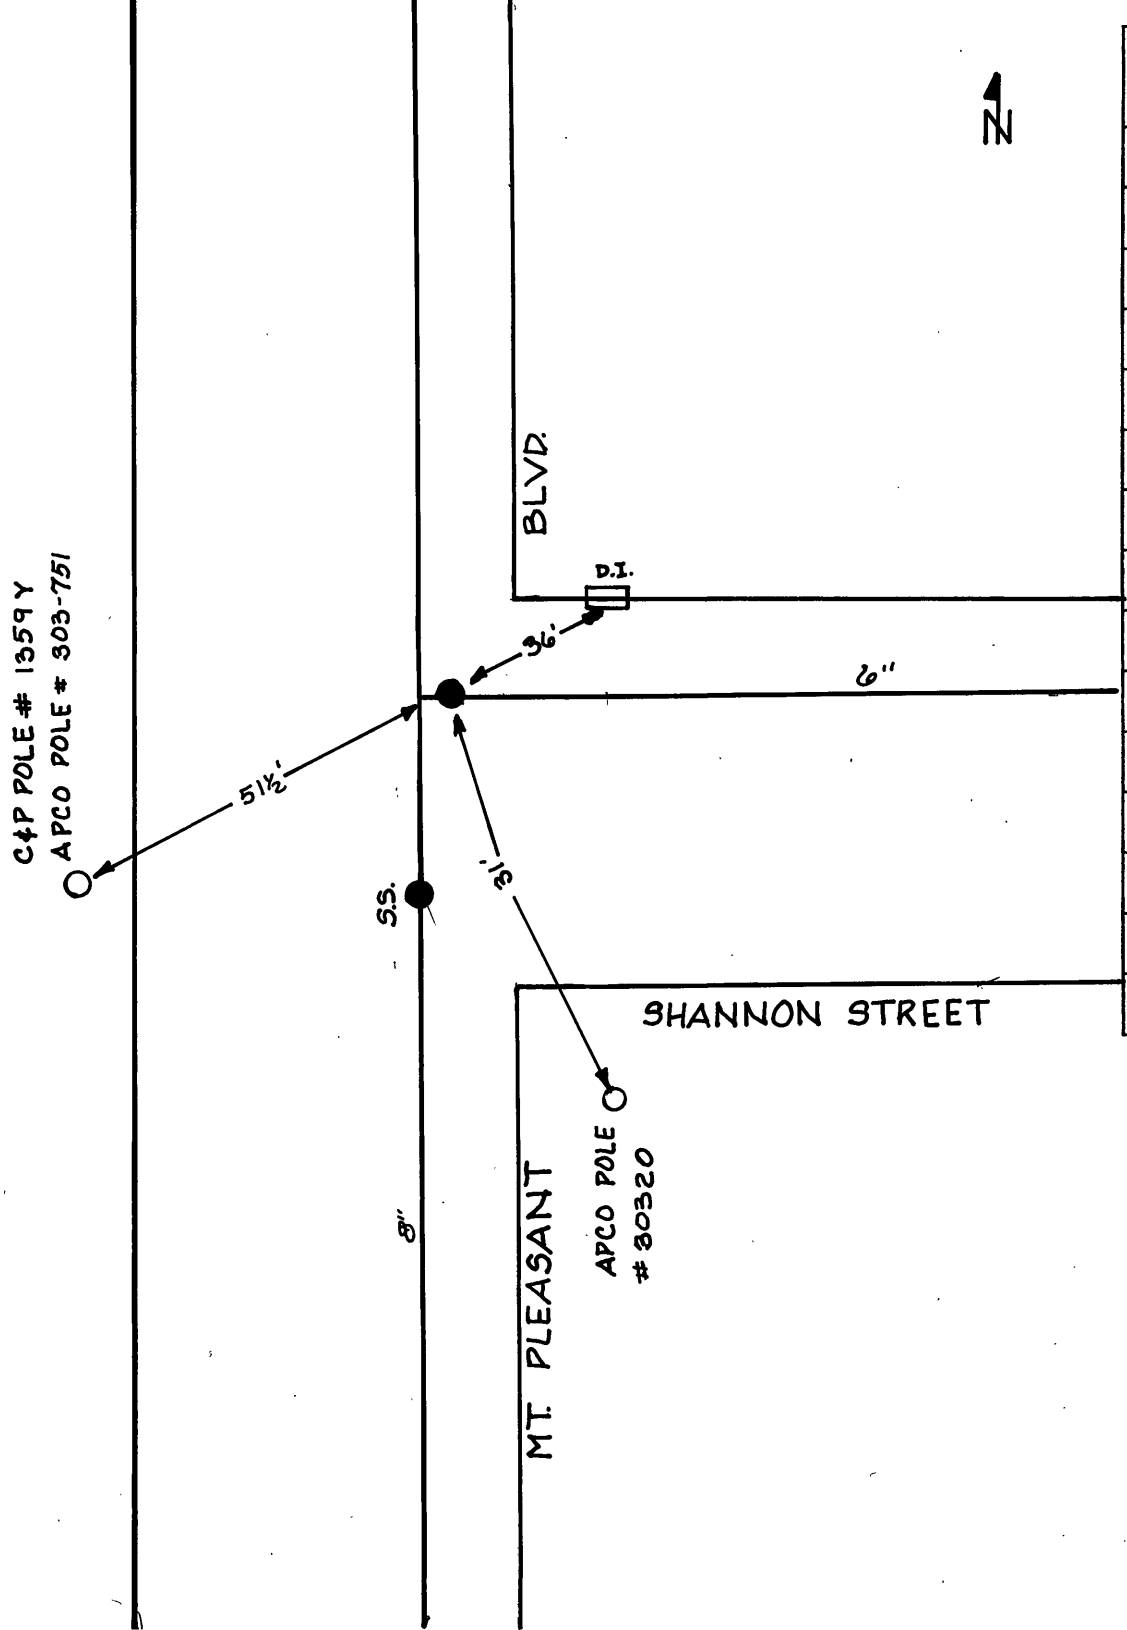

DATE	NO.	SIZE	MAKE	OPEN	TURNS
11-80	1	6"	MUELLER	R	

CITY OF ROANOKE—WATER DEP'T

VALVE DIAGRAM

MT. PLEASANT BLVD. AND

SHANNON ST.

S.E.

SEC. MAP 446

DATE NOV. 28, 1980 PAGE NO.