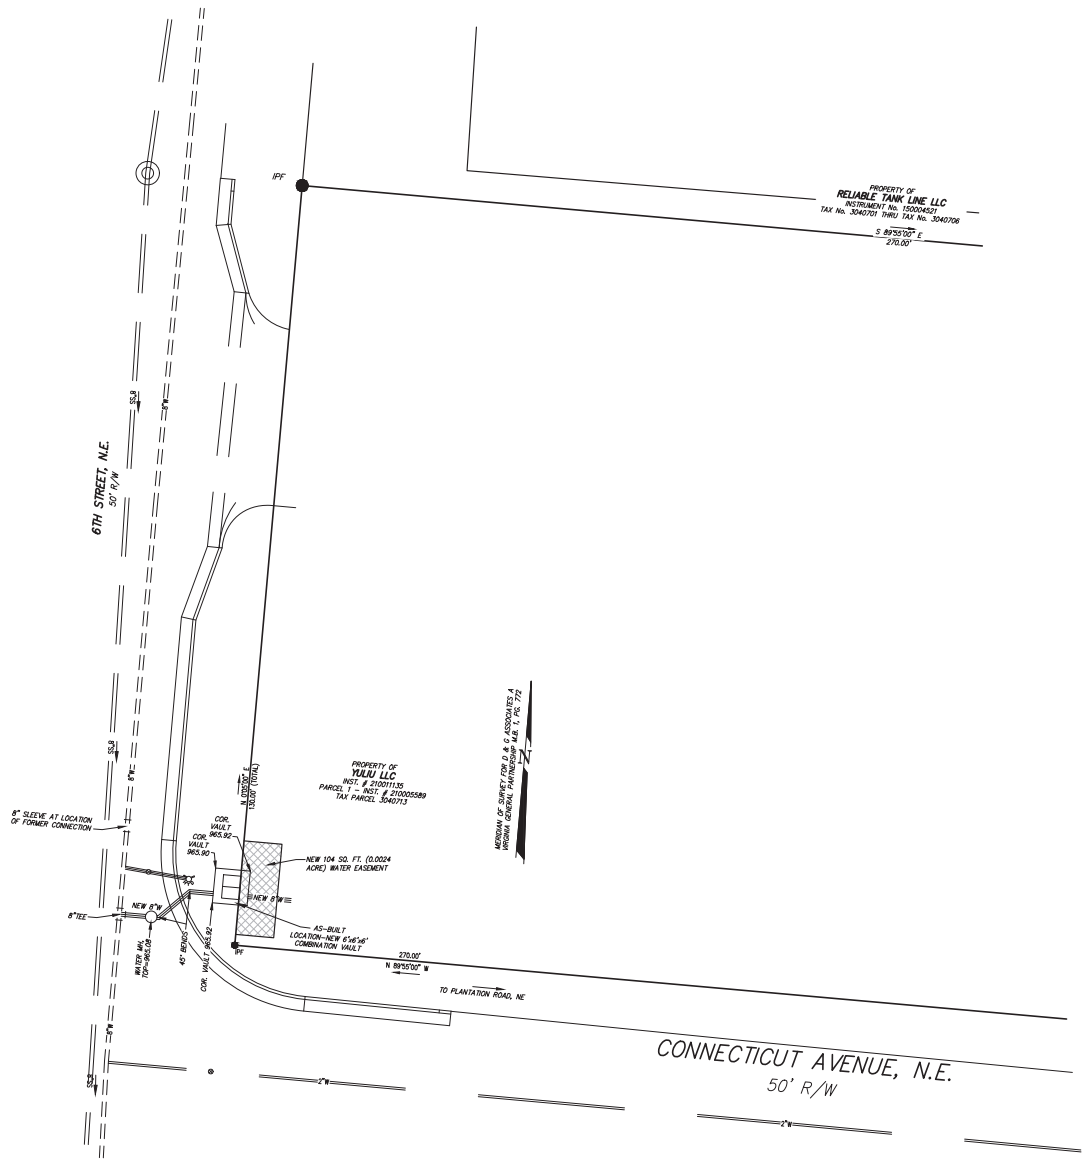

10' 5' 0' 10' 20' 1" = 10'

GRAPHIC SCALE

Revised June 08, 2023 Per WVWA Review – C.L. White

COMMONWEALTH OF VIRGINIA
FRANK B. CALDWELL III
License No. 1335
08 June, 2023
LAND SURVEYOR

THIS AS-BUILT SURVEY IS BASED ON A FIELD SURVEY OF VISIBLE WATERLINE IMPROVEMENTS. THE FIELD SURVEY WAS COMPLETED BY CALDWELL WHITE ASSOCIATES ON DECEMBER 29, 2022.

THIS AS-BUILT SURVEY IS BASED ON PLANS BY CALDWELL WHITE ASSOCIATES FOR "NEW BUILDING ADDITION, SHERWIN-WILLIAMS PAINT STORE", LAST REVISION DATED MARCH 30, 2022.

THIS AS-BUILT SURVEY WAS COMPLETED UNDER THE DIRECT AND RESPONSIBLE CHARGE OF, FRANK B. CALDWELL III, L.S. FROM AN ACTUAL GROUND SURVEY MADE UNDER MY SUPERVISION; THE ORIGINAL DATA WAS OBTAINED ON DECEMBER 29, 2022 AND THIS DIGITAL GEOSPATIAL DATA INCLUDING METADATA MEETS MINIMUM ACCURACY STANDARDS UNLESS OTHERWISE NOTED.

AS-BUILT SURVEY
OF
RELOCATED COMBINATION FIRE / DOMESTIC WATER VAULT
PERFORMED FOR
LIONBERGER CONSTRUCTION
LOCATED AT THE SHERWIN-WILLIAMS PAINT STORE
SITUATE 610 CONNECTICUT AVE., NE
CITY OF ROANOKE, VIRGINIA

Drawn:	C.L. White
Checked:	F.B. Caldwell
Date:	January 04, 2023
Scale:	1"=10'
Tax Parcel:	3040713
Field Book:	CH-25
W.O.:	21-0100

CWA
CALDWELL WHITE ASSOCIATES
ENGINEERS / SURVEYORS / PLANNERS
4905 MELROSE AVENUE, N.W. P.O. BOX 6860
ROANOKE, VIRGINIA 24017-0860
Telephone:(540) 366-5400 Fax: (540) 366-6702
E-Mail: cwaroanoke@aol.com