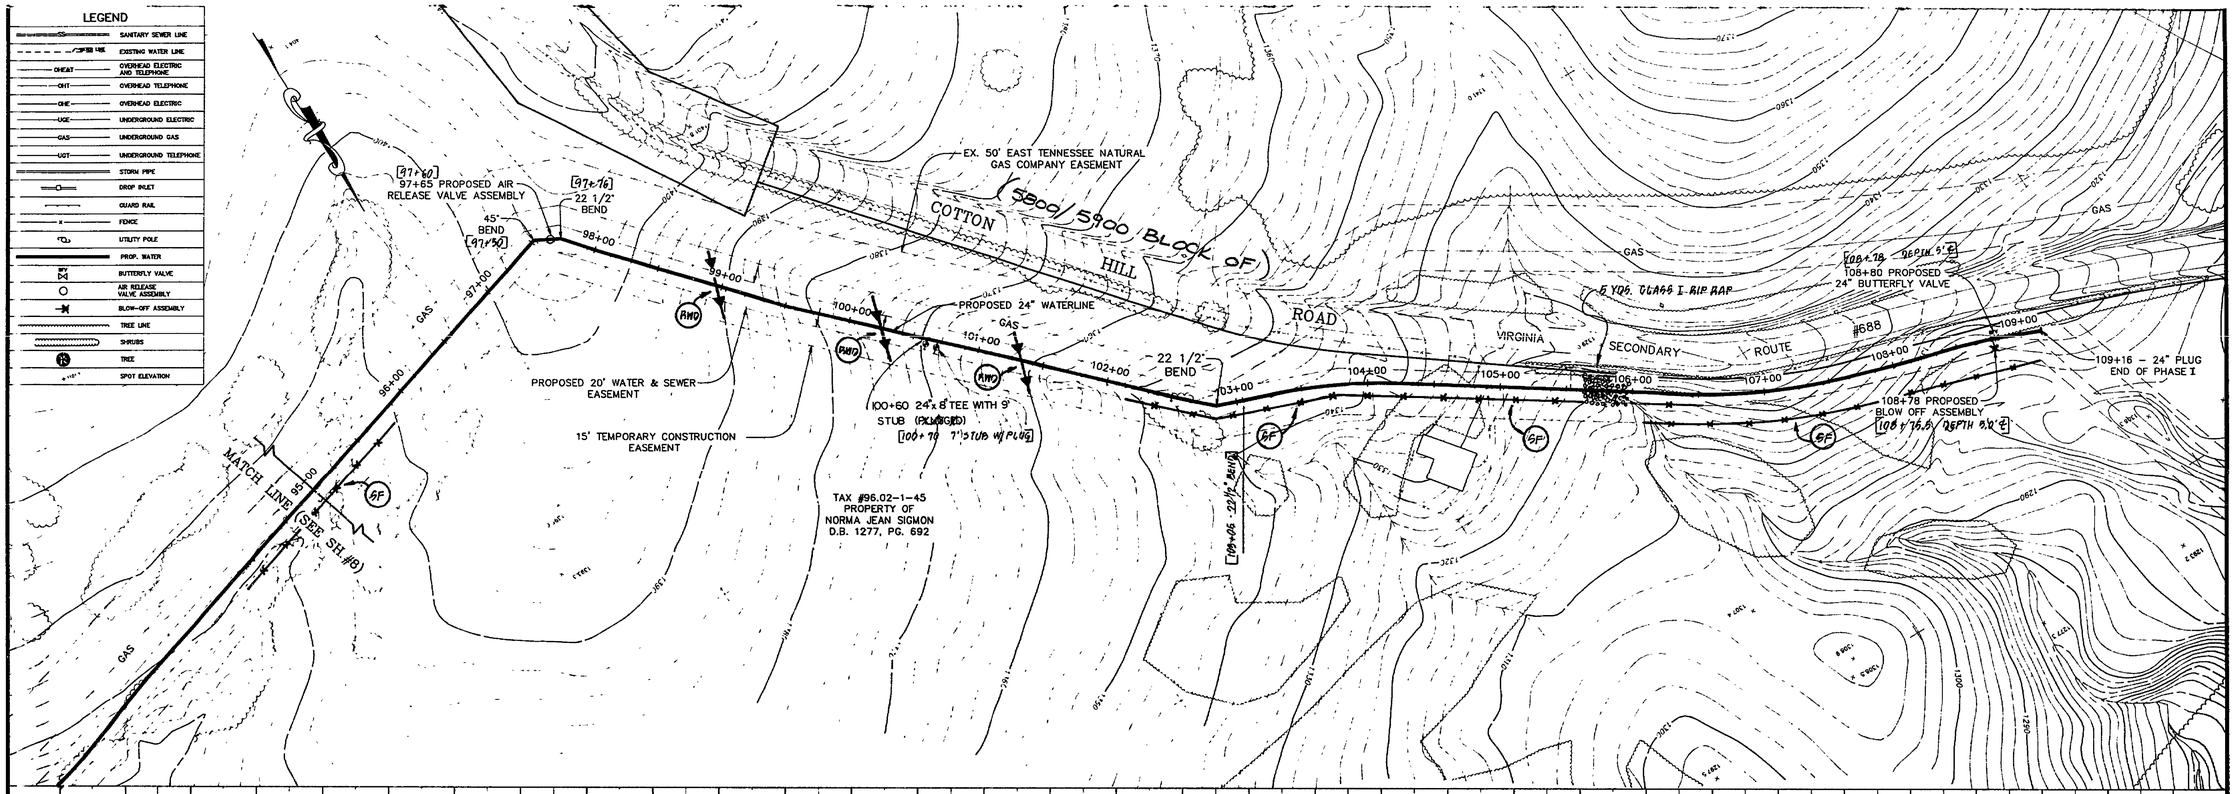

REVISION	DATE	DESCRIPTION
	8 NOV 1996	"AS-BUILT"

DESIGNED – GLR

DRAWN – MDH

CHECKED – MSW

COMMONWEALTH OF VIRGINIA
MICHAEL S. WEBB
No. 012656
4-22-94
PROFESSIONAL ENGINEER

PLAN & PROFILE
FOR
PHASE I
SOUTH LOOP TRANSMISSION MAIN
PREPARED FOR
ROANOKE COUNTY UTILITY DEPARTMENT
CAVE SPRING, WINDSOR HILLS, &
CATAWBA MAGISTERIAL DISTRICTS
ROANOKE COUNTY, VIRGINIA

LUMSDEN ASSOCIATES, P.C.
ENGINEERS–SURVEYORS–PLANNERS
ROANOKE, VIRGINIA

SCALE: 1" = 50' (HORIZ.)
SCALE: 1" = 10' (VERT.)
DATE: 6 MAY 1994
COMM: 91–376
SHEET 9 of 12

WT-0466