


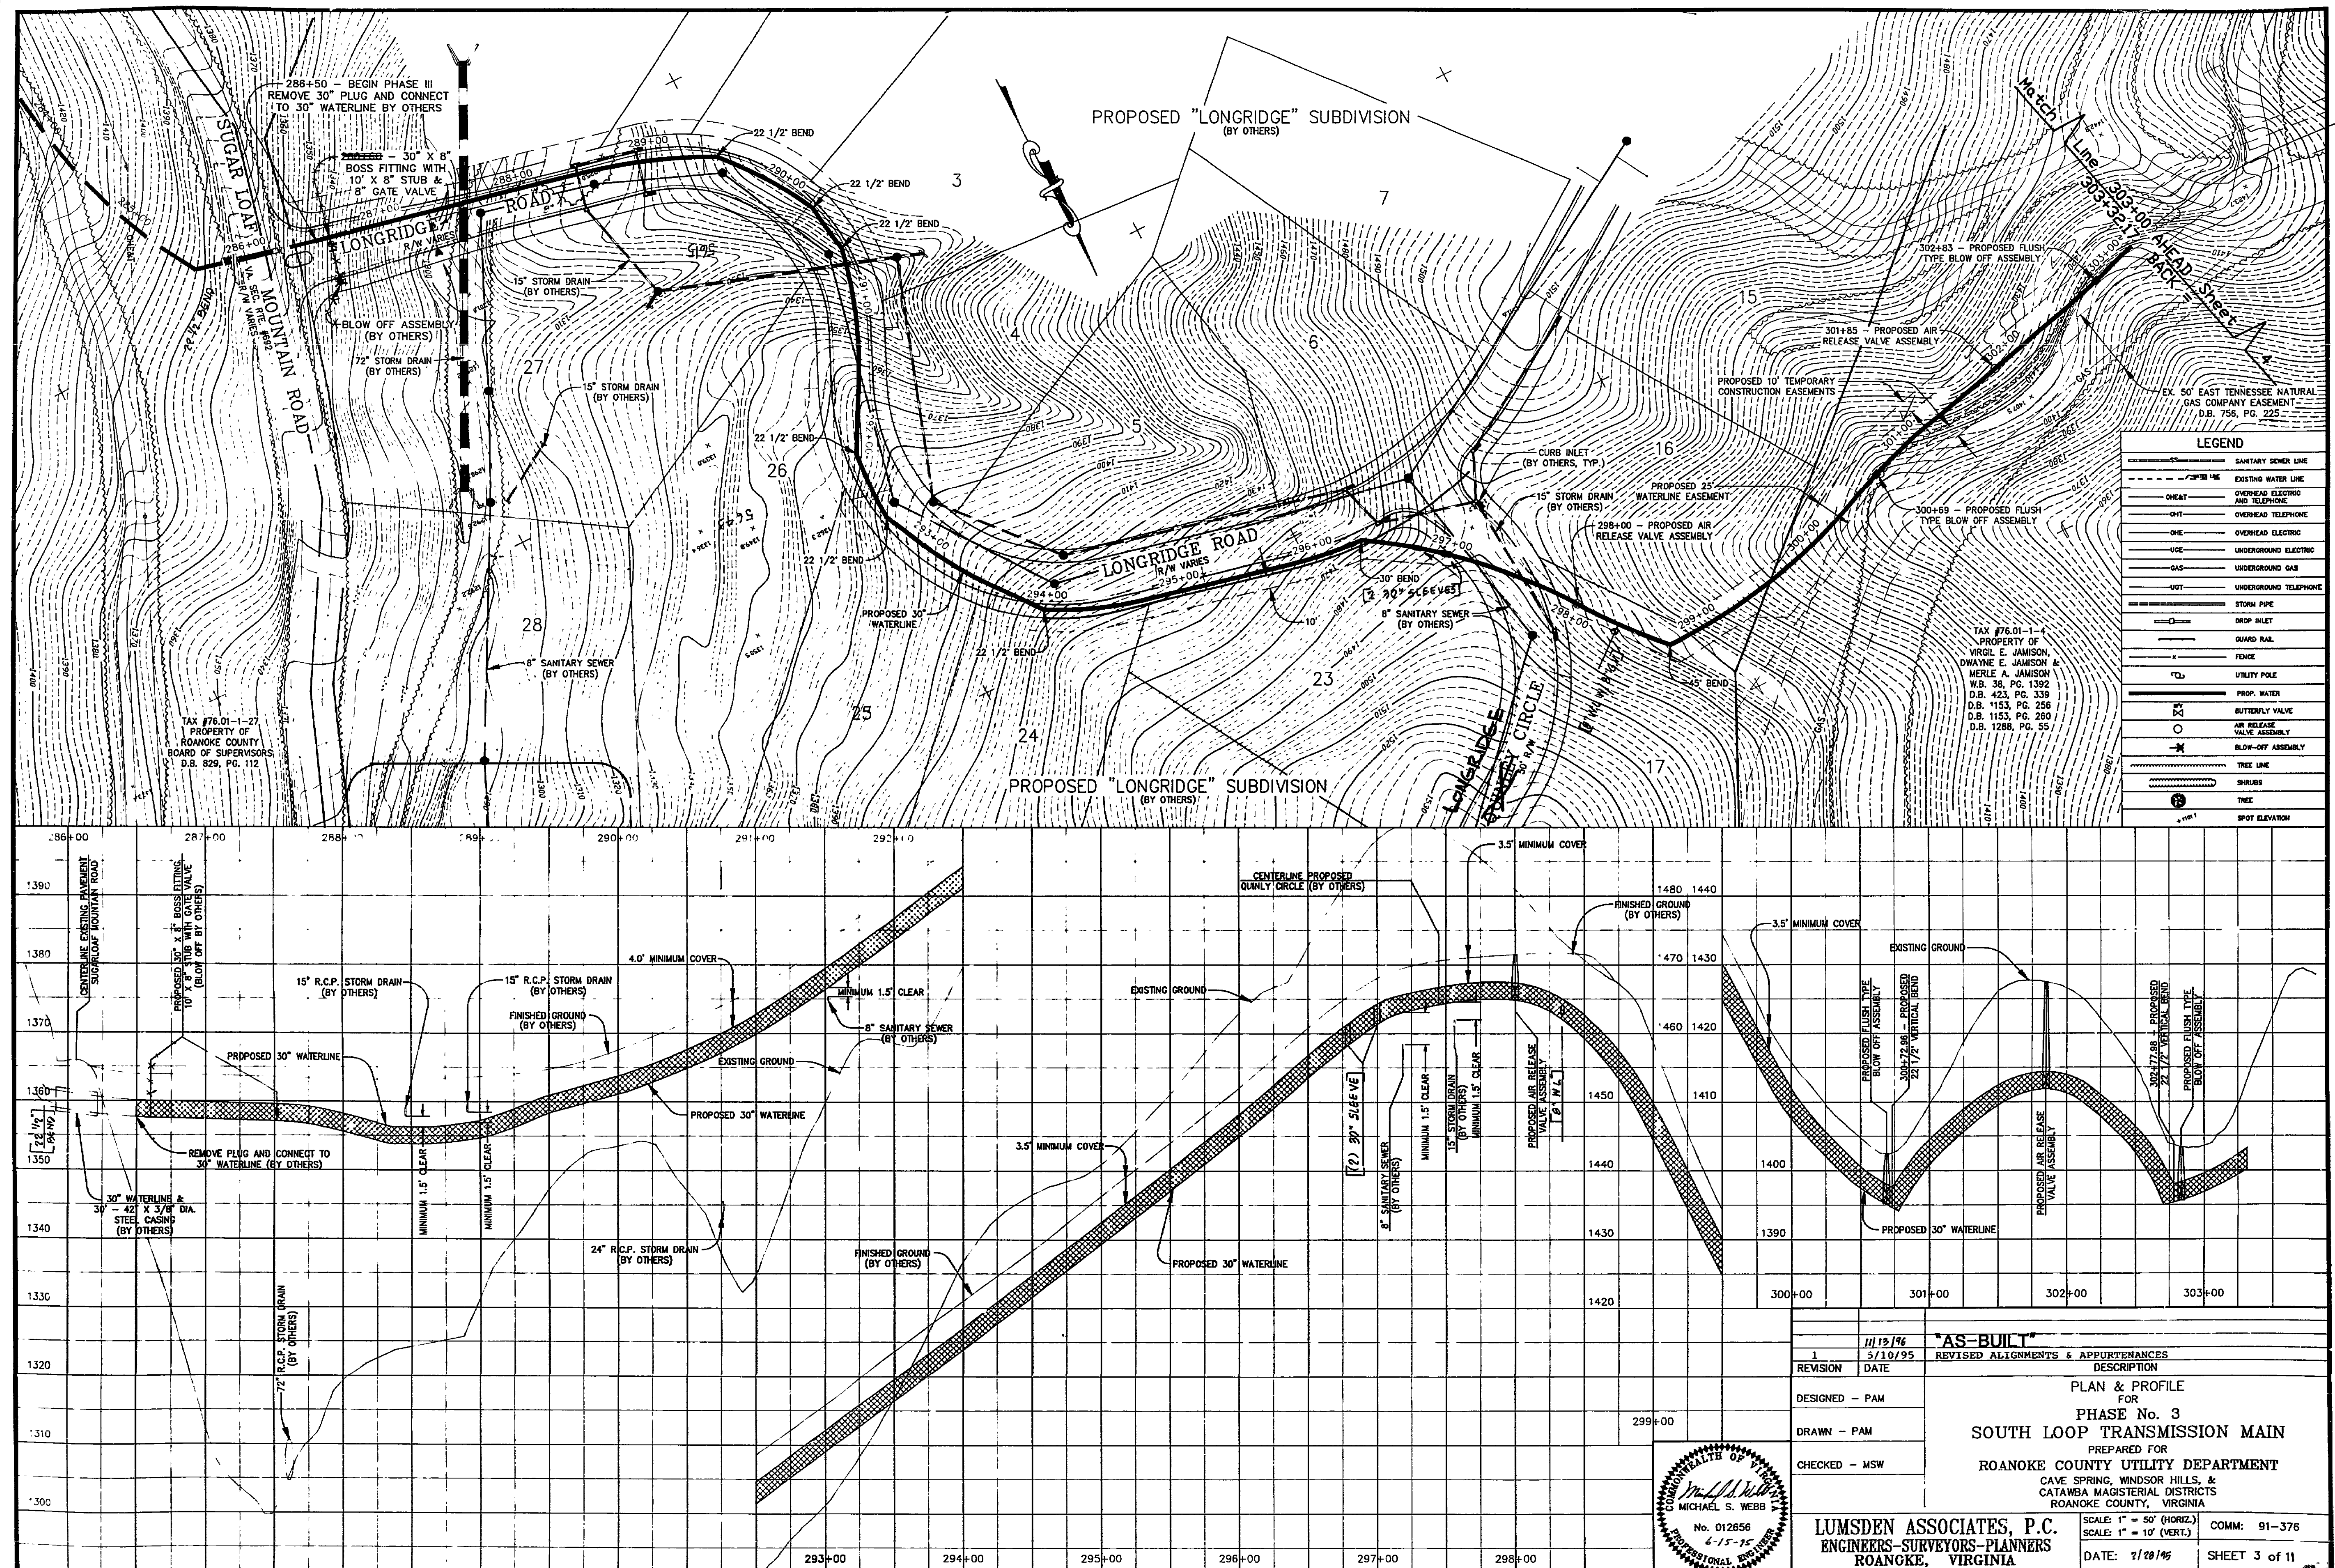

WT- 0488