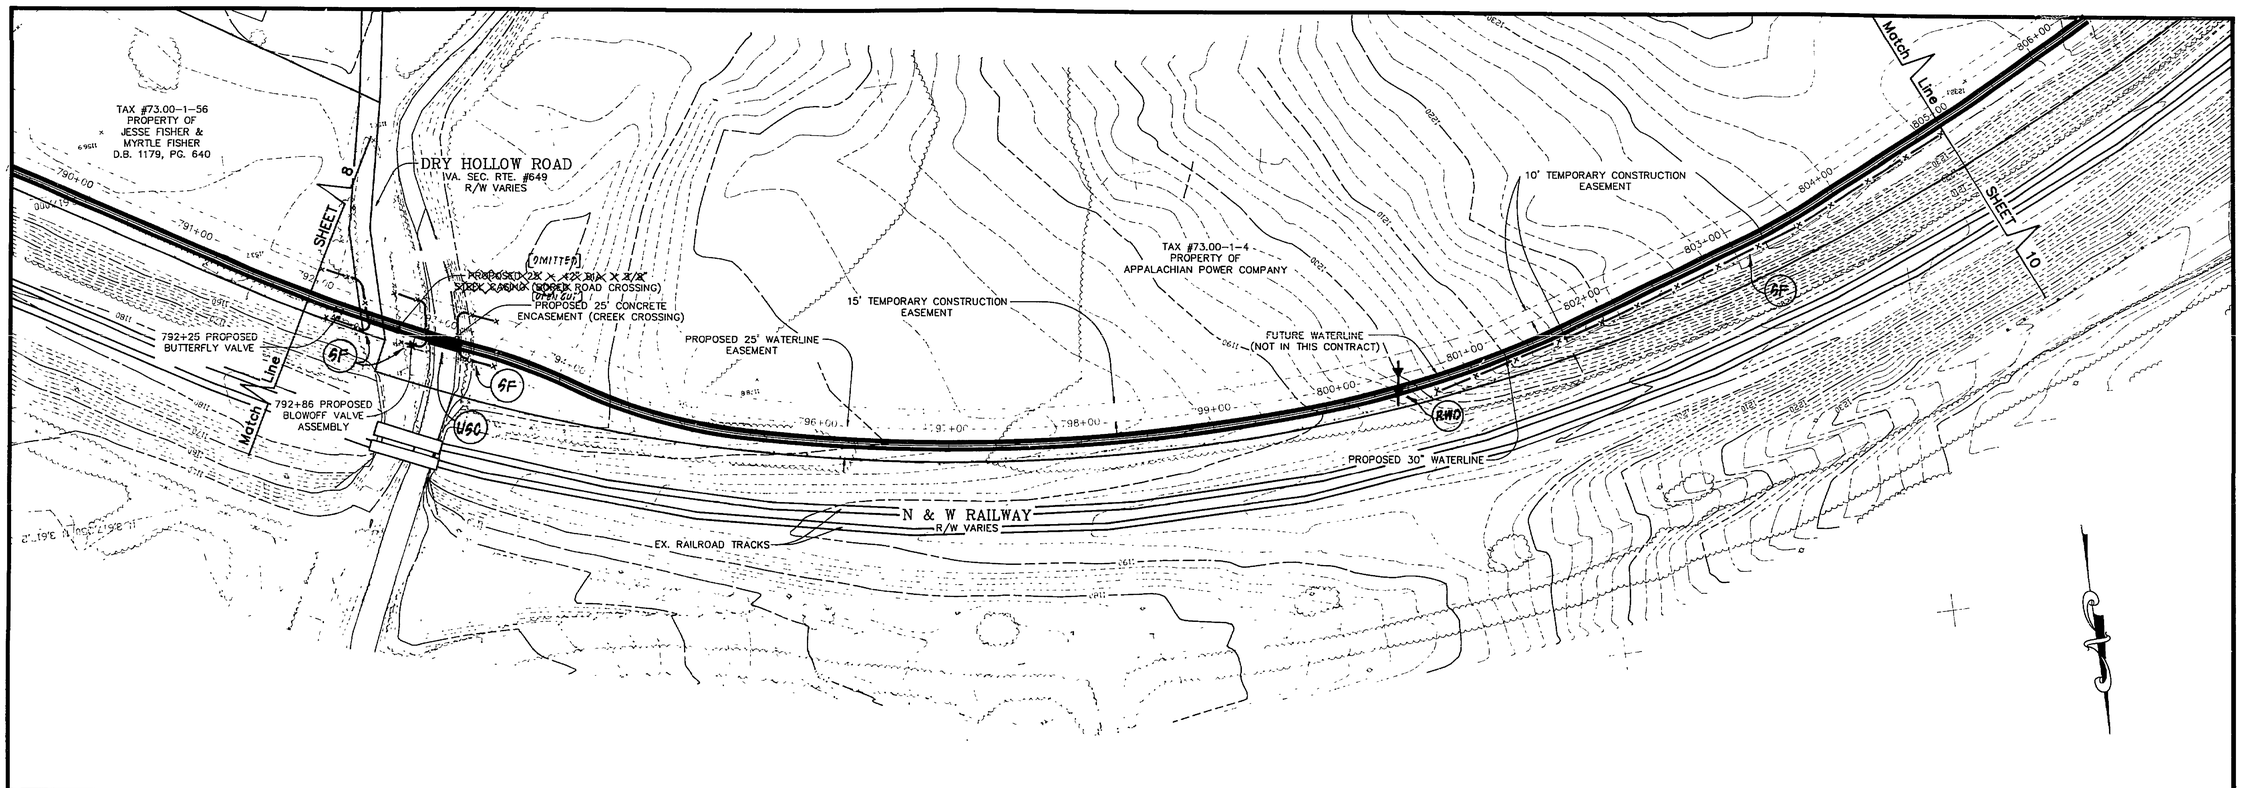

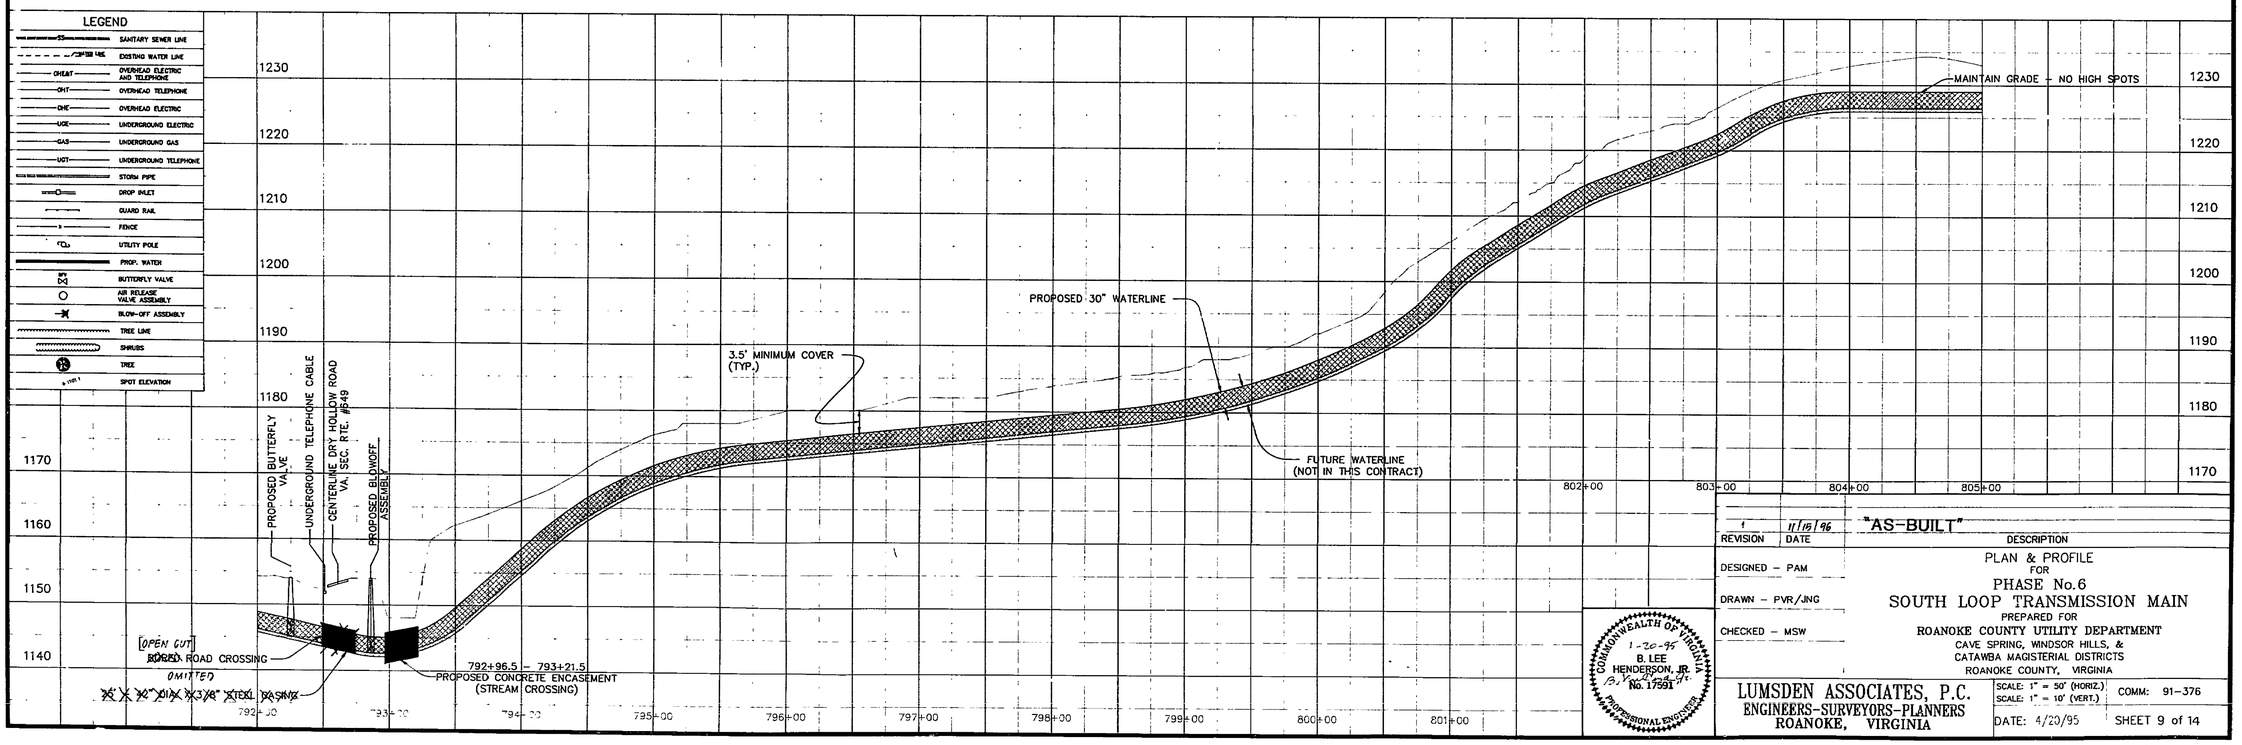

REVISION	DATE	DESCRIPTION
1	11/18/96	"AS-BUILT"

DESIGNED - PAM
DRAWN - PVR/JNG
CHECKED - MSW

COMMONWEALTH OF VIRGINIA
1-20-95
B. LEE HENDERSON, JR.
No. 17591
PROFESSIONAL ENGINEER

PLAN & PROFILE
FOR
PHASE No.6
SOUTH LOOP TRANSMISSION MAIN
PREPARED FOR
ROANOKE COUNTY UTILITY DEPARTMENT
CAVE SPRING, WINDSOR HILLS, &
CATAWBA MAGISTERIAL DISTRICTS
ROANOKE COUNTY, VIRGINIA

LUMSDEN ASSOCIATES, P.C.
ENGINEERS-SURVEYORS-PLANNERS
ROANOKE, VIRGINIA

SCALE: 1" = 50' (HORIZ.)
SCALE: 1" = 10' (VERT.)
COMM: 91-376
DATE: 4/20/95
SHEET 9 of 14

WT-0536